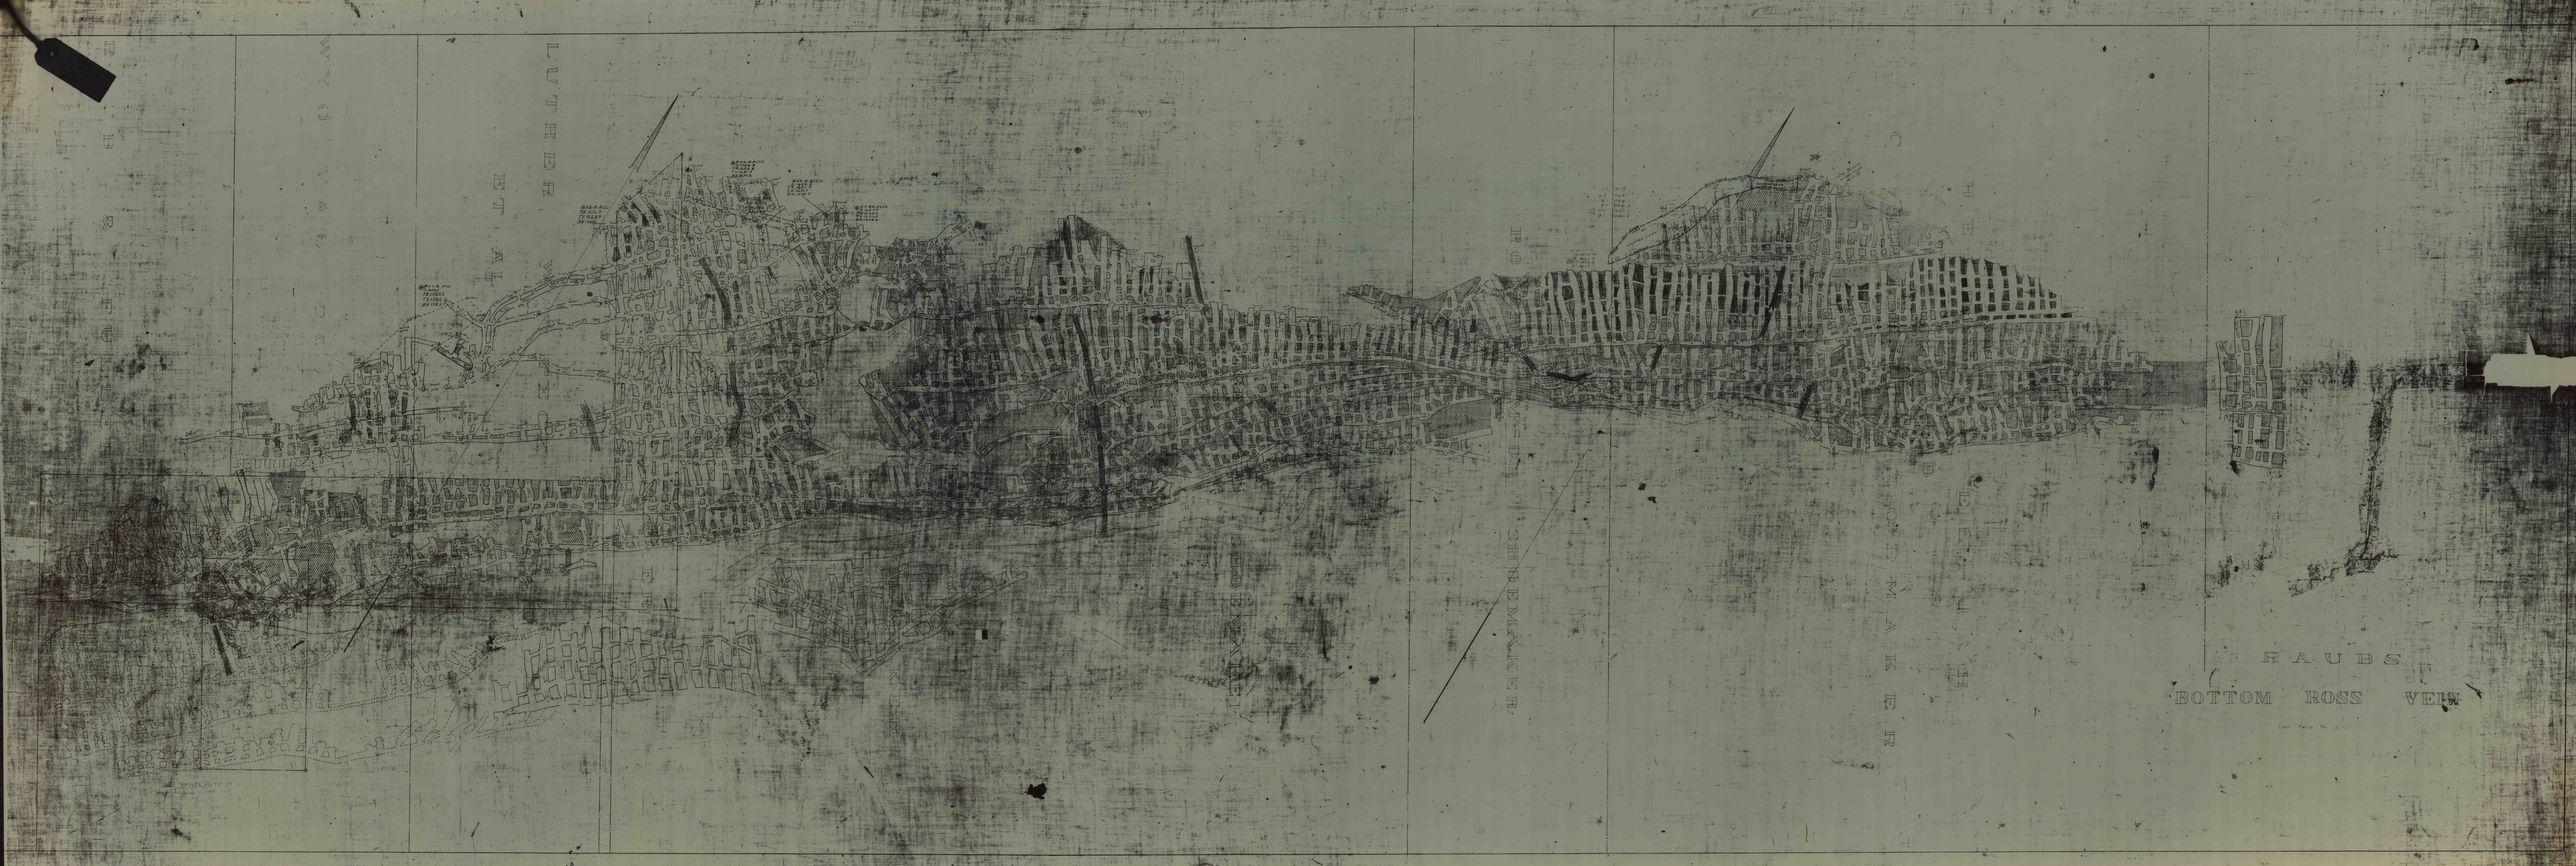

FLETCHER
SHOEMAKER
RAUBS
BOTTOM ROSS VEIN