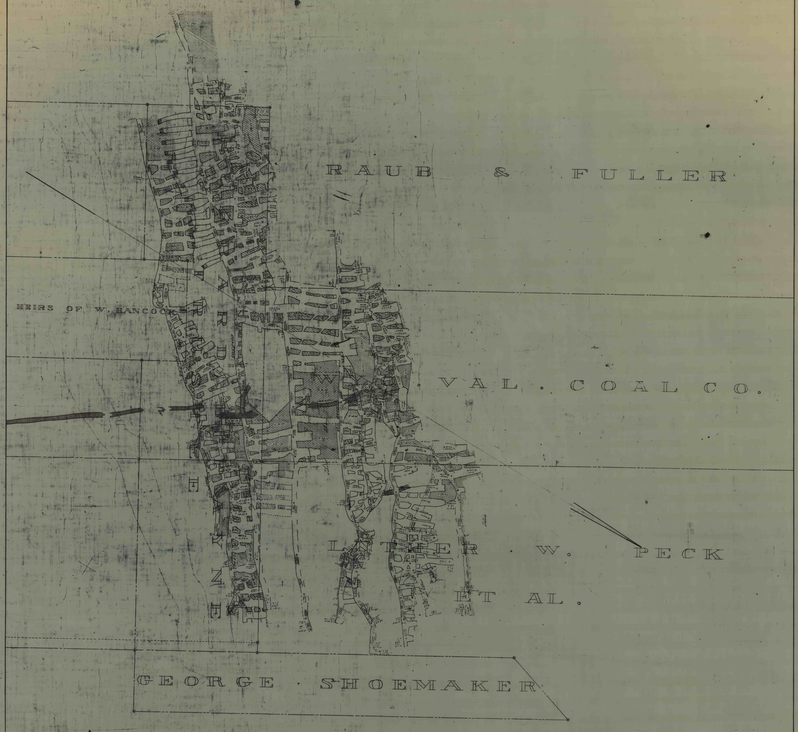

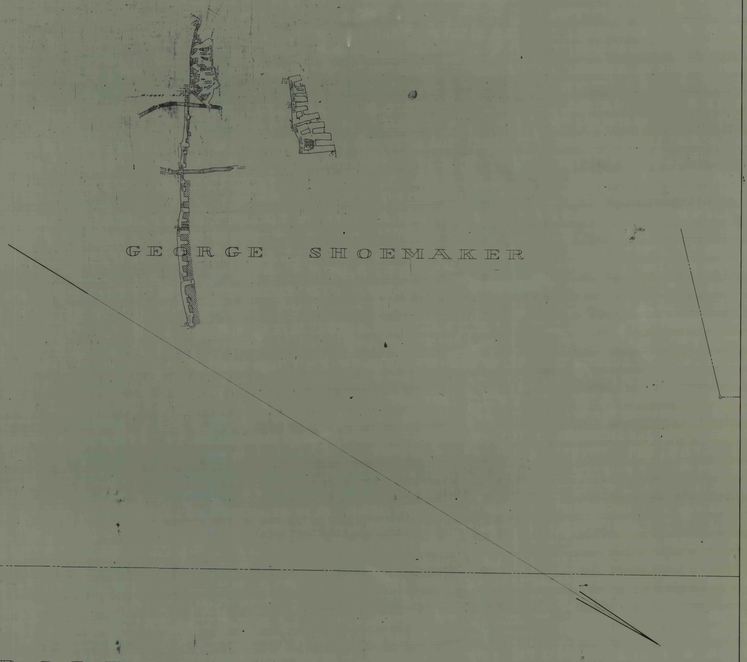

ROBERT MACD. SHOEMAKER

HEIRS OF ELIJAH
AND
CHARLES SHOEMAKER