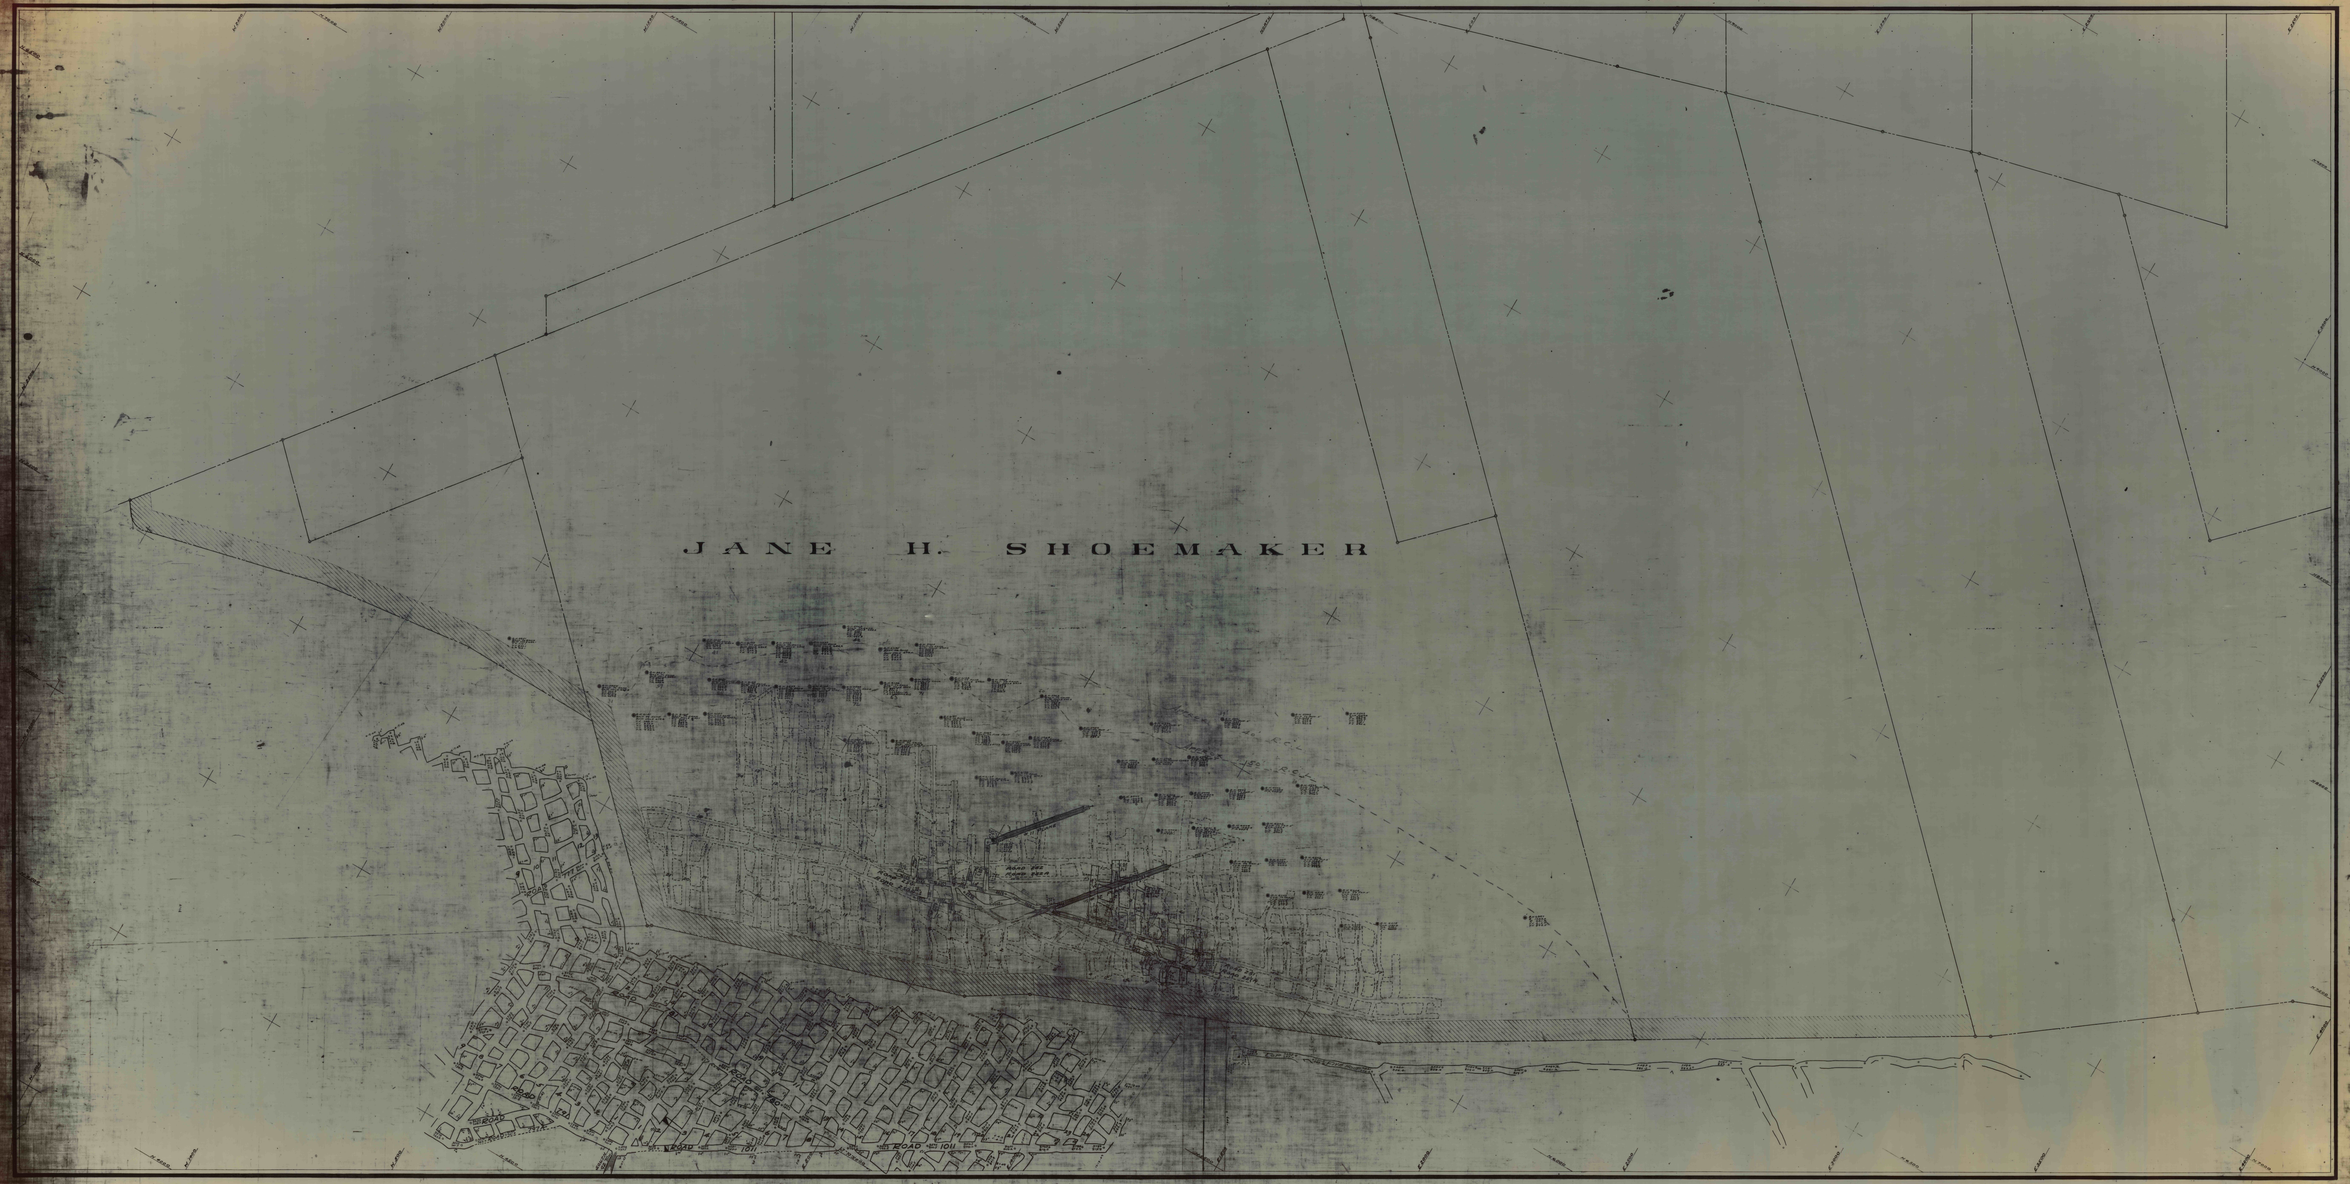
JANE H. SHOEMAKER
ROAD 101
ROAD 101