


L. M. Y E R S E S T A T E

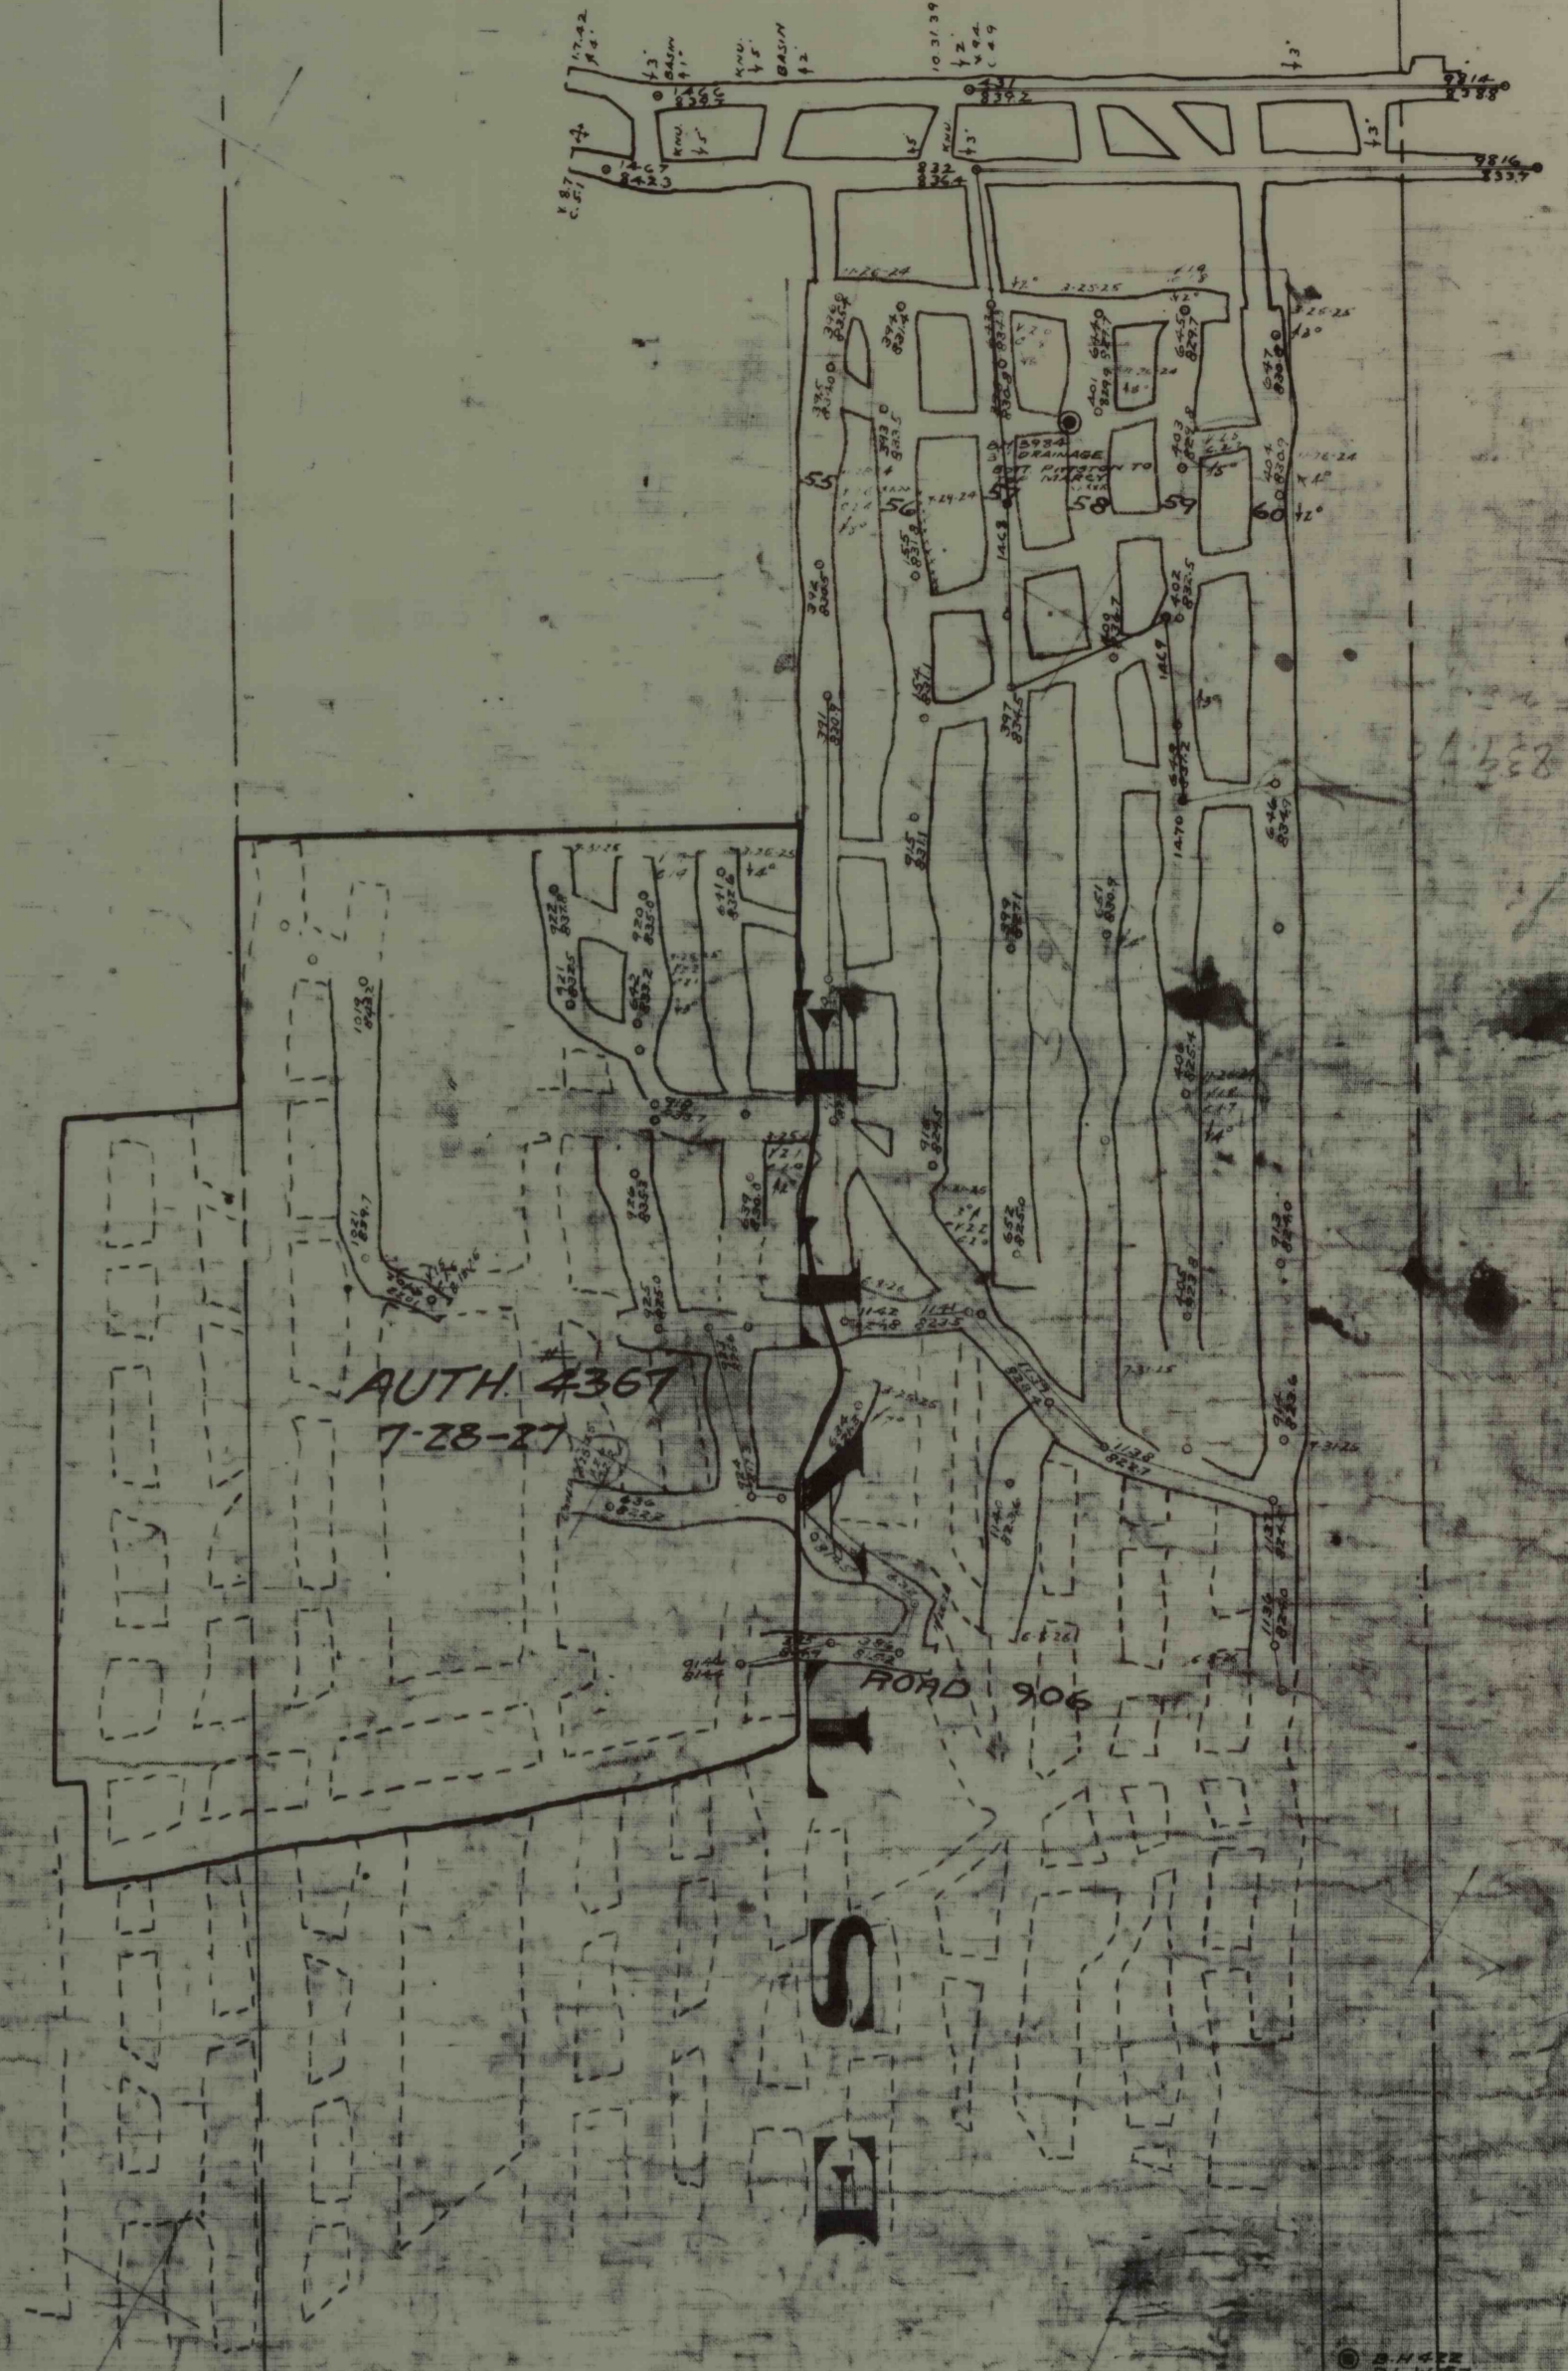

NO MINING RIGHTS

H U N T

