


FORTY FORT COLLIERY

SEARLE & STARBUCK


J. P. ATHERTON

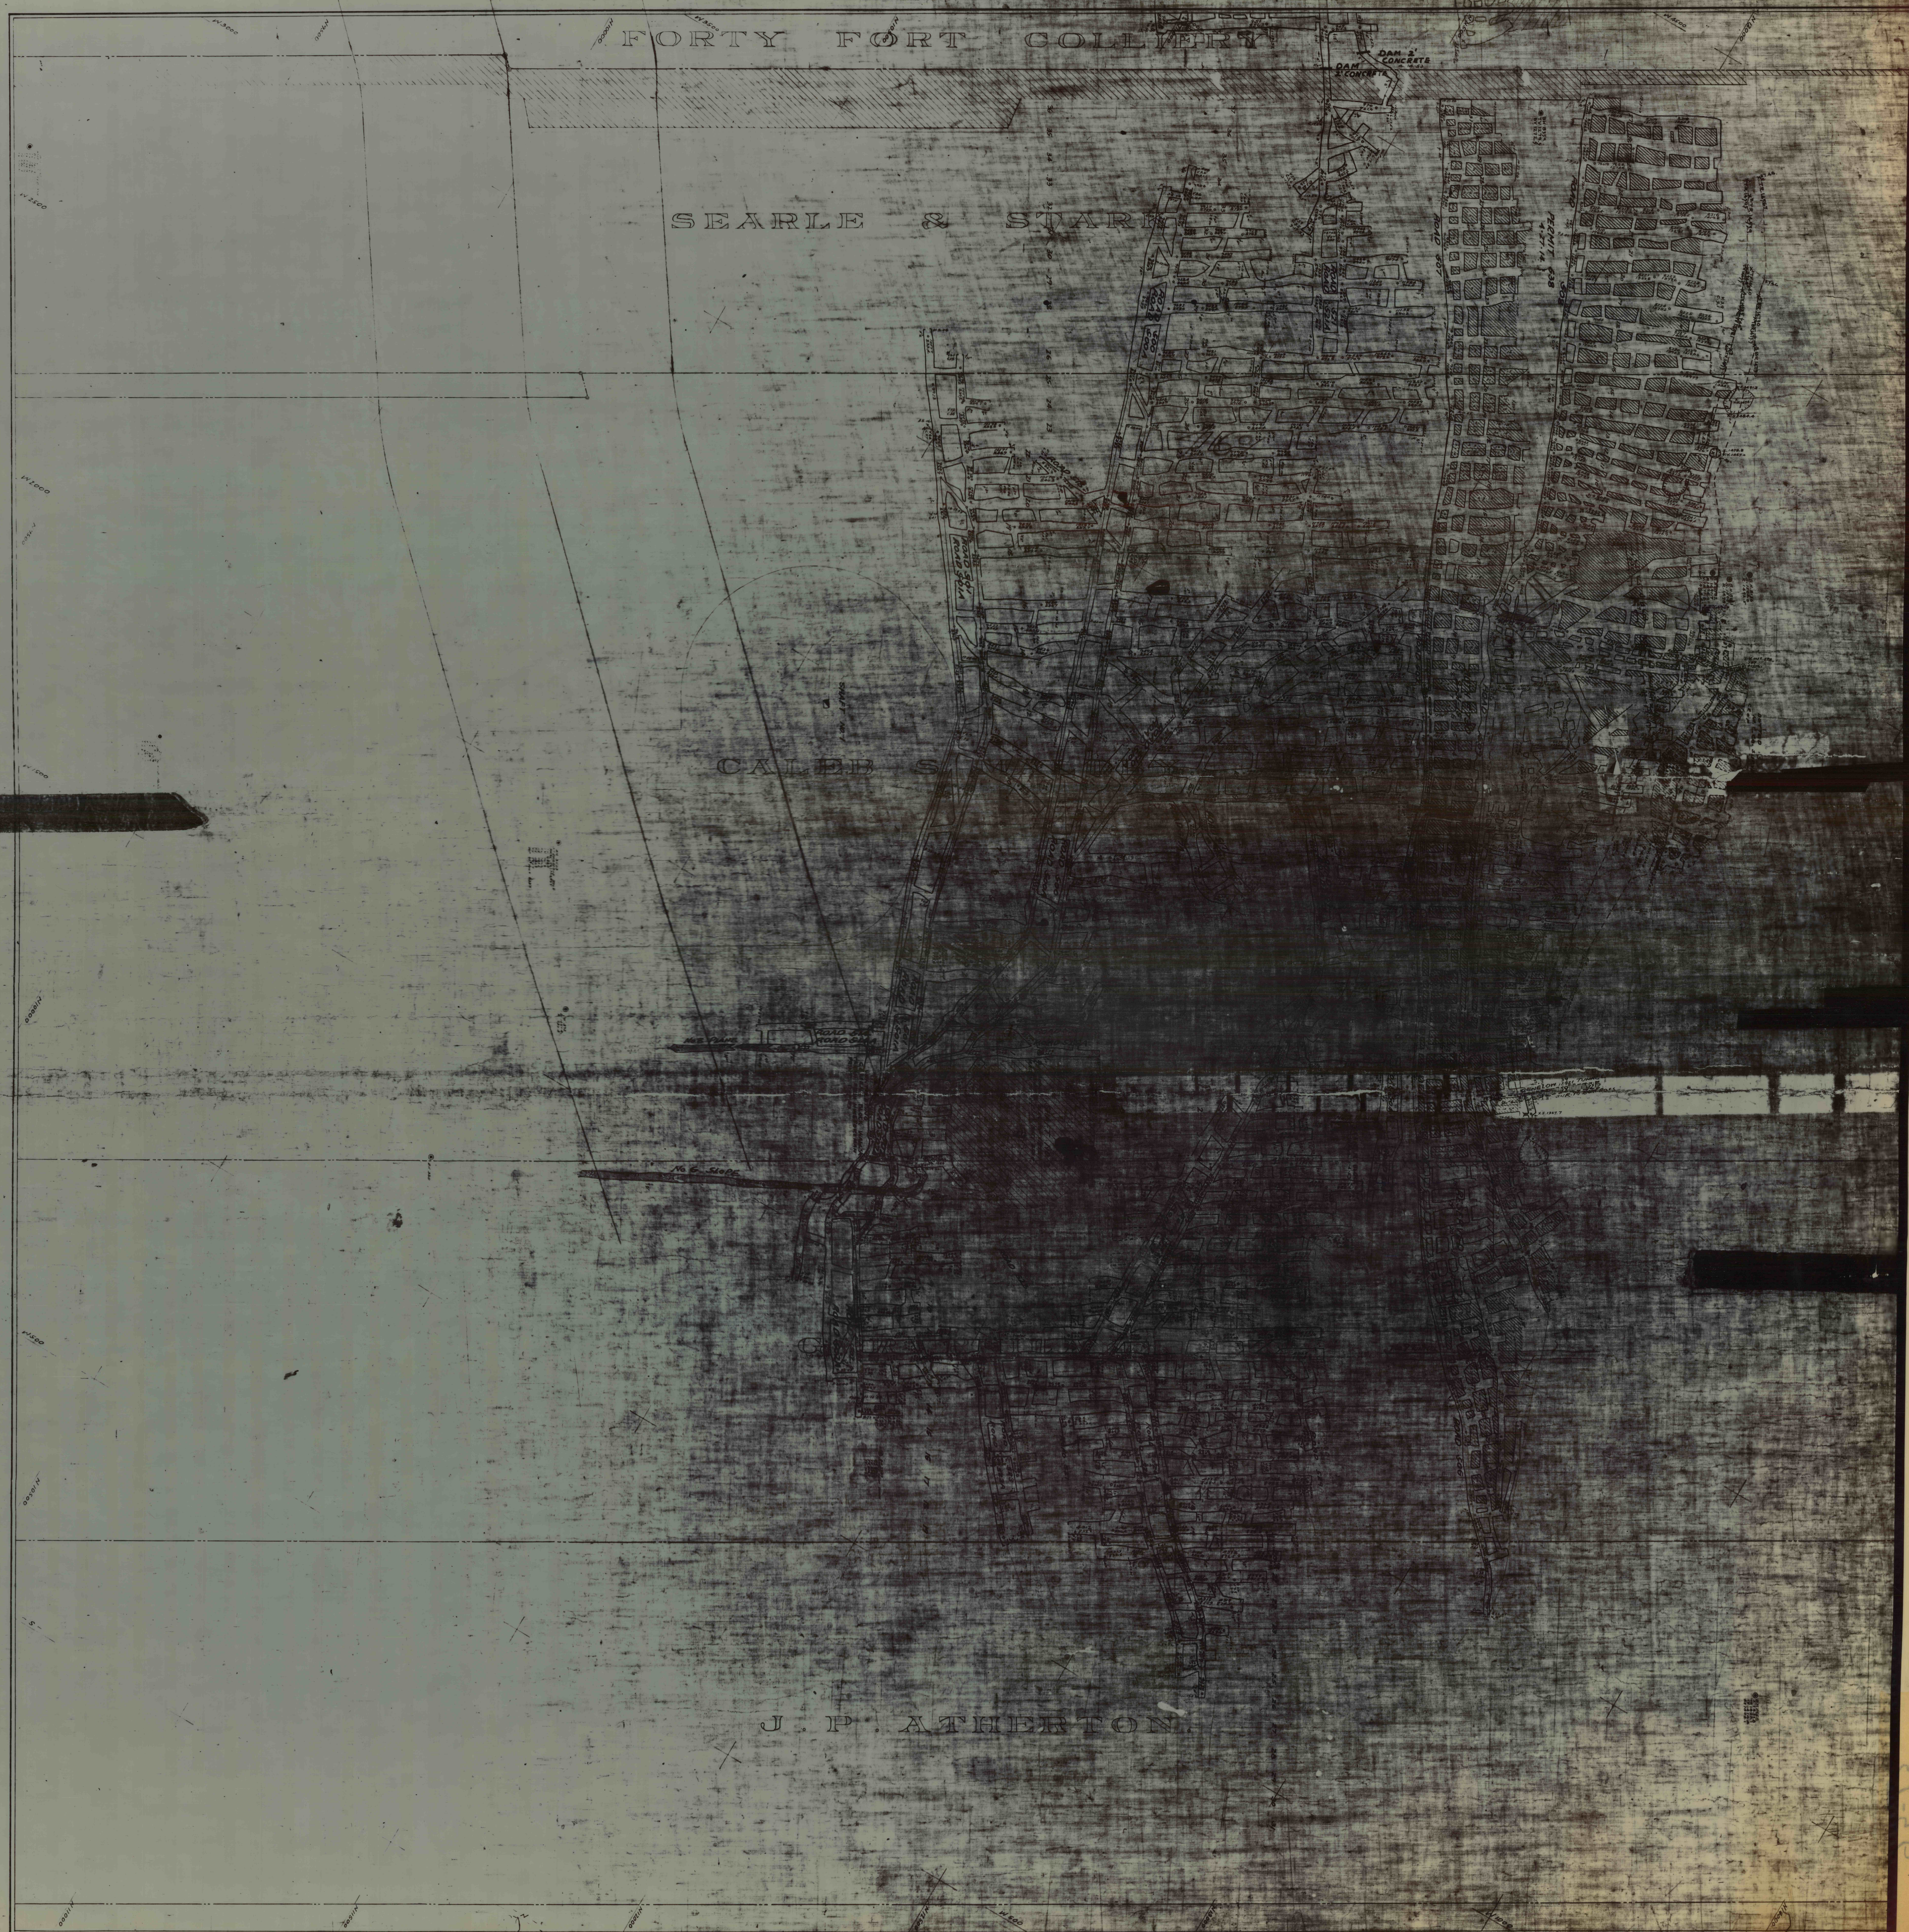

24-18

004

MYTLEBURY

2510