

22-14



FORTY EIGHT

DANIEL SEARLE & JOHN M. STARK

C. S. MANTON

G. R. REILAY

JAS. P. ATHERTON

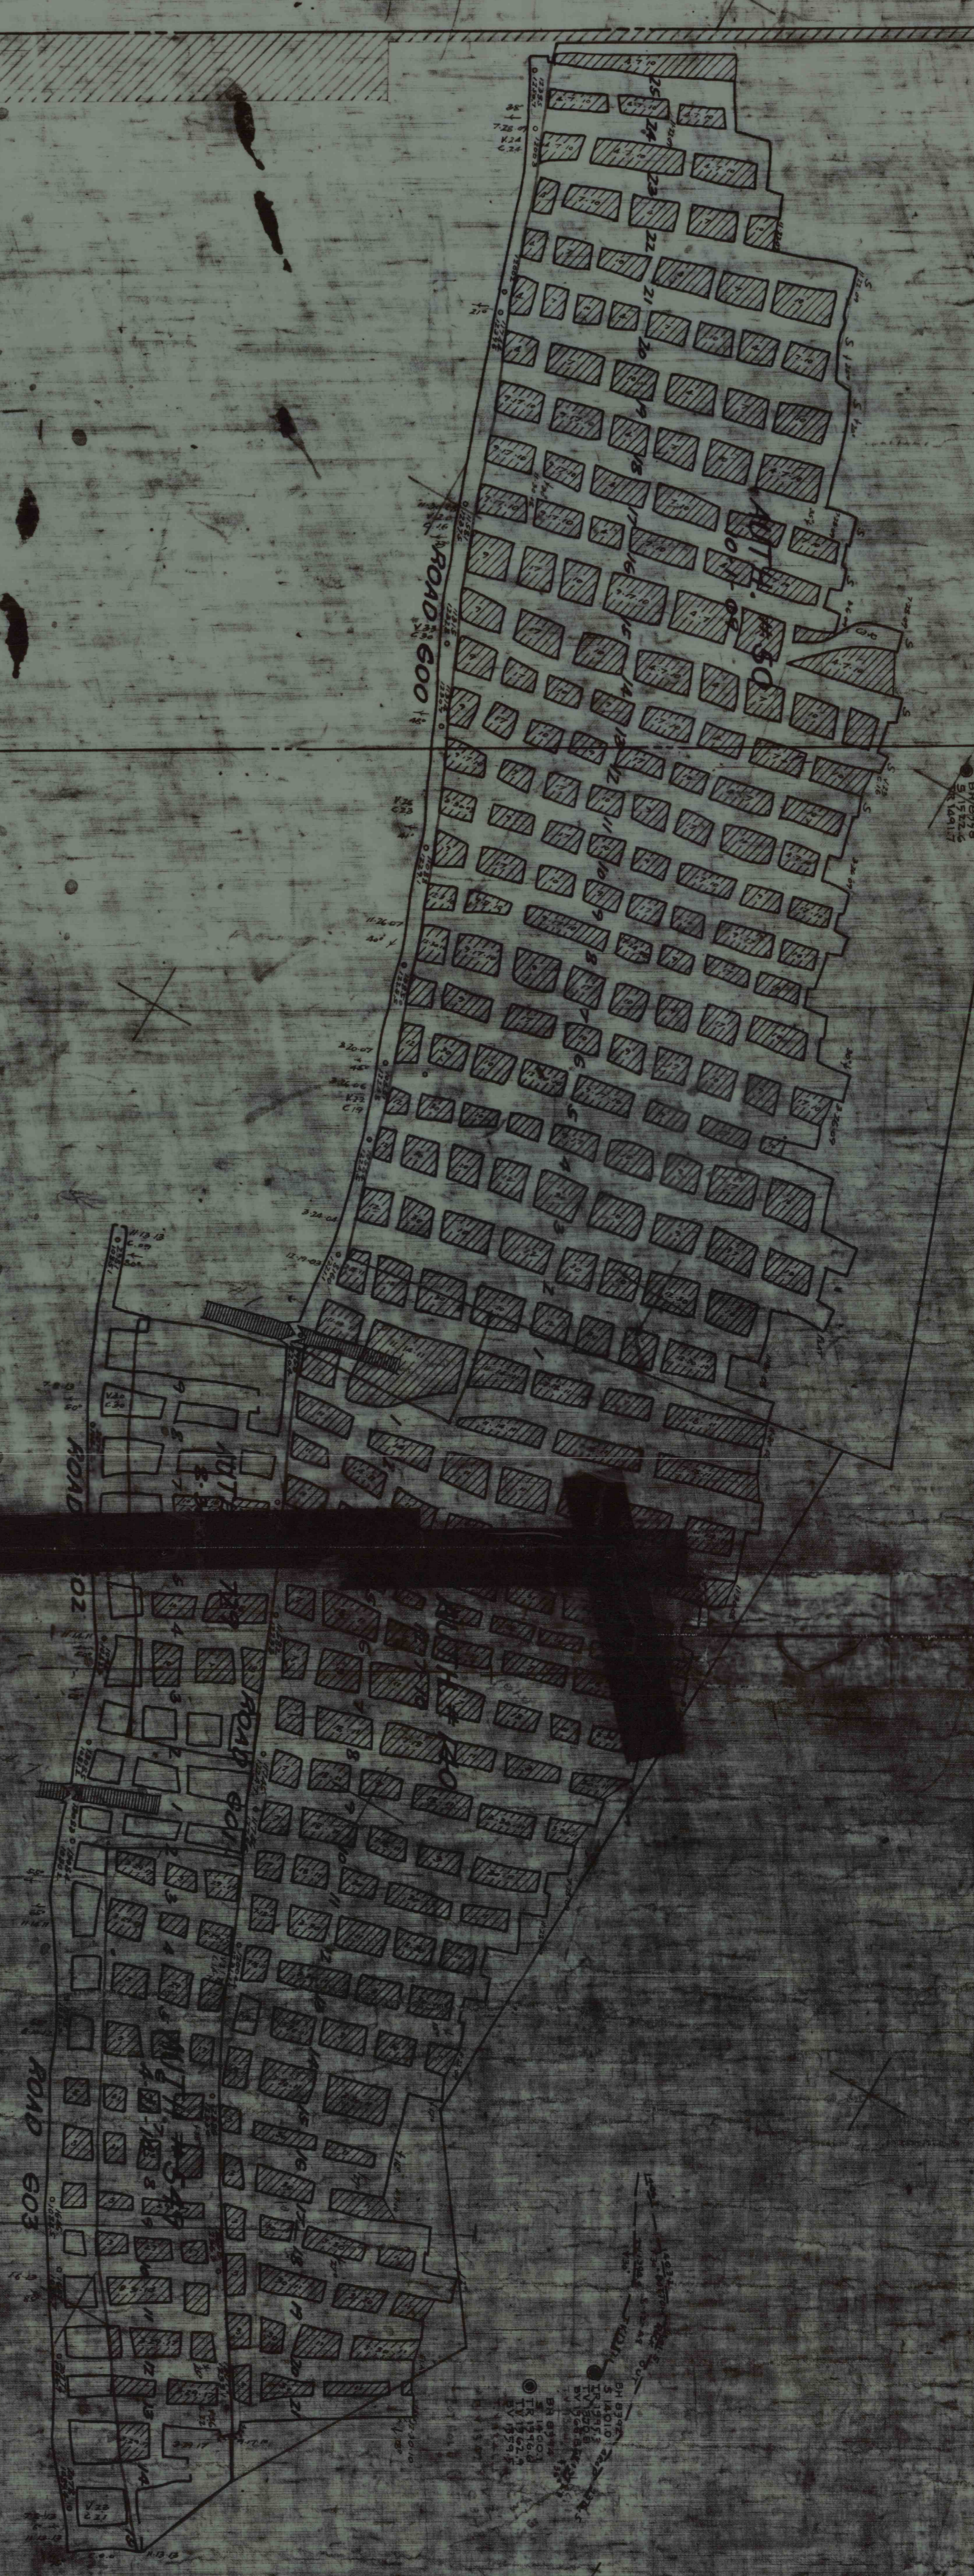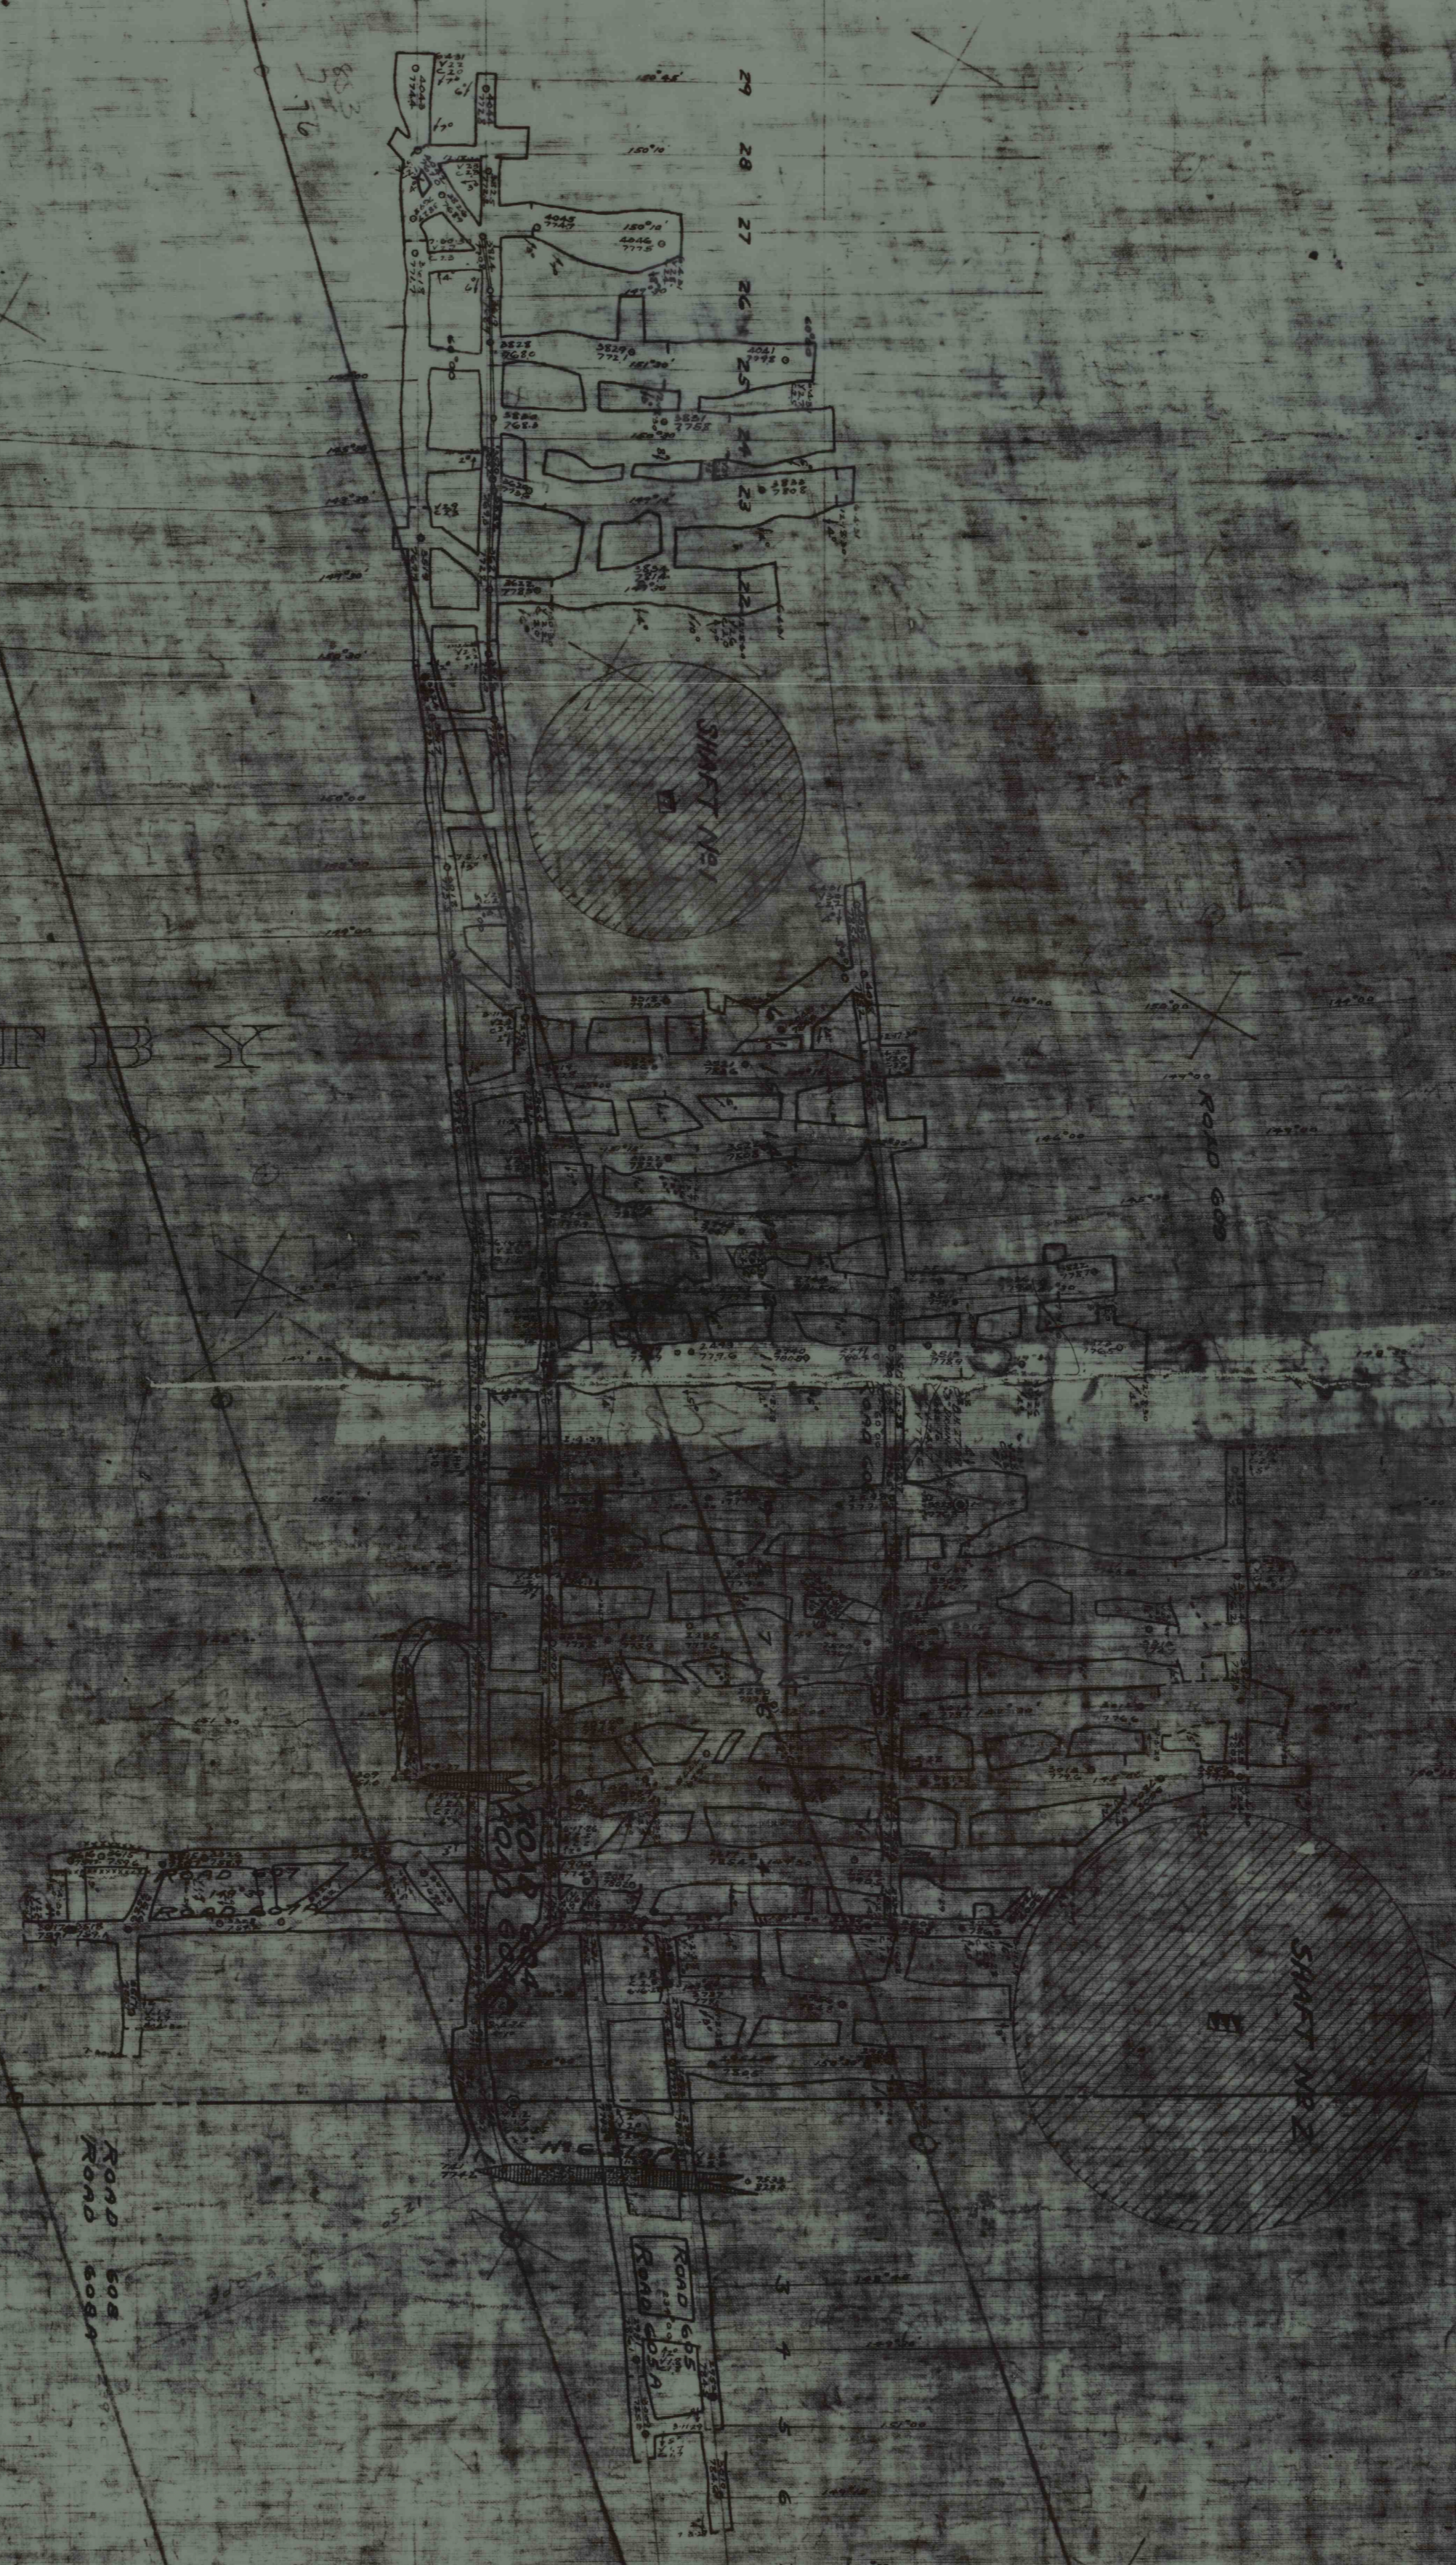

REAR VIEW

2209 907

19