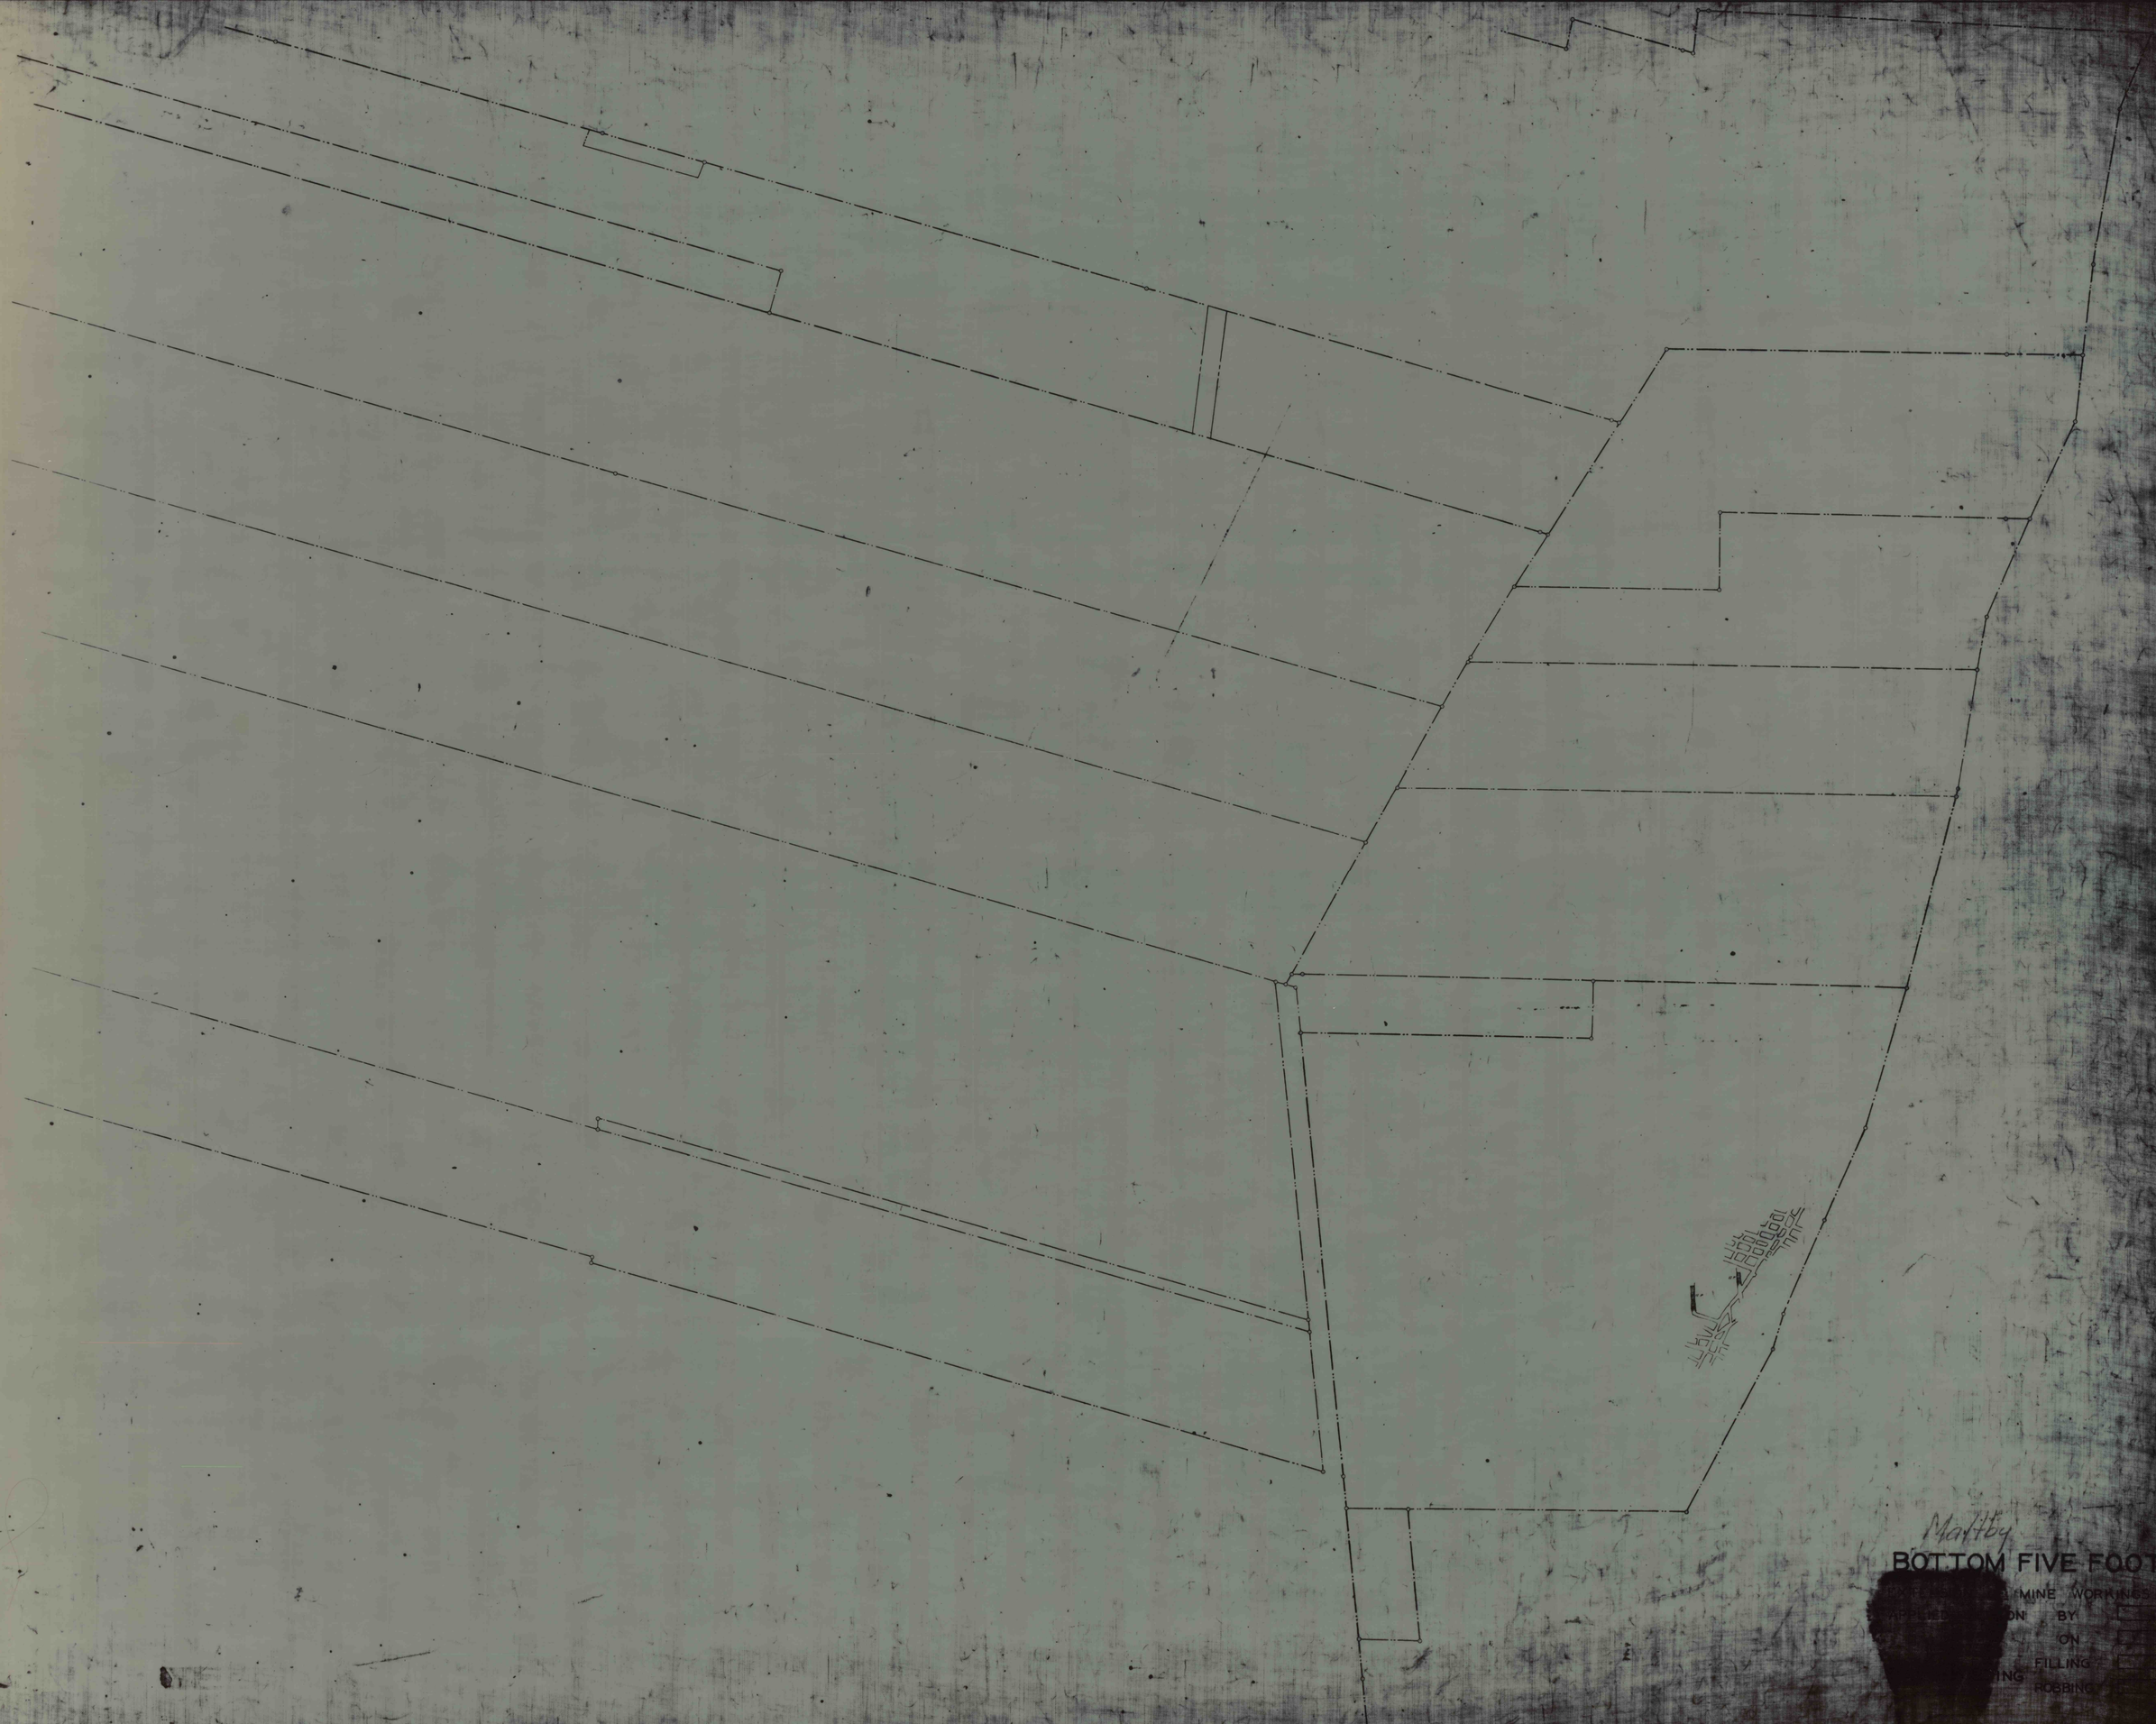
Marthy
BOTTOM FIVE FOOT
MINE WORKINGS
ON BY
ON
FILLING
ROBBING