


GENERAL BOTTOM RED ASH
BOTTOM REDS of GLEN LYON BUSQ N°6

GLEN LYON
WANAMIE

O-H

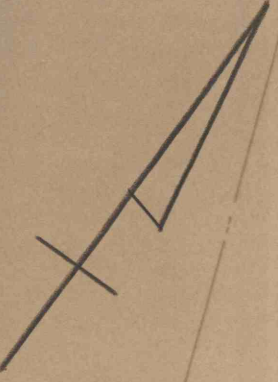

SAFETY ZONE

SAFETY ZONE

SAFETY ZONE

PROPERTY
P-2332

P-2337

GLEN LYON
WANAMIE

WATER

ABANDONED
BY AUTH. 18486

BOTTOM RED ASH
1"=200'