




CROSS SECTION NO. 1

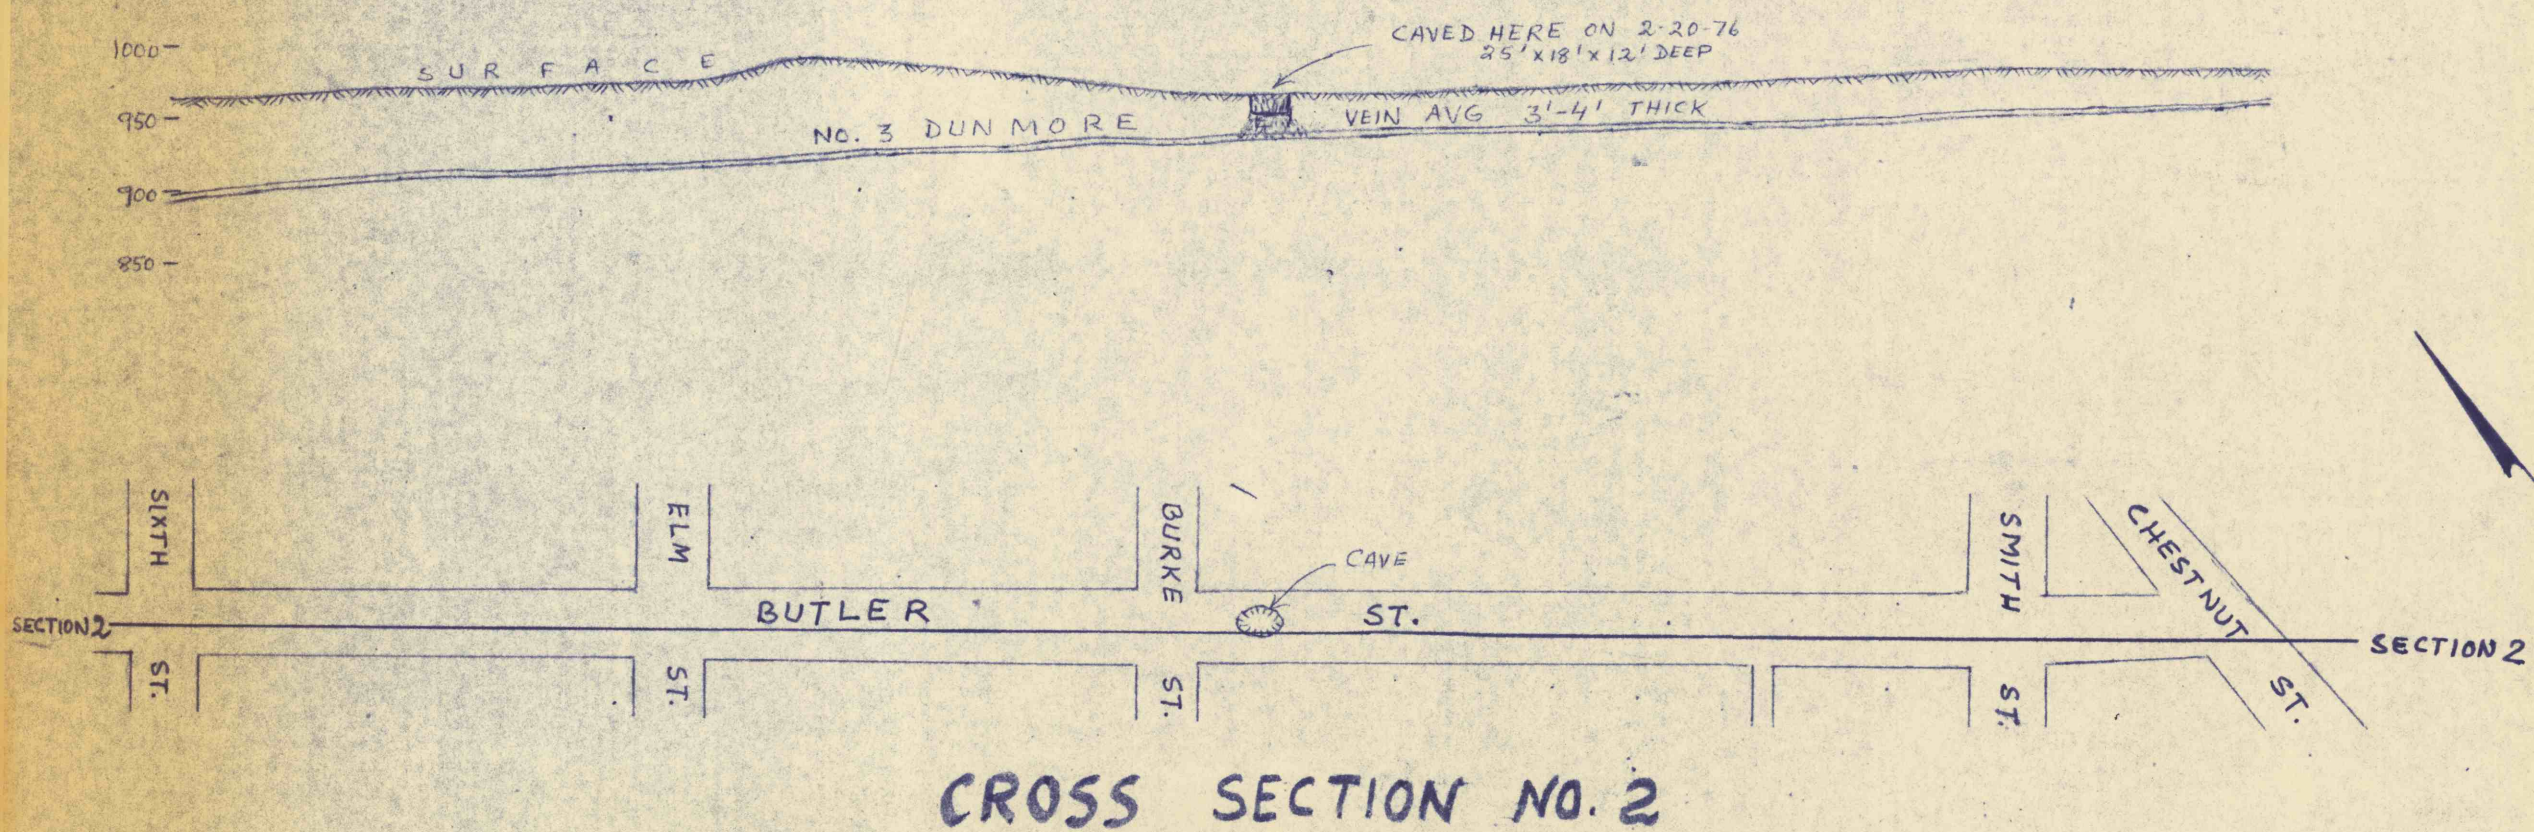

CROSS SECTION NO. 2

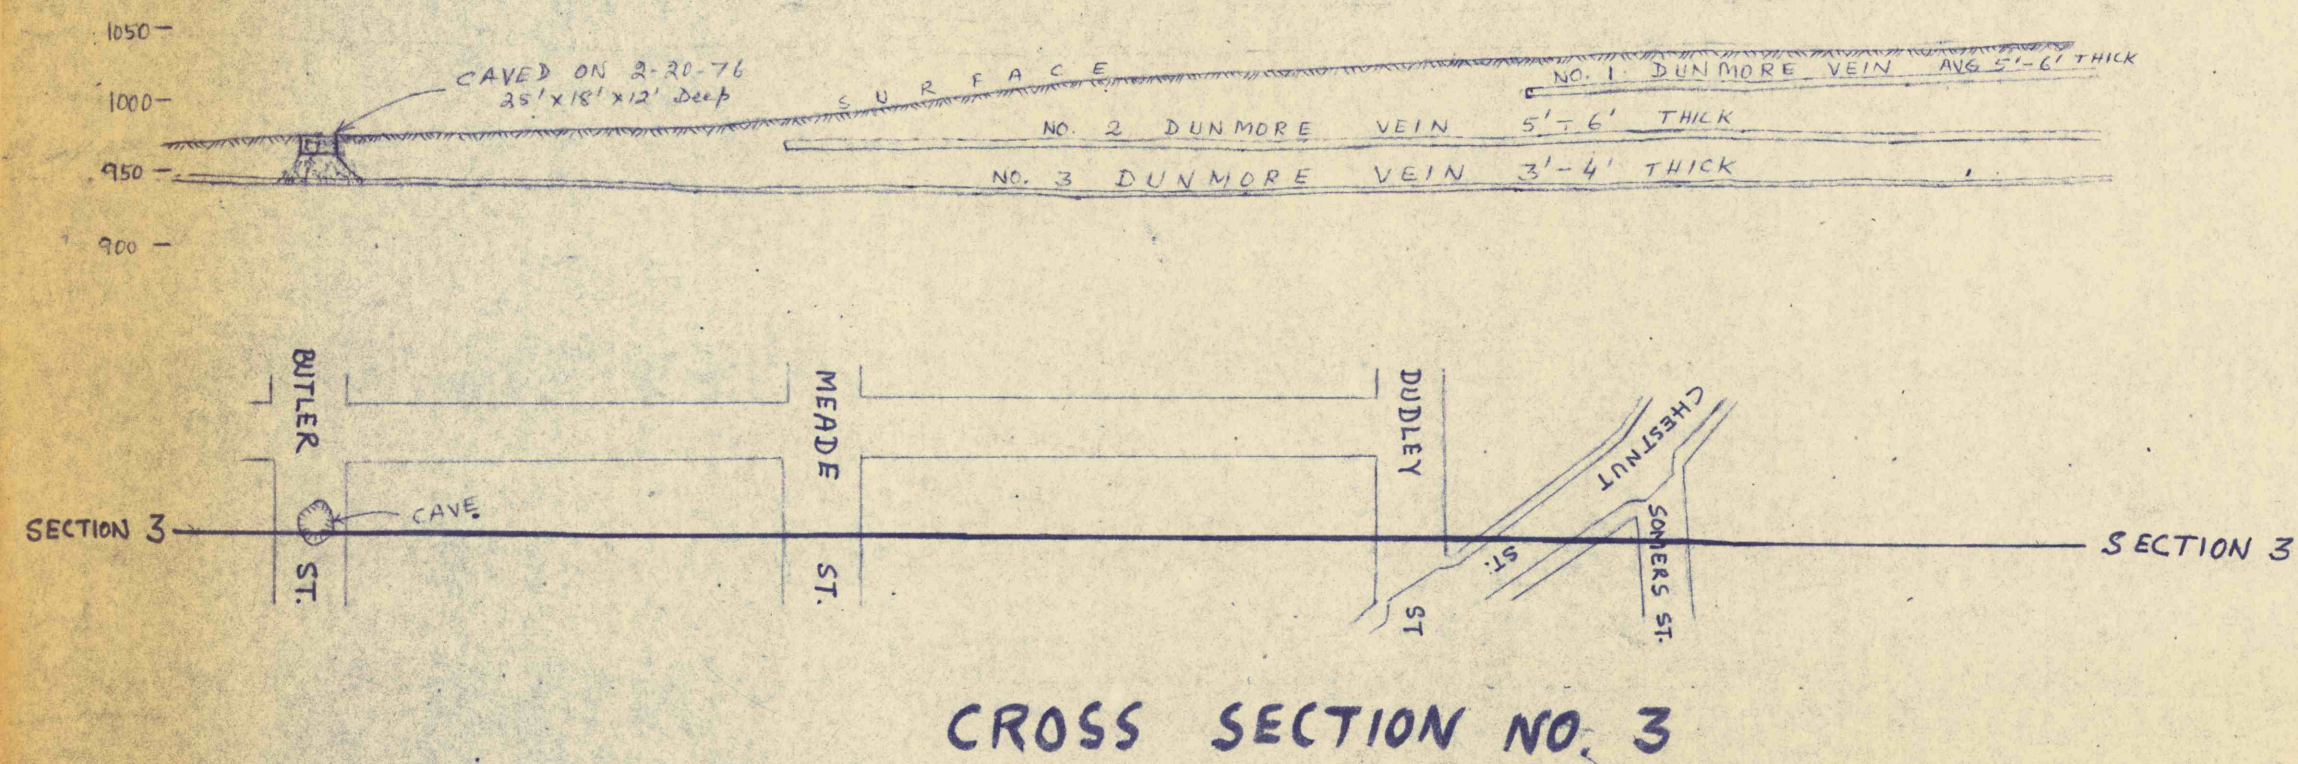

CROSS SECTION NO. 3

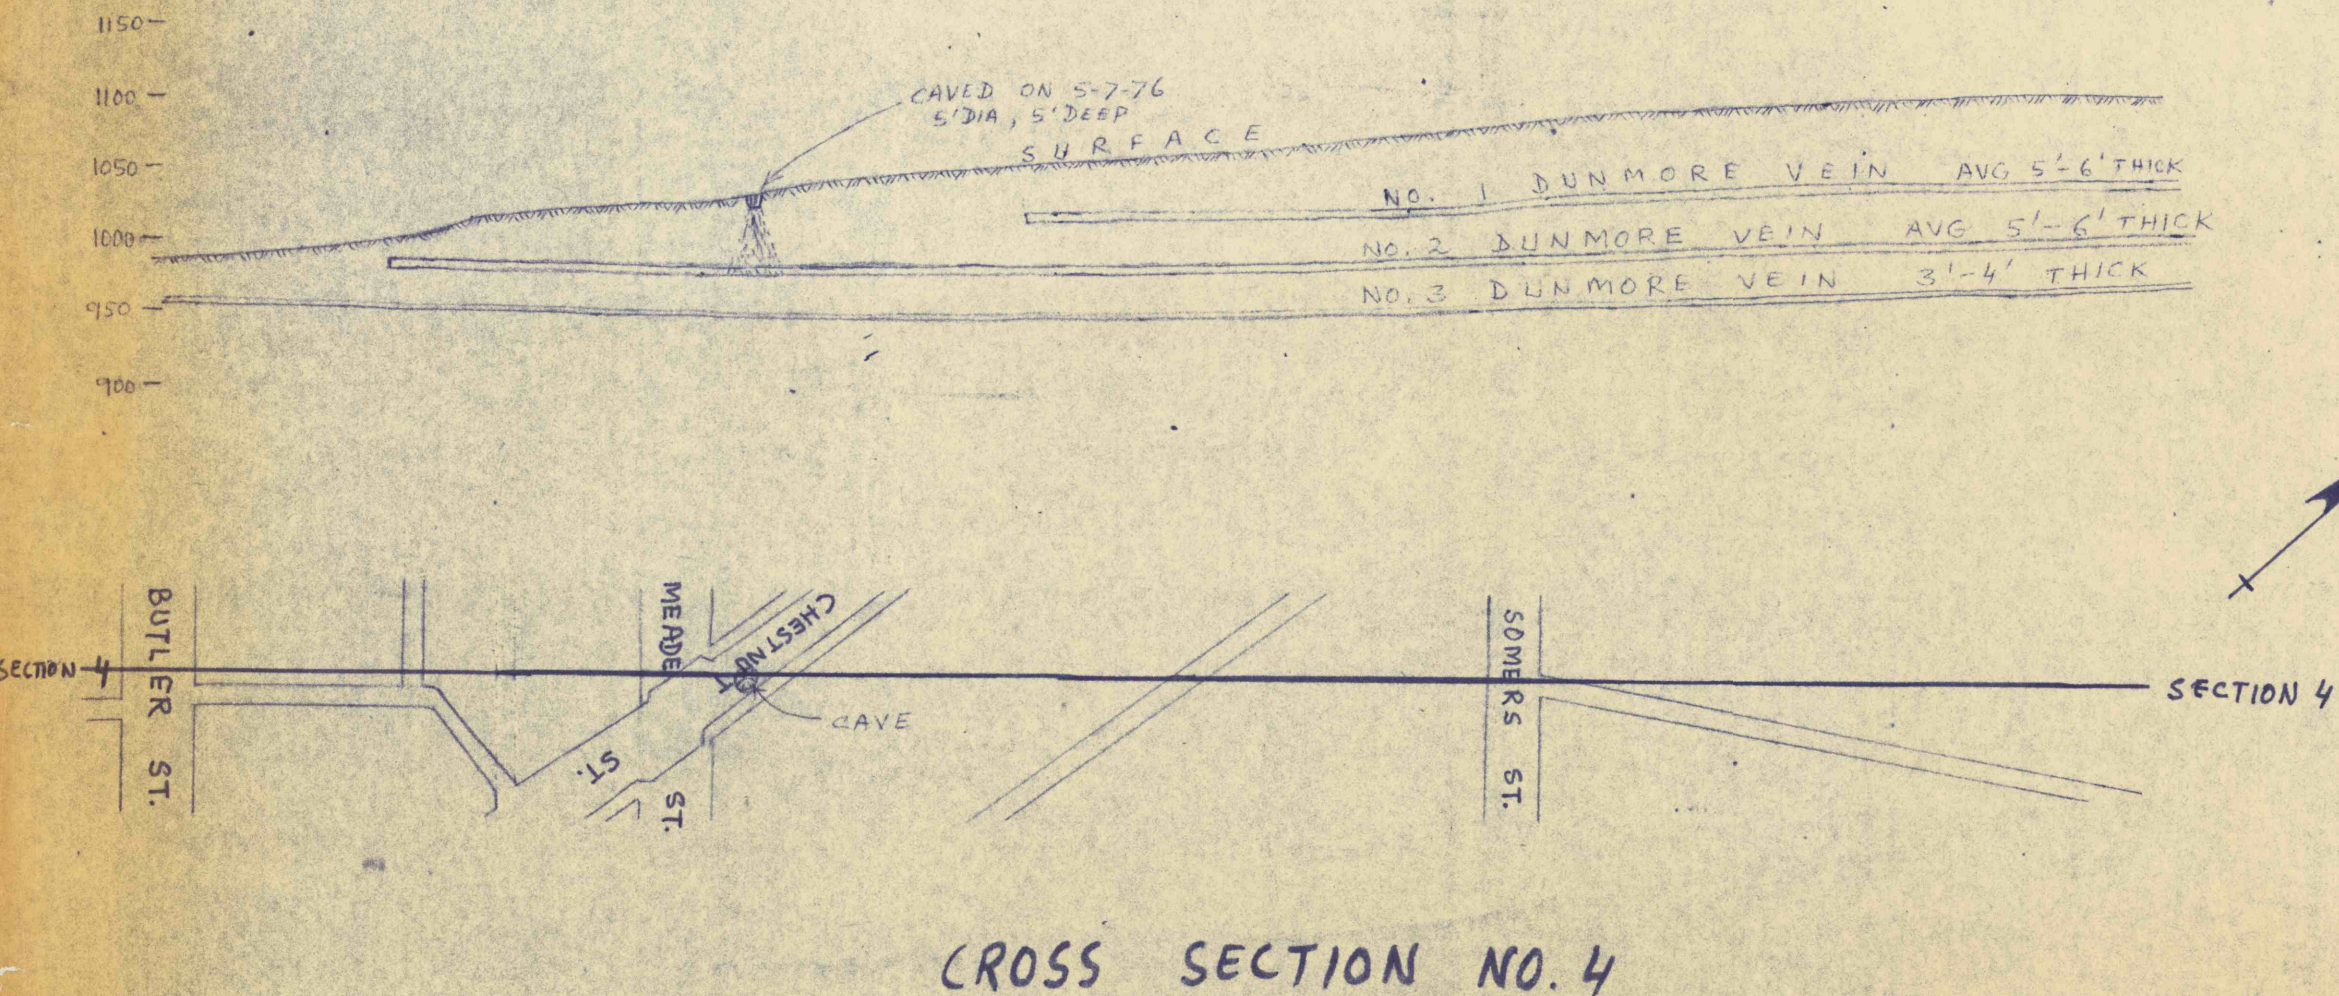

CROSS SECTION NO. 4

PART OF NO. 5 COLLIERY  
 PENNA COAL CO.  
 SHOWING DUNMORE NO. 1, 2, & 3, VEINS  
 AND PLACES WHERE SUBSIDENCE  
 OCCURRED.

SCALE: VERT. & HORIZ - 1" = 100'