


SLIDE 5-2
8-2

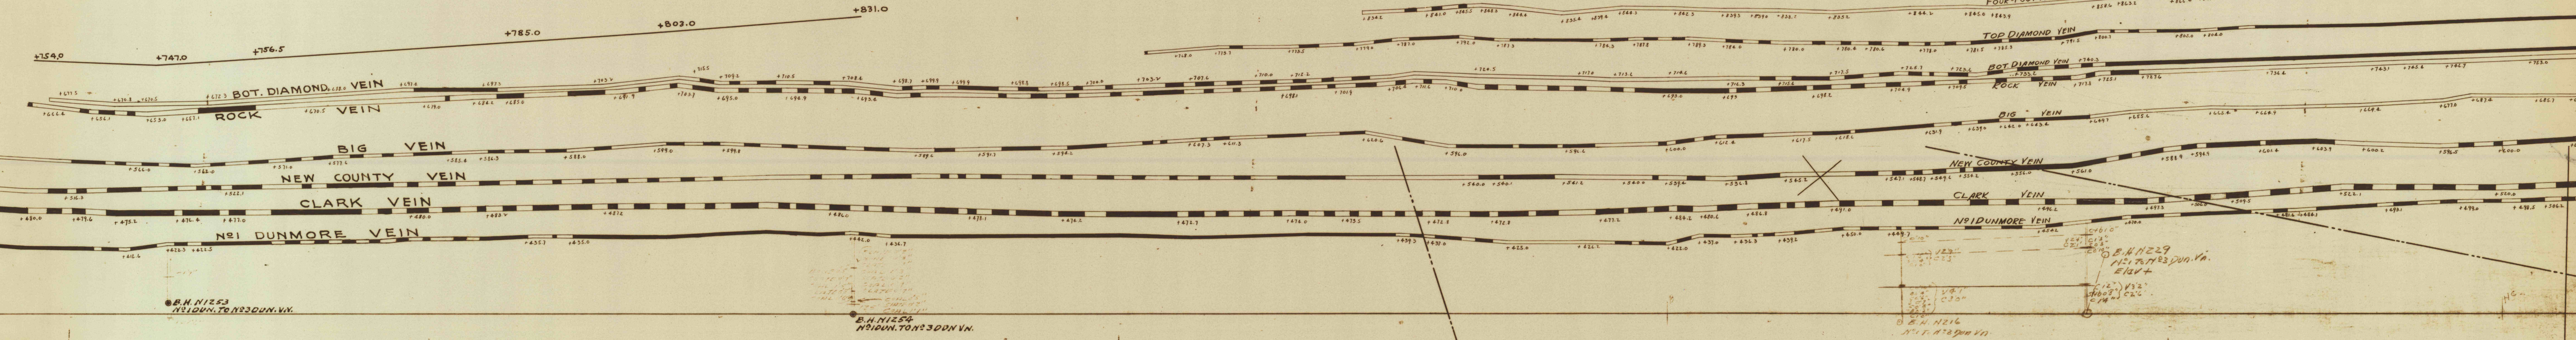

SLIDE 2-2
5-2