


No MINING

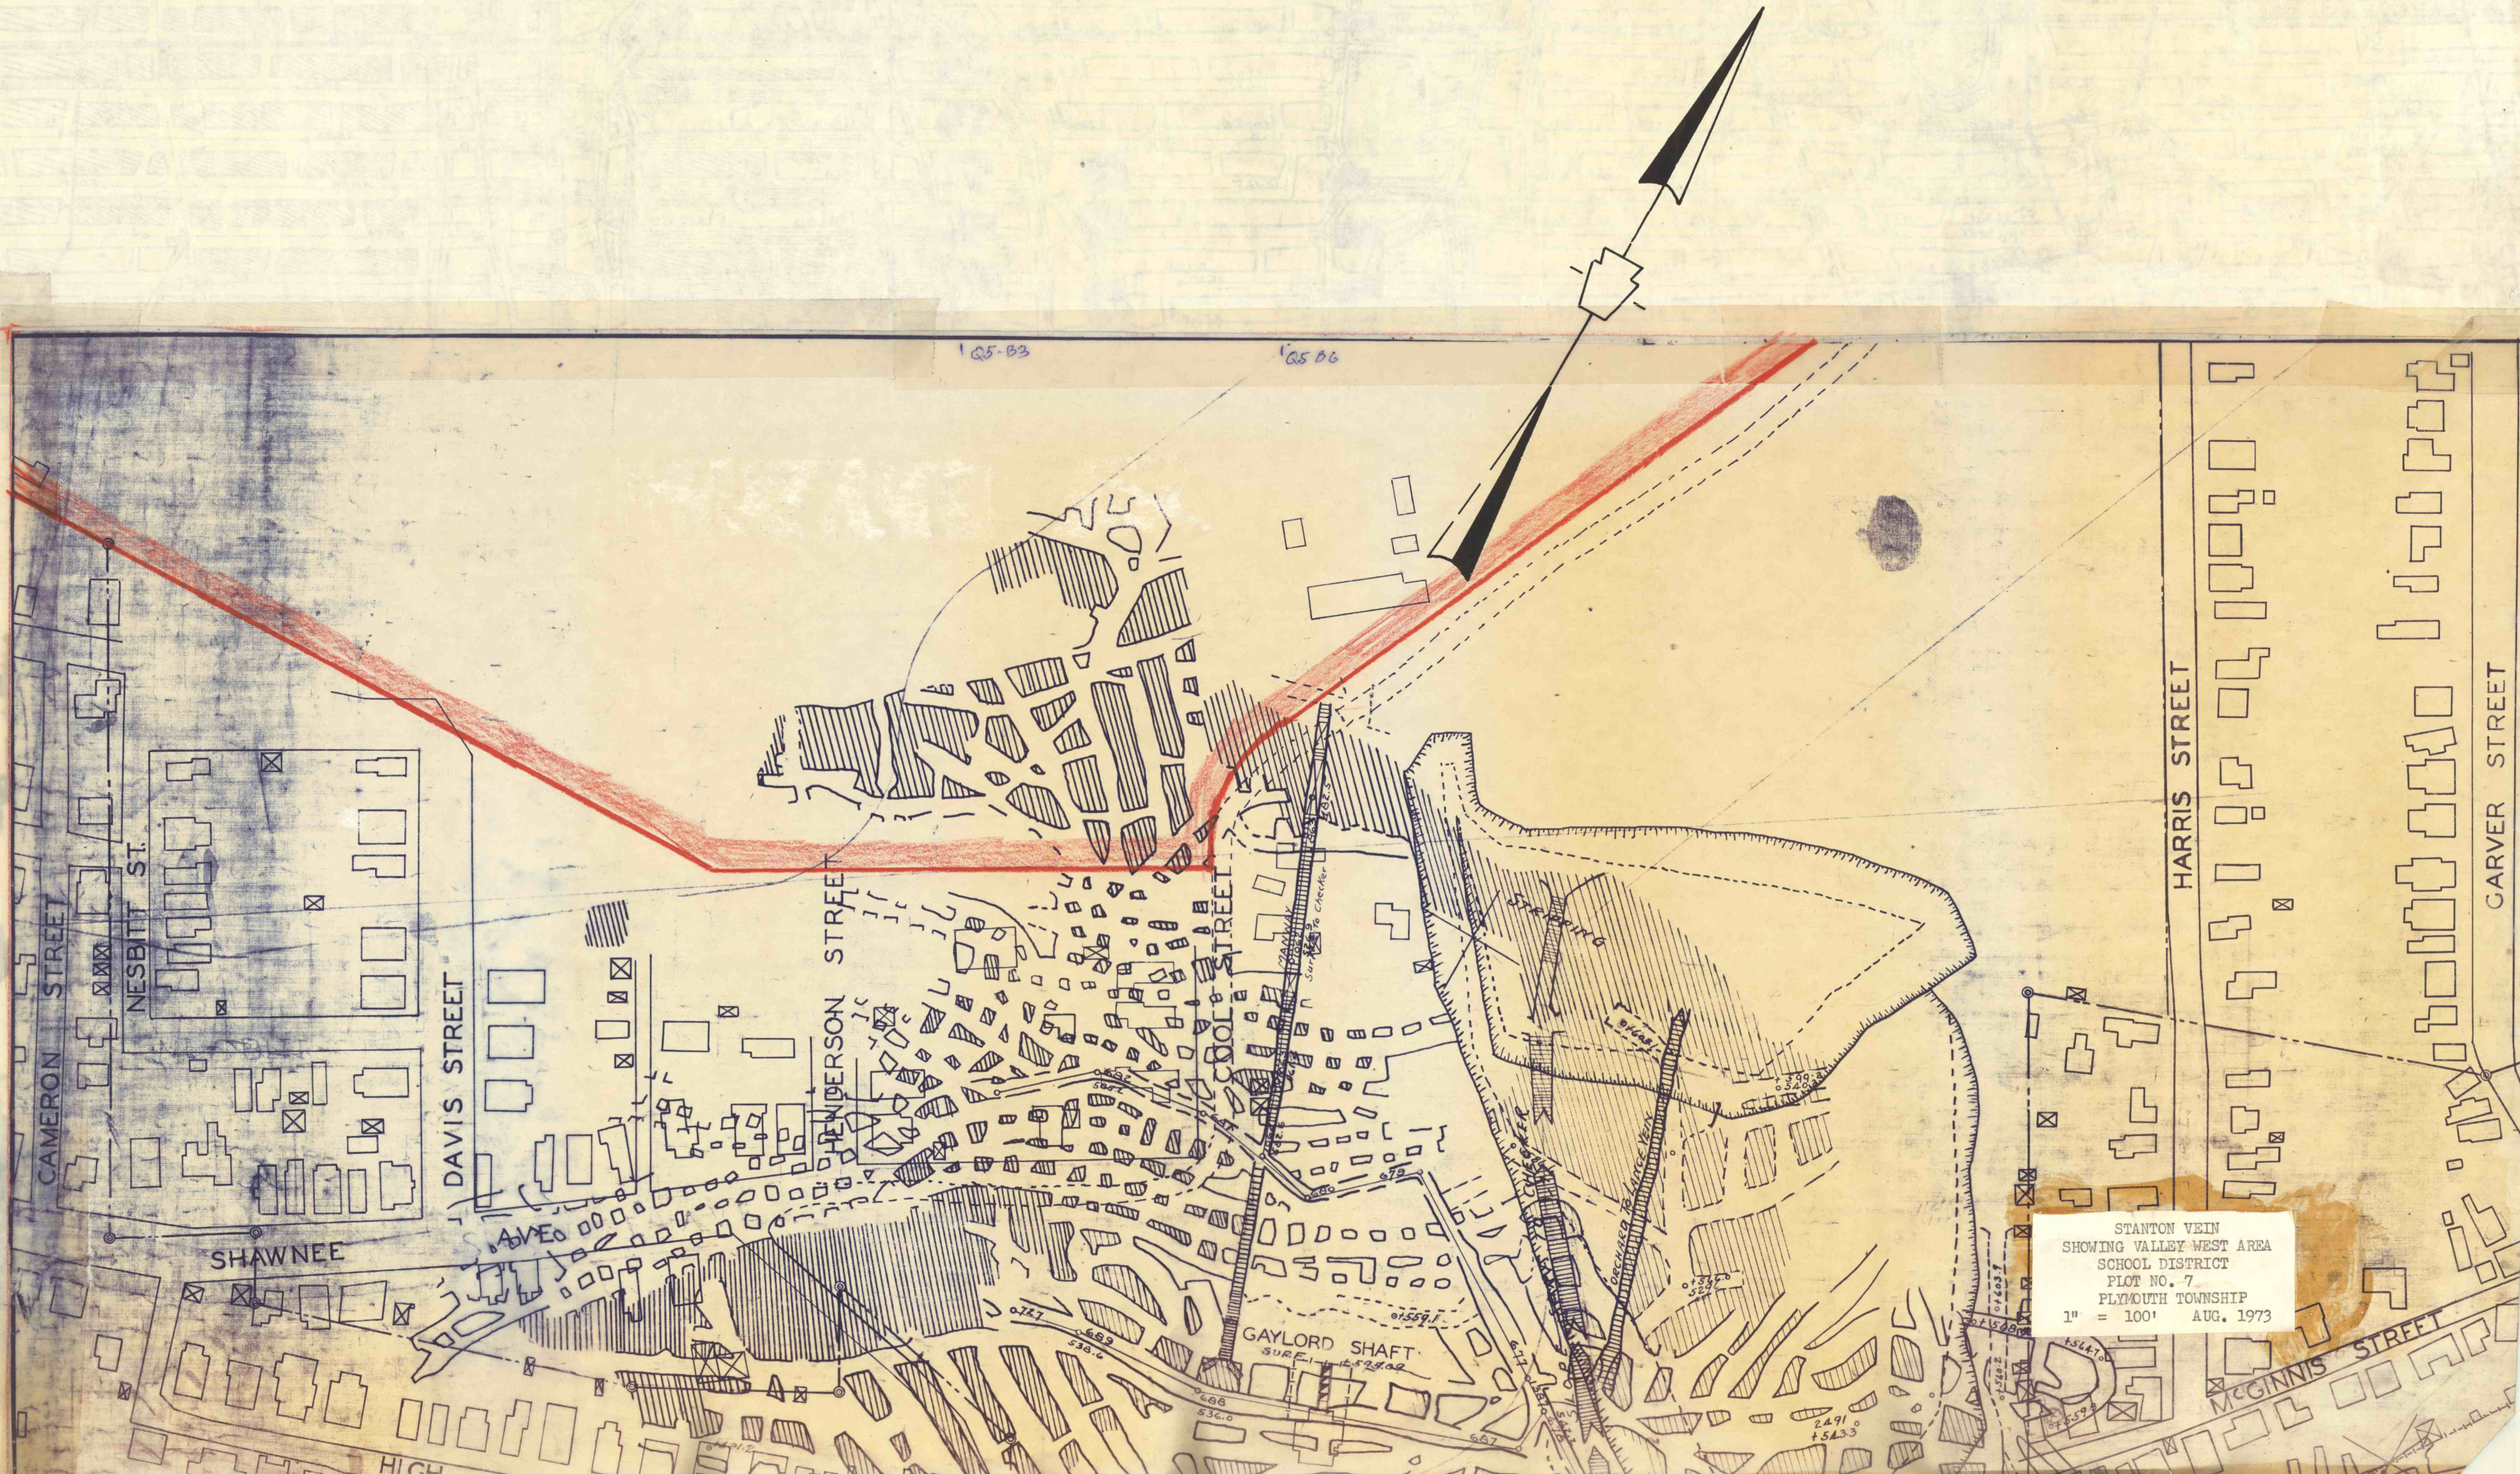

STANTON VEIN
SHOWING VALLEY WEST AREA
SCHOOL DISTRICT
PLOT NO. 7
PLYMOUTH TOWNSHIP
1" = 100' AUG. 1973