


GLEN AL

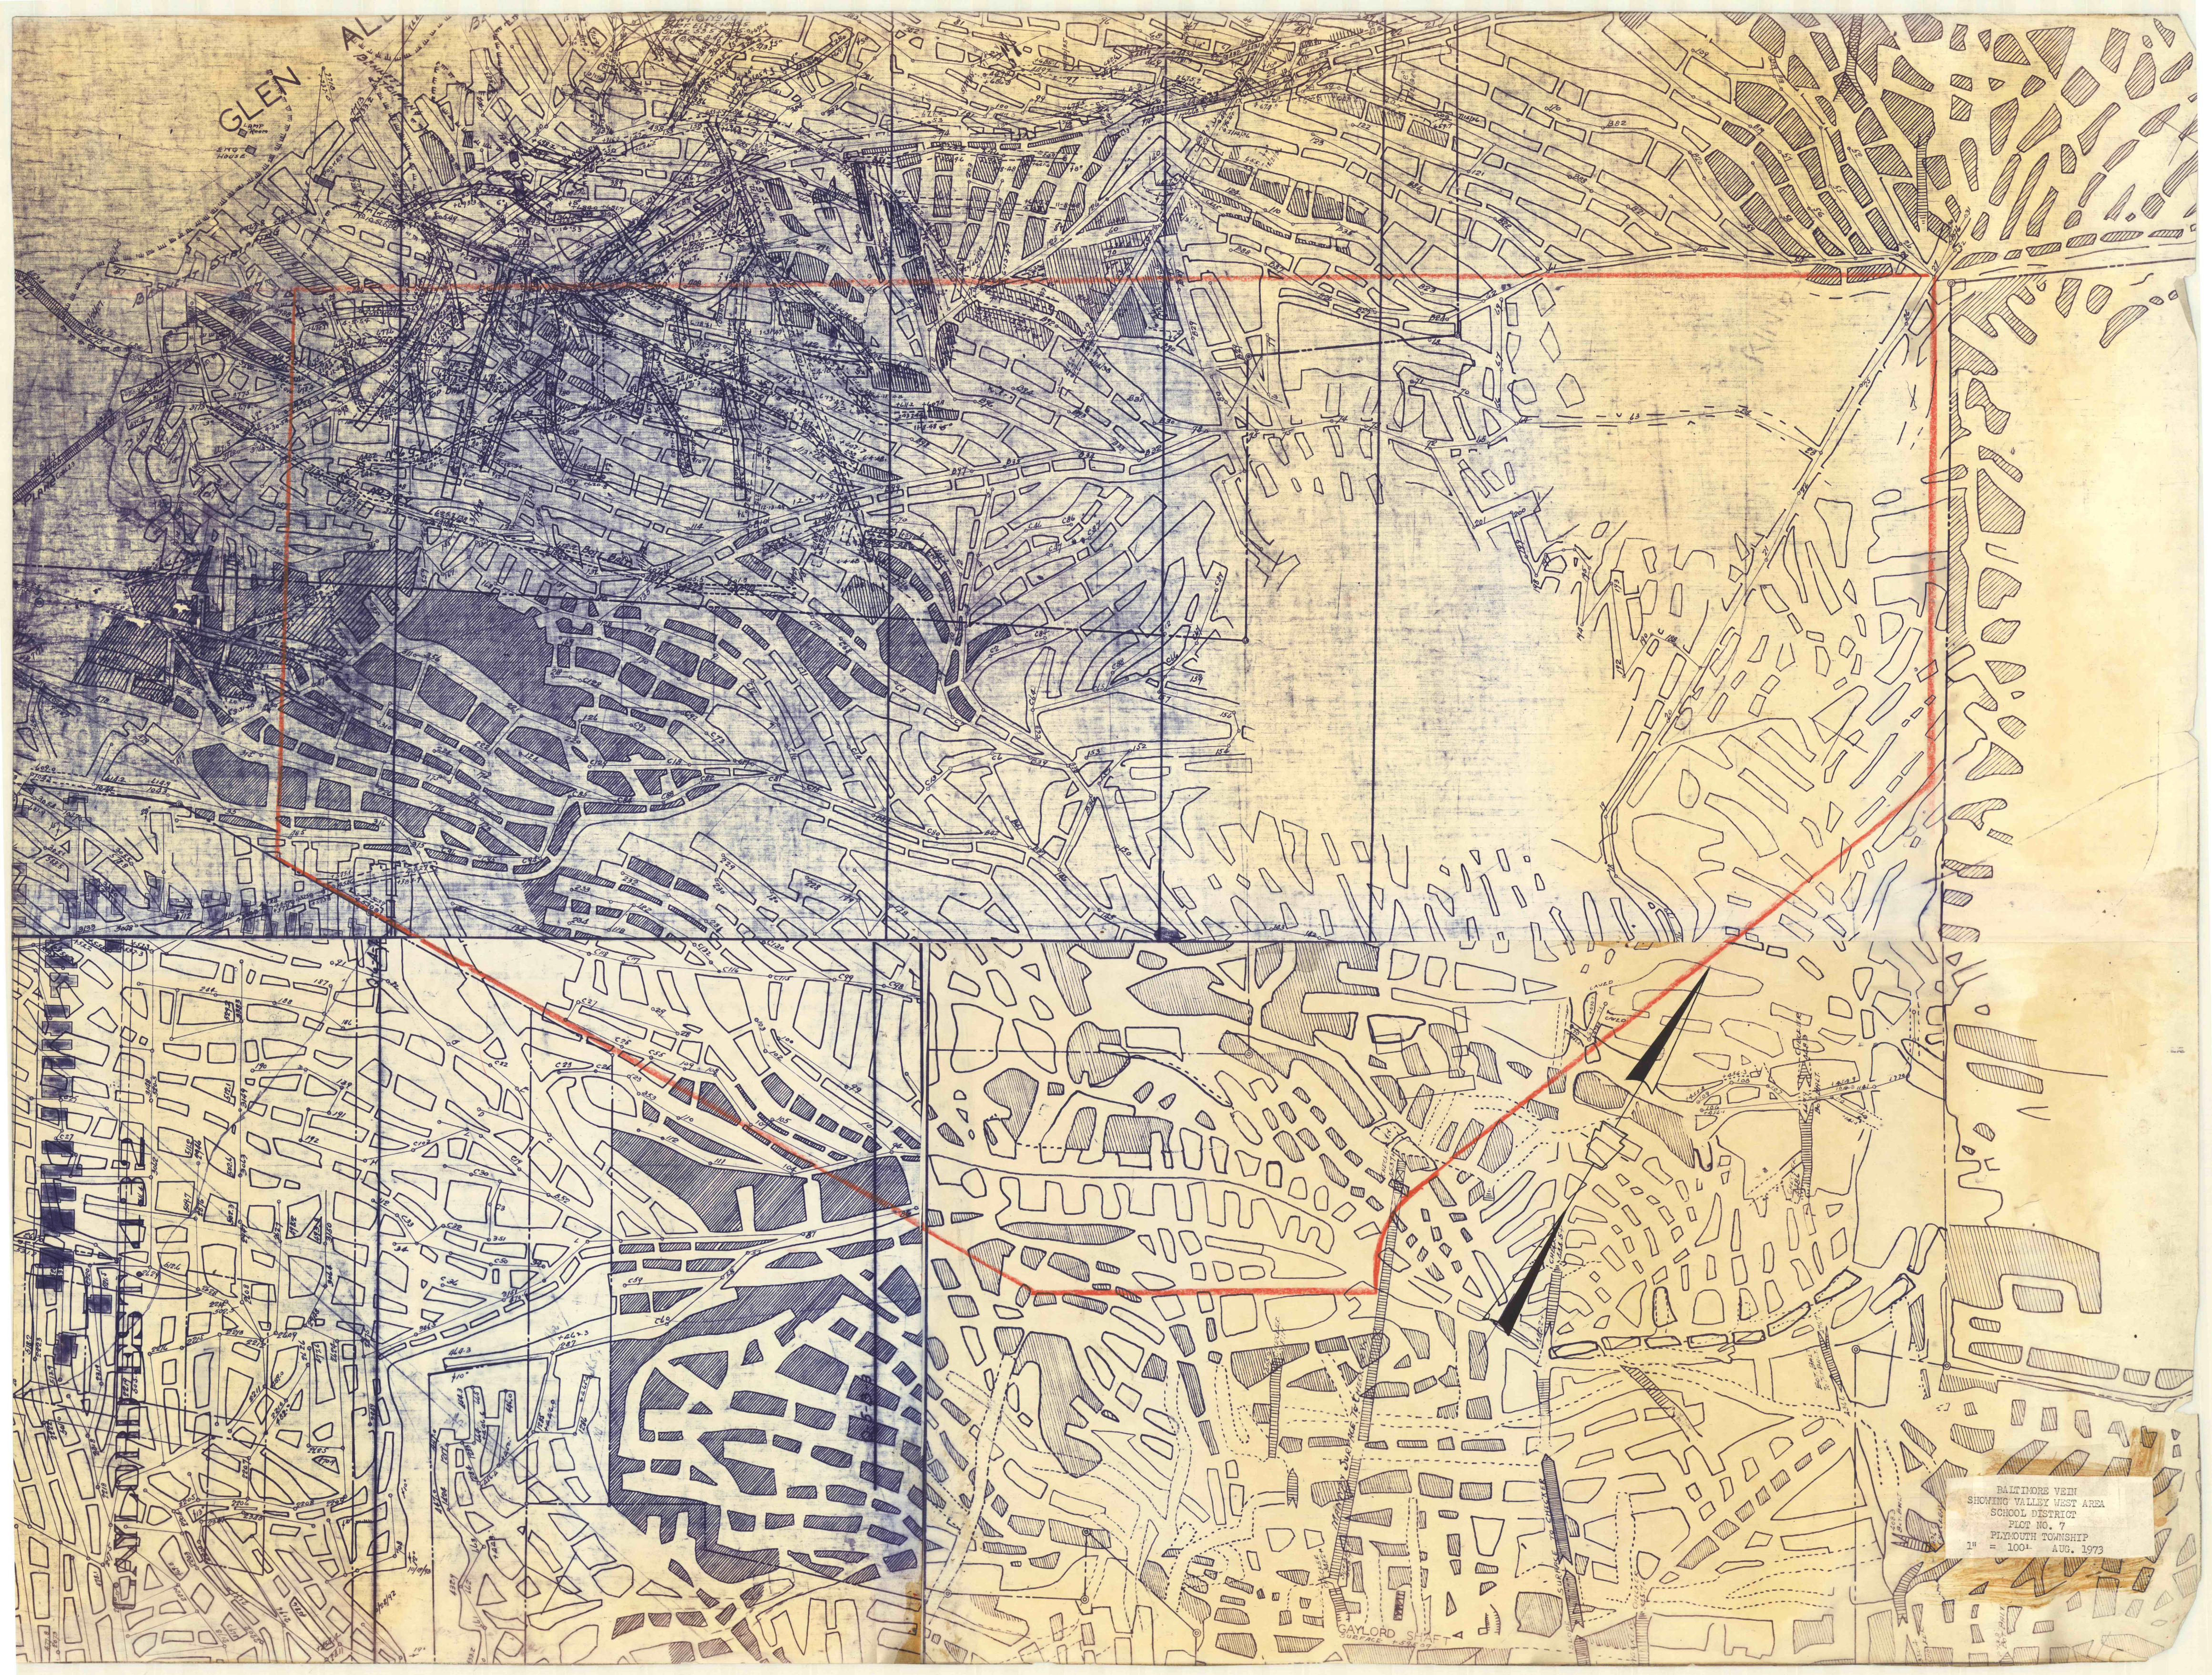

BALTIMORE VERN
 SHOWING VALLEY WEST AREA
 SCHOOL DISTRICT
 PLOT NO. 7
 PLYMOUTH TOWNSHIP
 1" = 100' AUG. 1973

GAYLORD ST