

X-SEC 5-6

X-SEC 3-4


X-SEC 1-2

A

B

C

TOP RED ASH VEIN
LOREE COLLIERY
SCALE 1"=100'

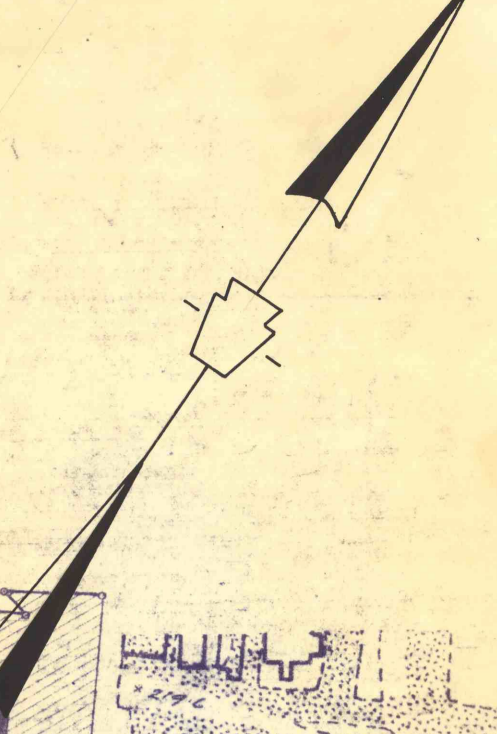

RESERVATION

RESERVED

RESERVED

BILLIARDS RESERVED
ABAND. AREA 5-55
9-28-55

HERN

BILLIARDS

HILLSIDE

AVENUE

SHAW

62

998

985

953

86

854

884

883

657

522

1083

627

687

577

508

778

835

959

866

852

894

708

930

992

664

620

1730

1157

930

992

935

783

987

833

846

932

886

1057

57

BILLIARDS

1025

1057

RESERVED

