


X SECTION No 1

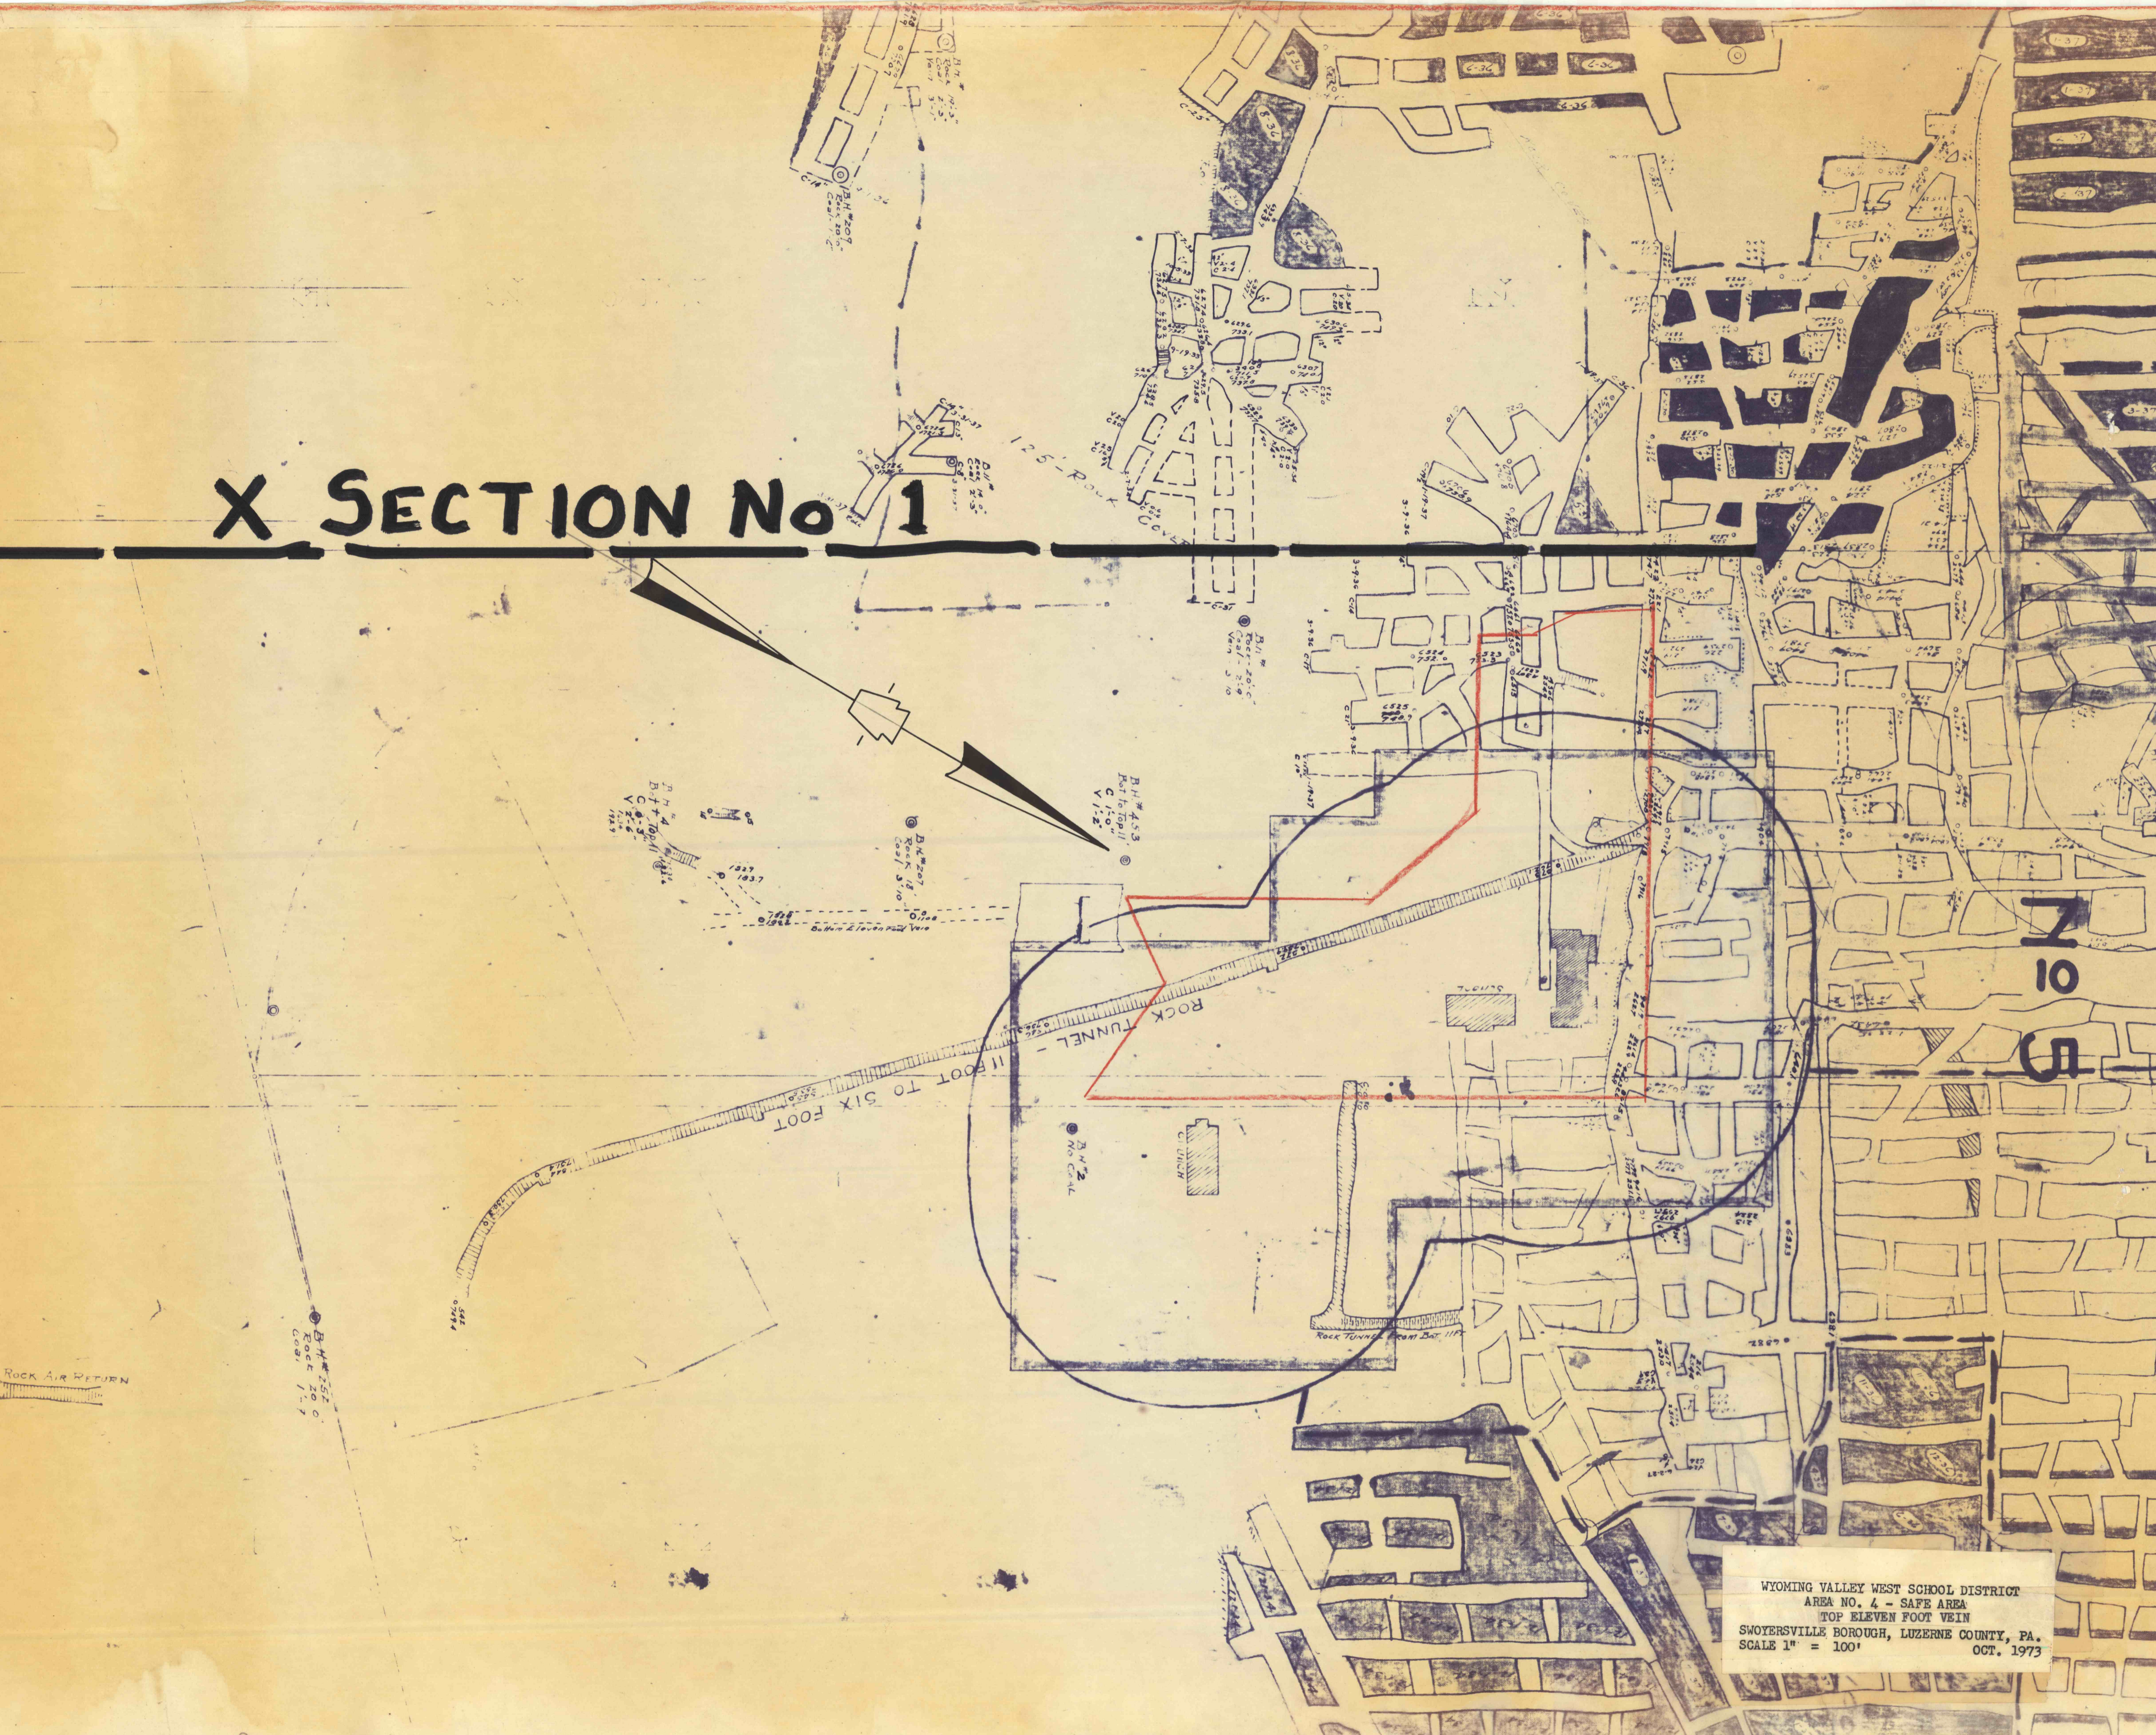

WYOMING VALLEY WEST SCHOOL DISTRICT
AREA NO. 4 - SAFE AREA
TOP ELEVEN FOOT VEIN
SWOYERSVILLE BOROUGH, LUZERNE COUNTY, PA.
SCALE 1" = 100' OCT. 1973