


**X SECTION No 1**

38

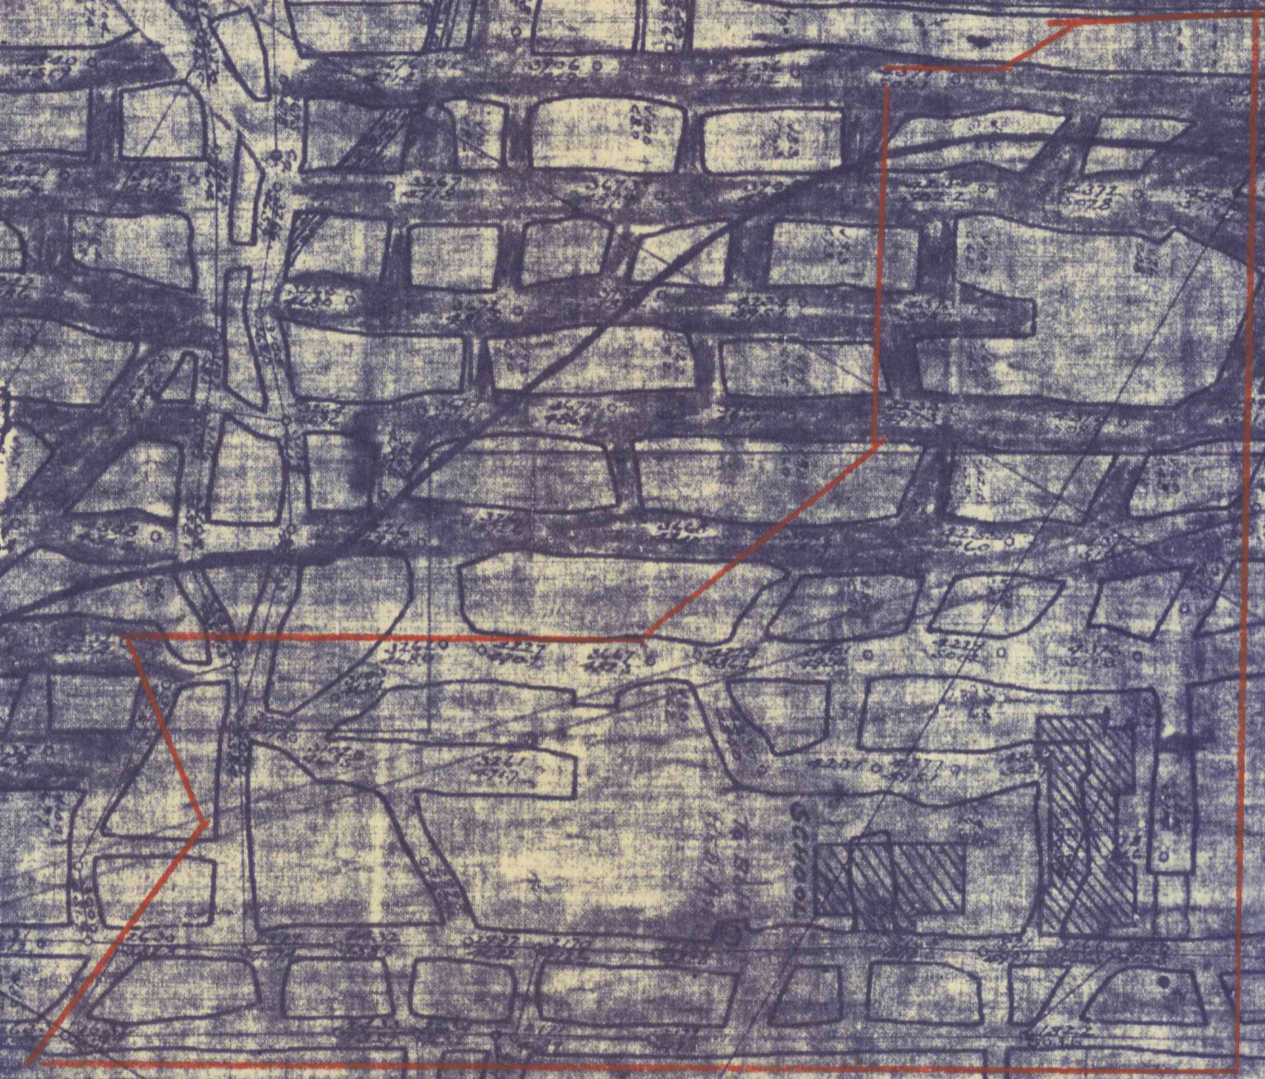

WYOMING VALLEY WEST SCHOOL DISTRICT  
AREA NO. 4 - SAFE AREA  
RED ASH VEIN  
SWOYERSVILLE BOROUGH, LUZERNE COUNTY, PA.  
SCALE 1" = 100'  
OCT. 1973