


R-6-B4

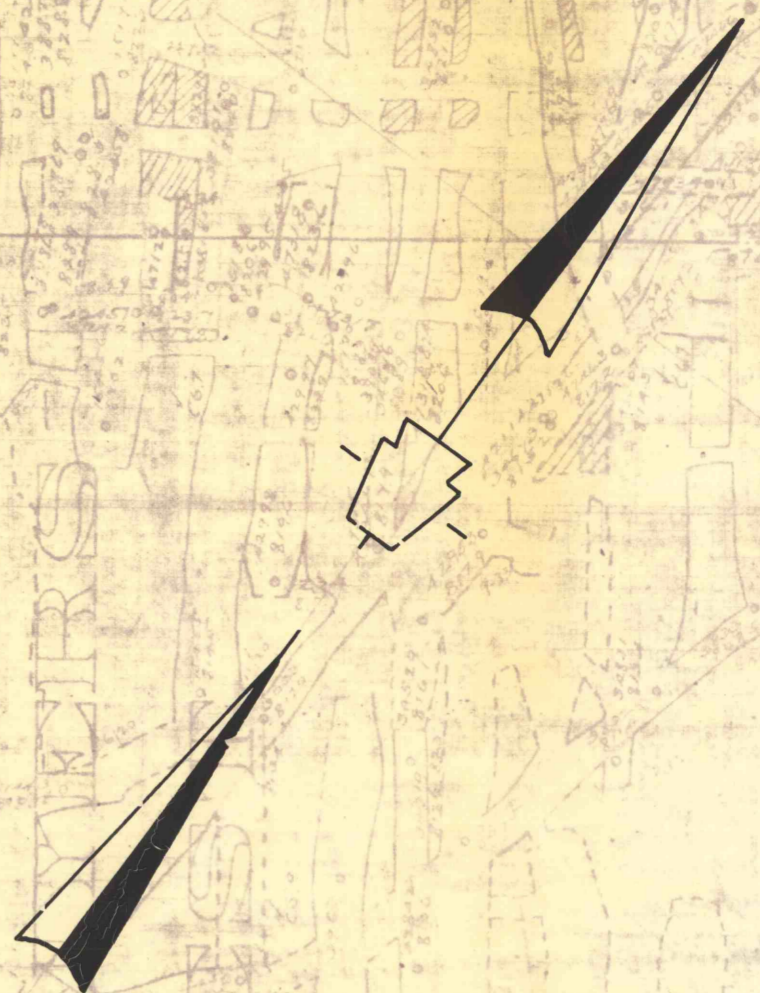

D. J. WALLER

HOY

