


R-6-84

HOYT & LOVELAND

HOYT & LOVELAND

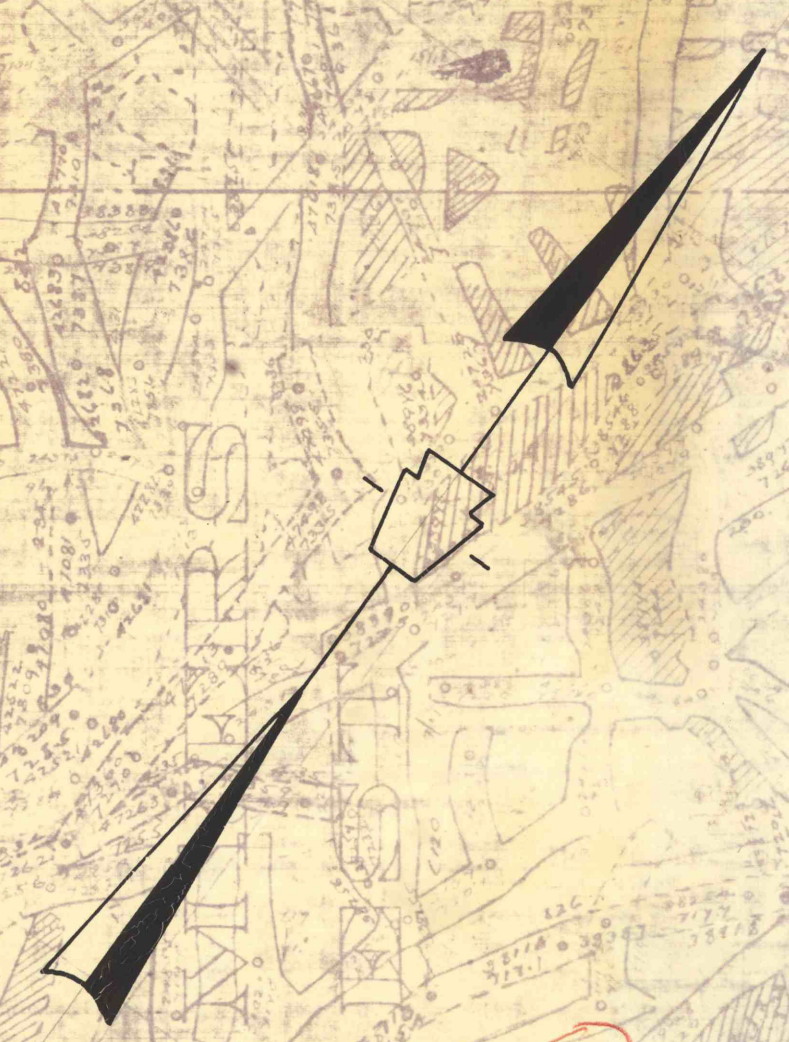

J. WALLER

W. WALLER

KINGSTON COAL CO.

ET ASH

50