

AREA 6

AREA 10


AREA 5

X-SECTION 2

AREA 9

AREA 4

X-SECTION 1

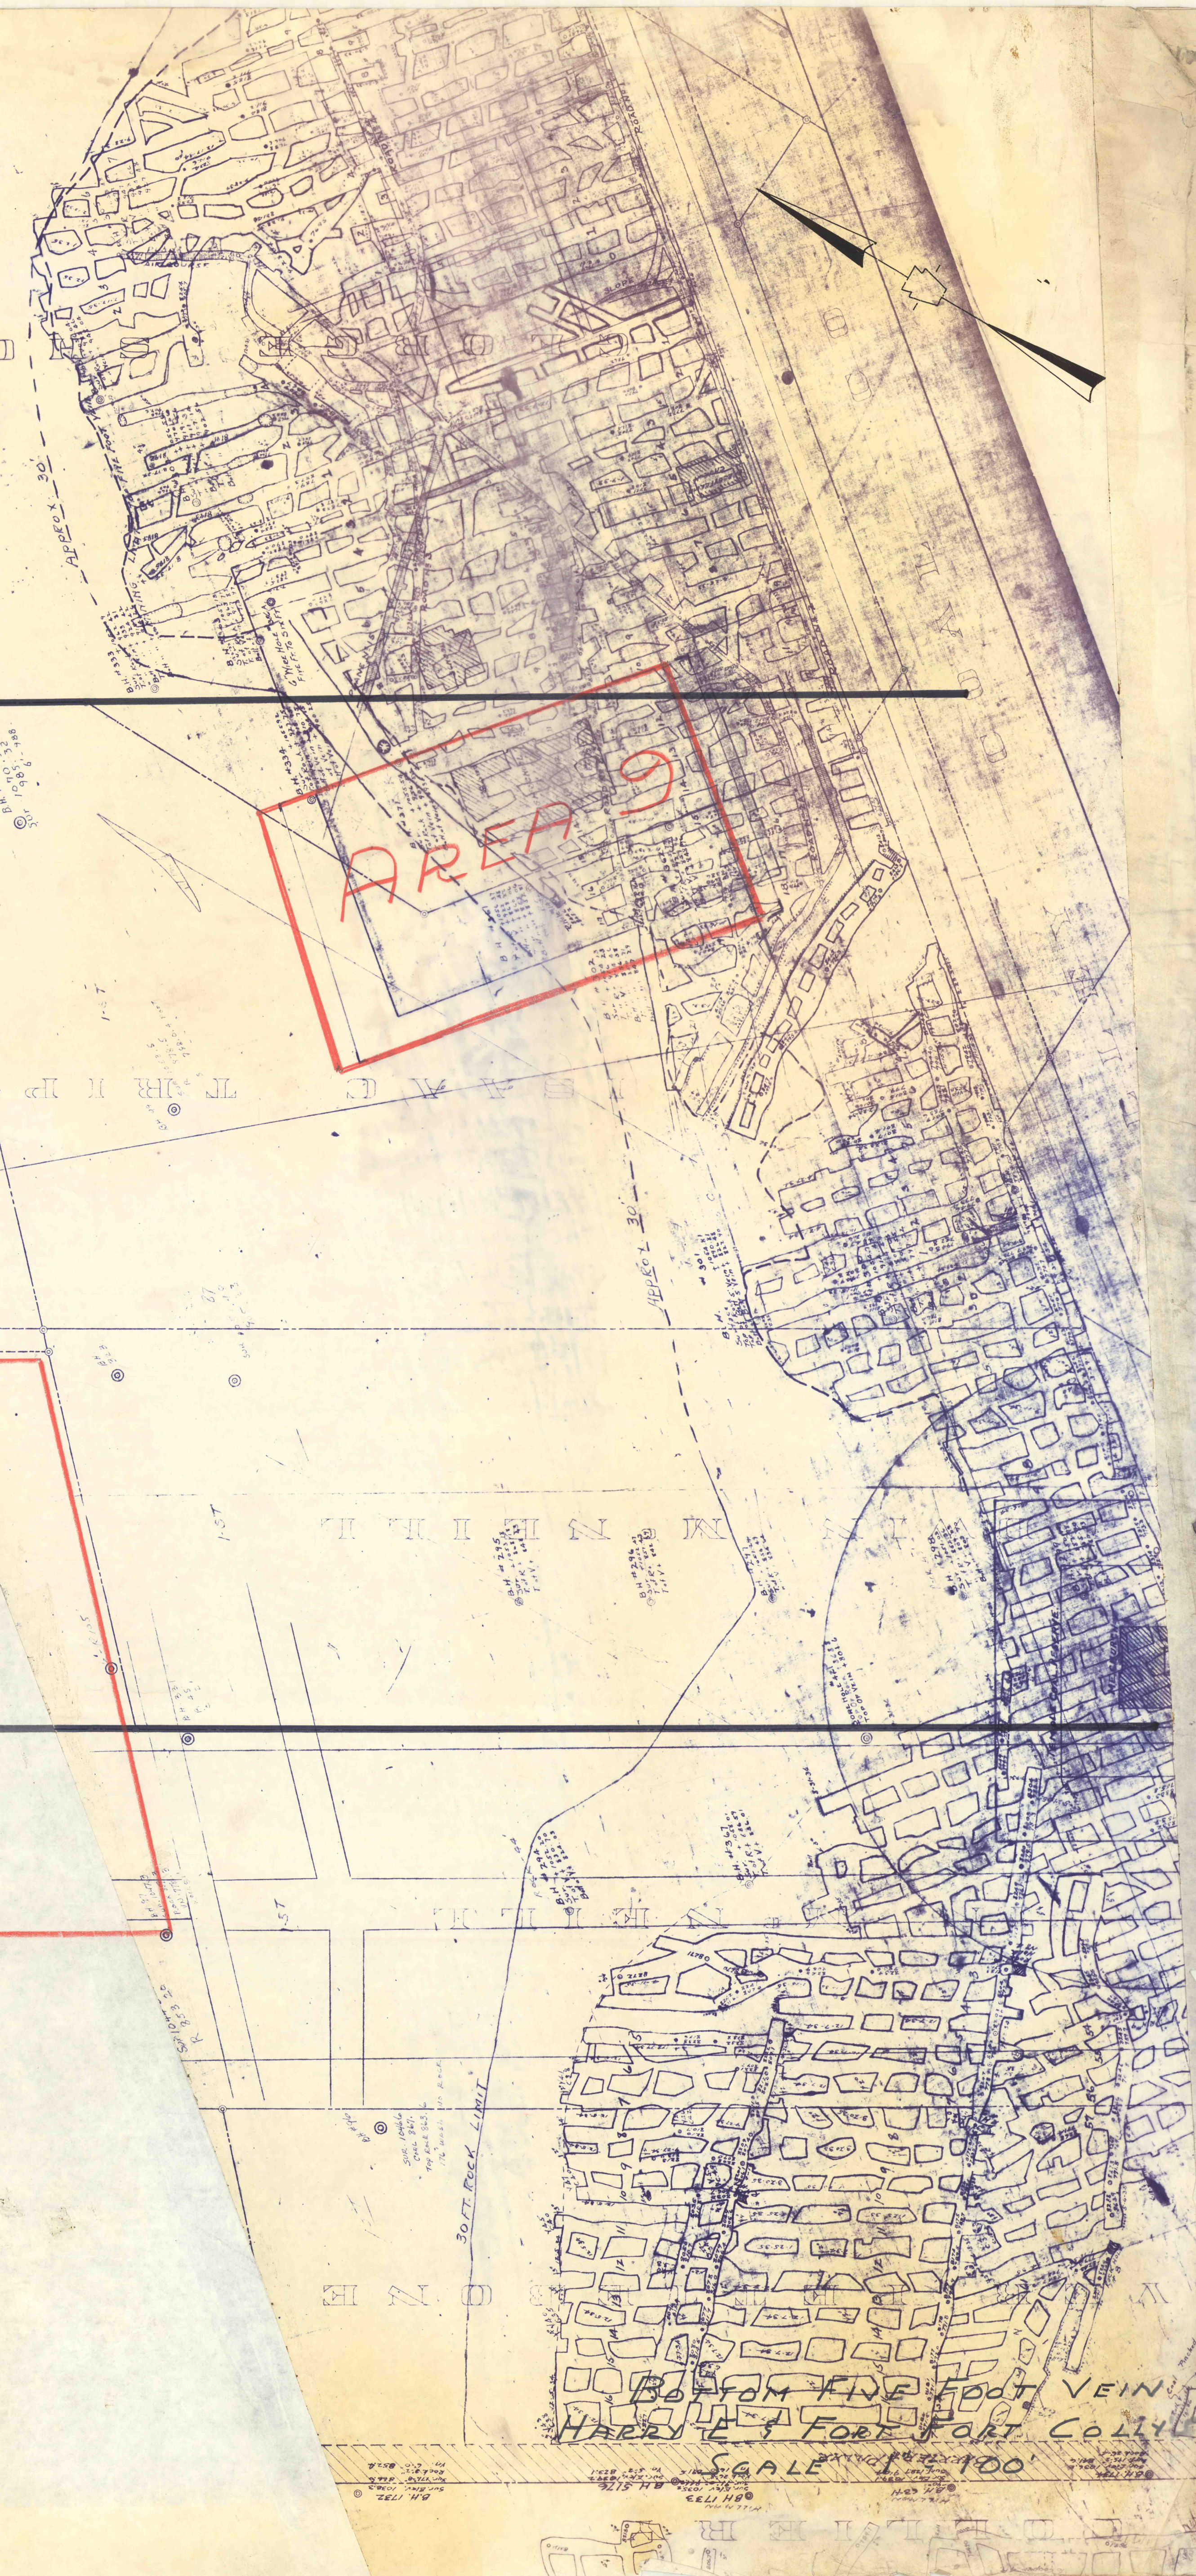

SCALE 1" = 100'