


COLLIER

WOODWARD

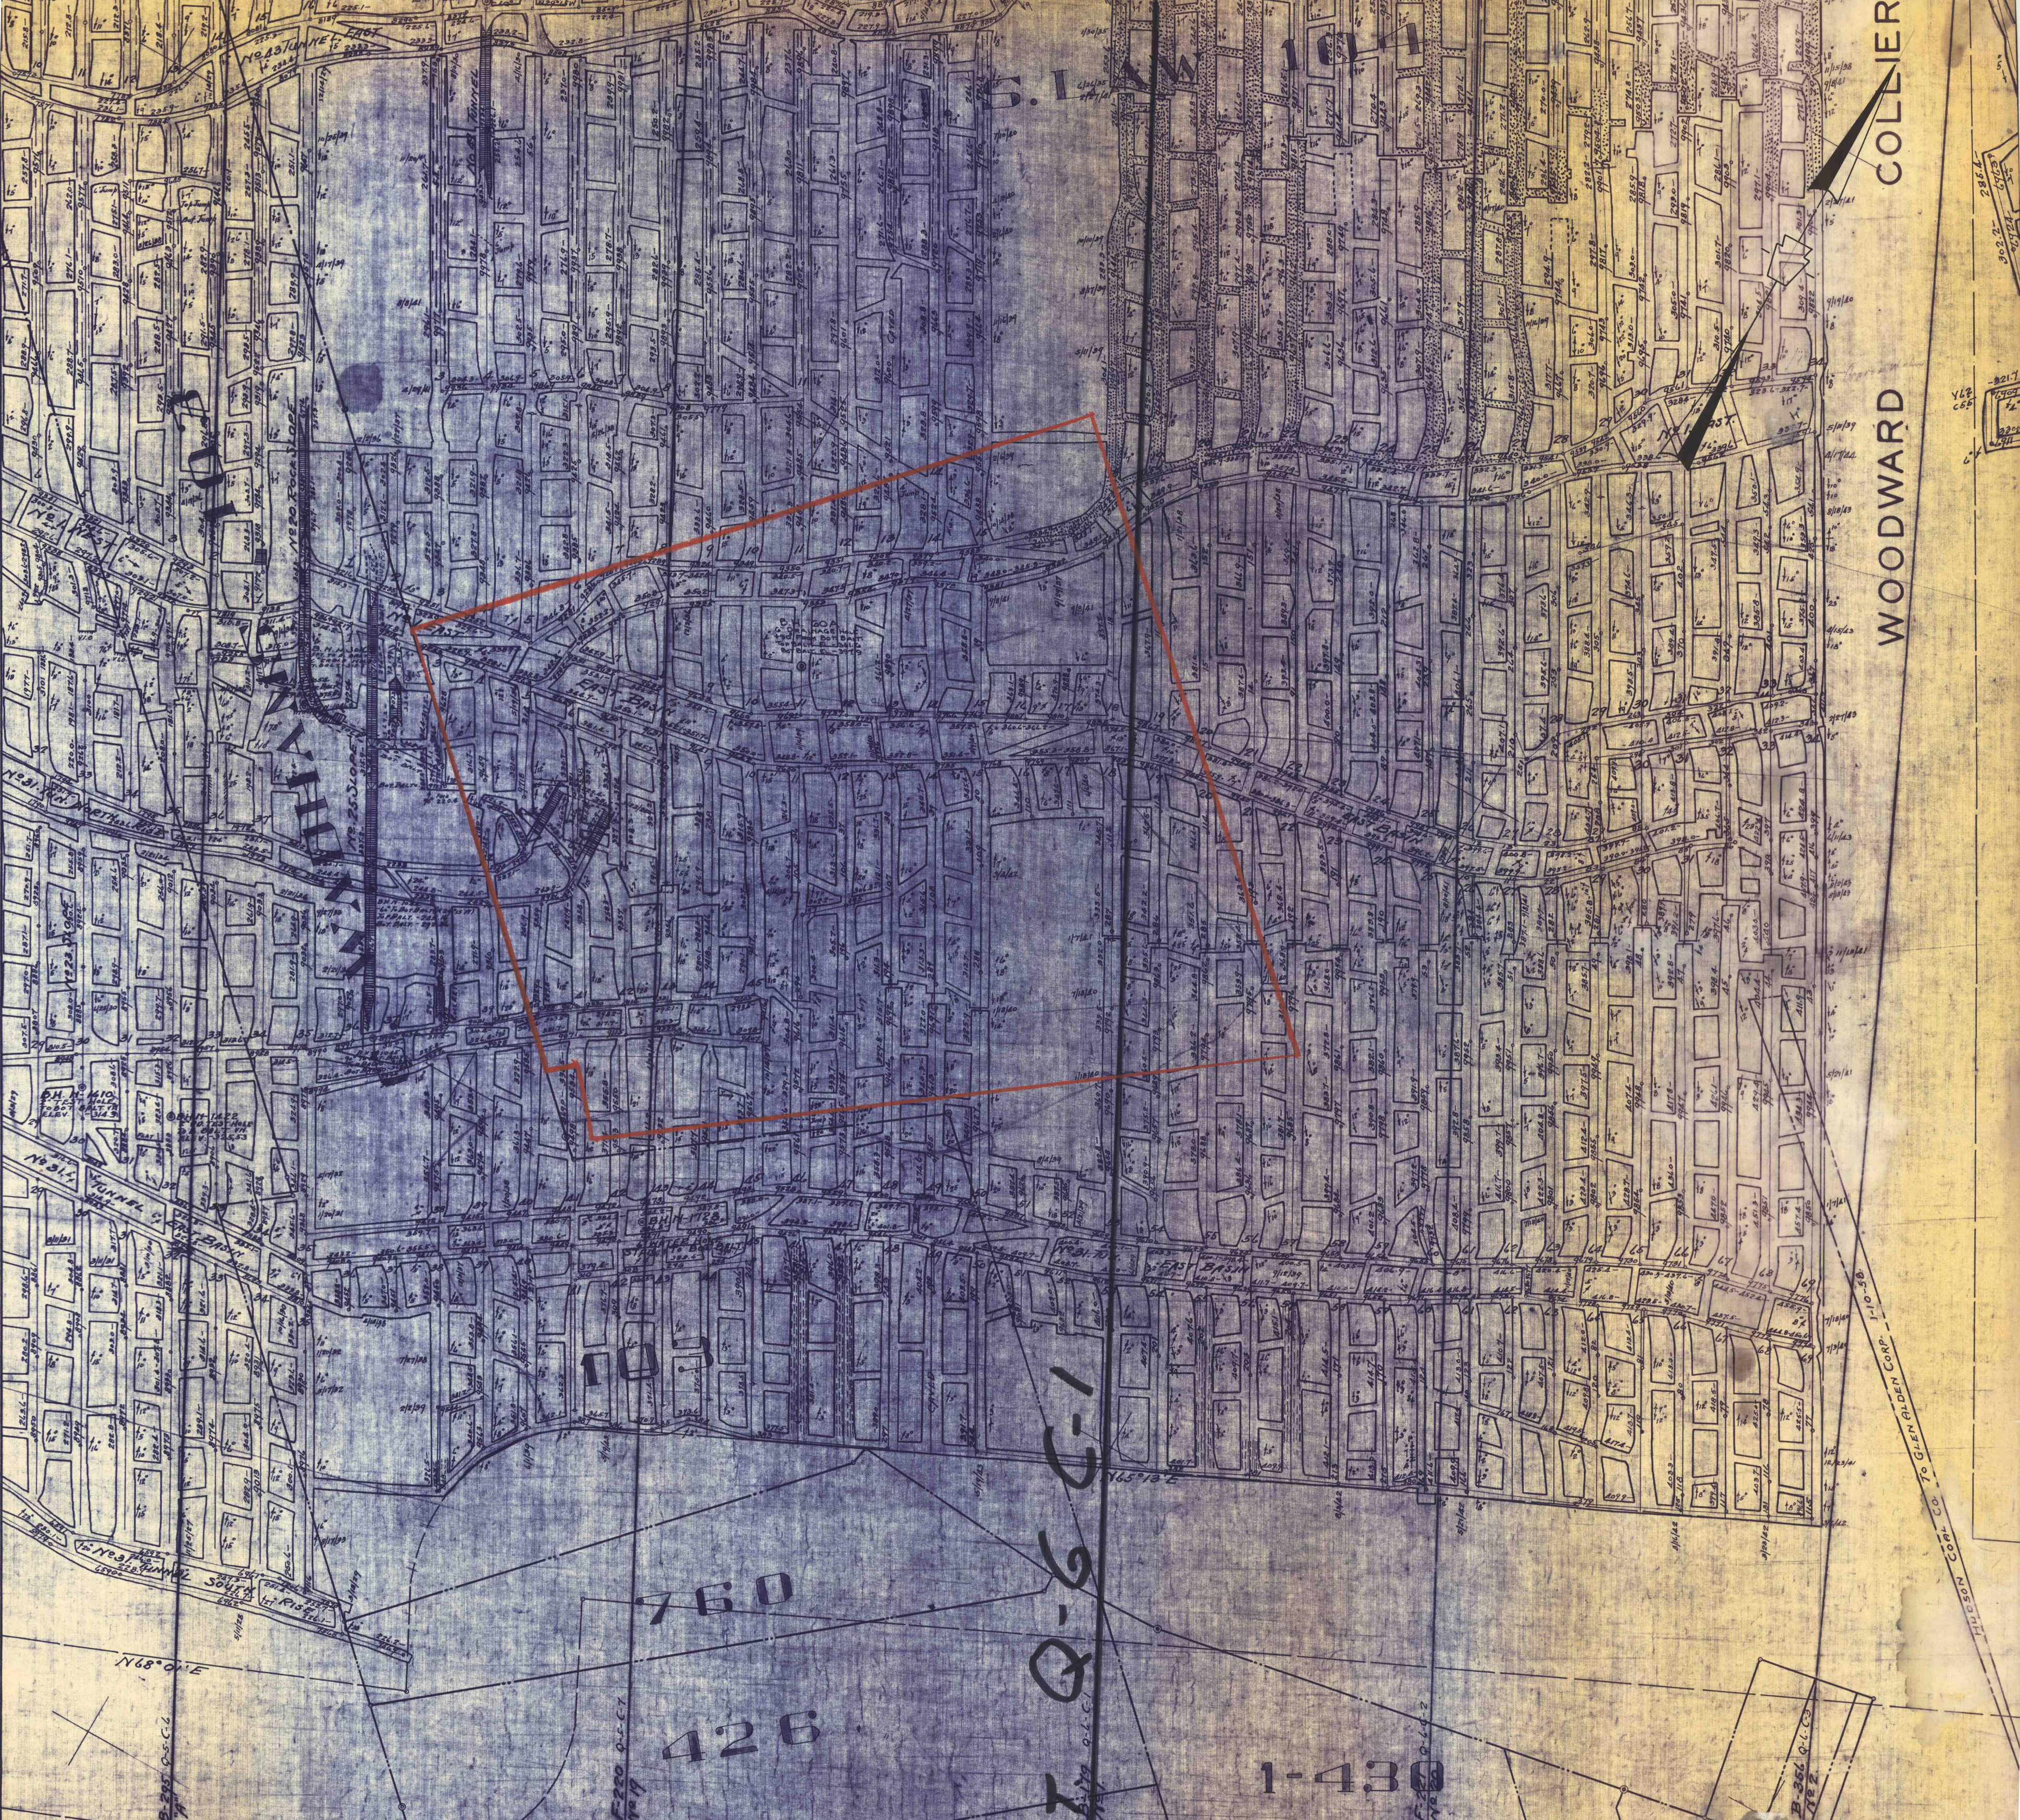

X-SECTION Q-6

LANCE NO 11 TOP BALTIMORE VEIN TO MORE VEIN LIERY

760

1-430

100'