


X-SECT. D-6-C-1

MINER PARK

Q-6-C-1

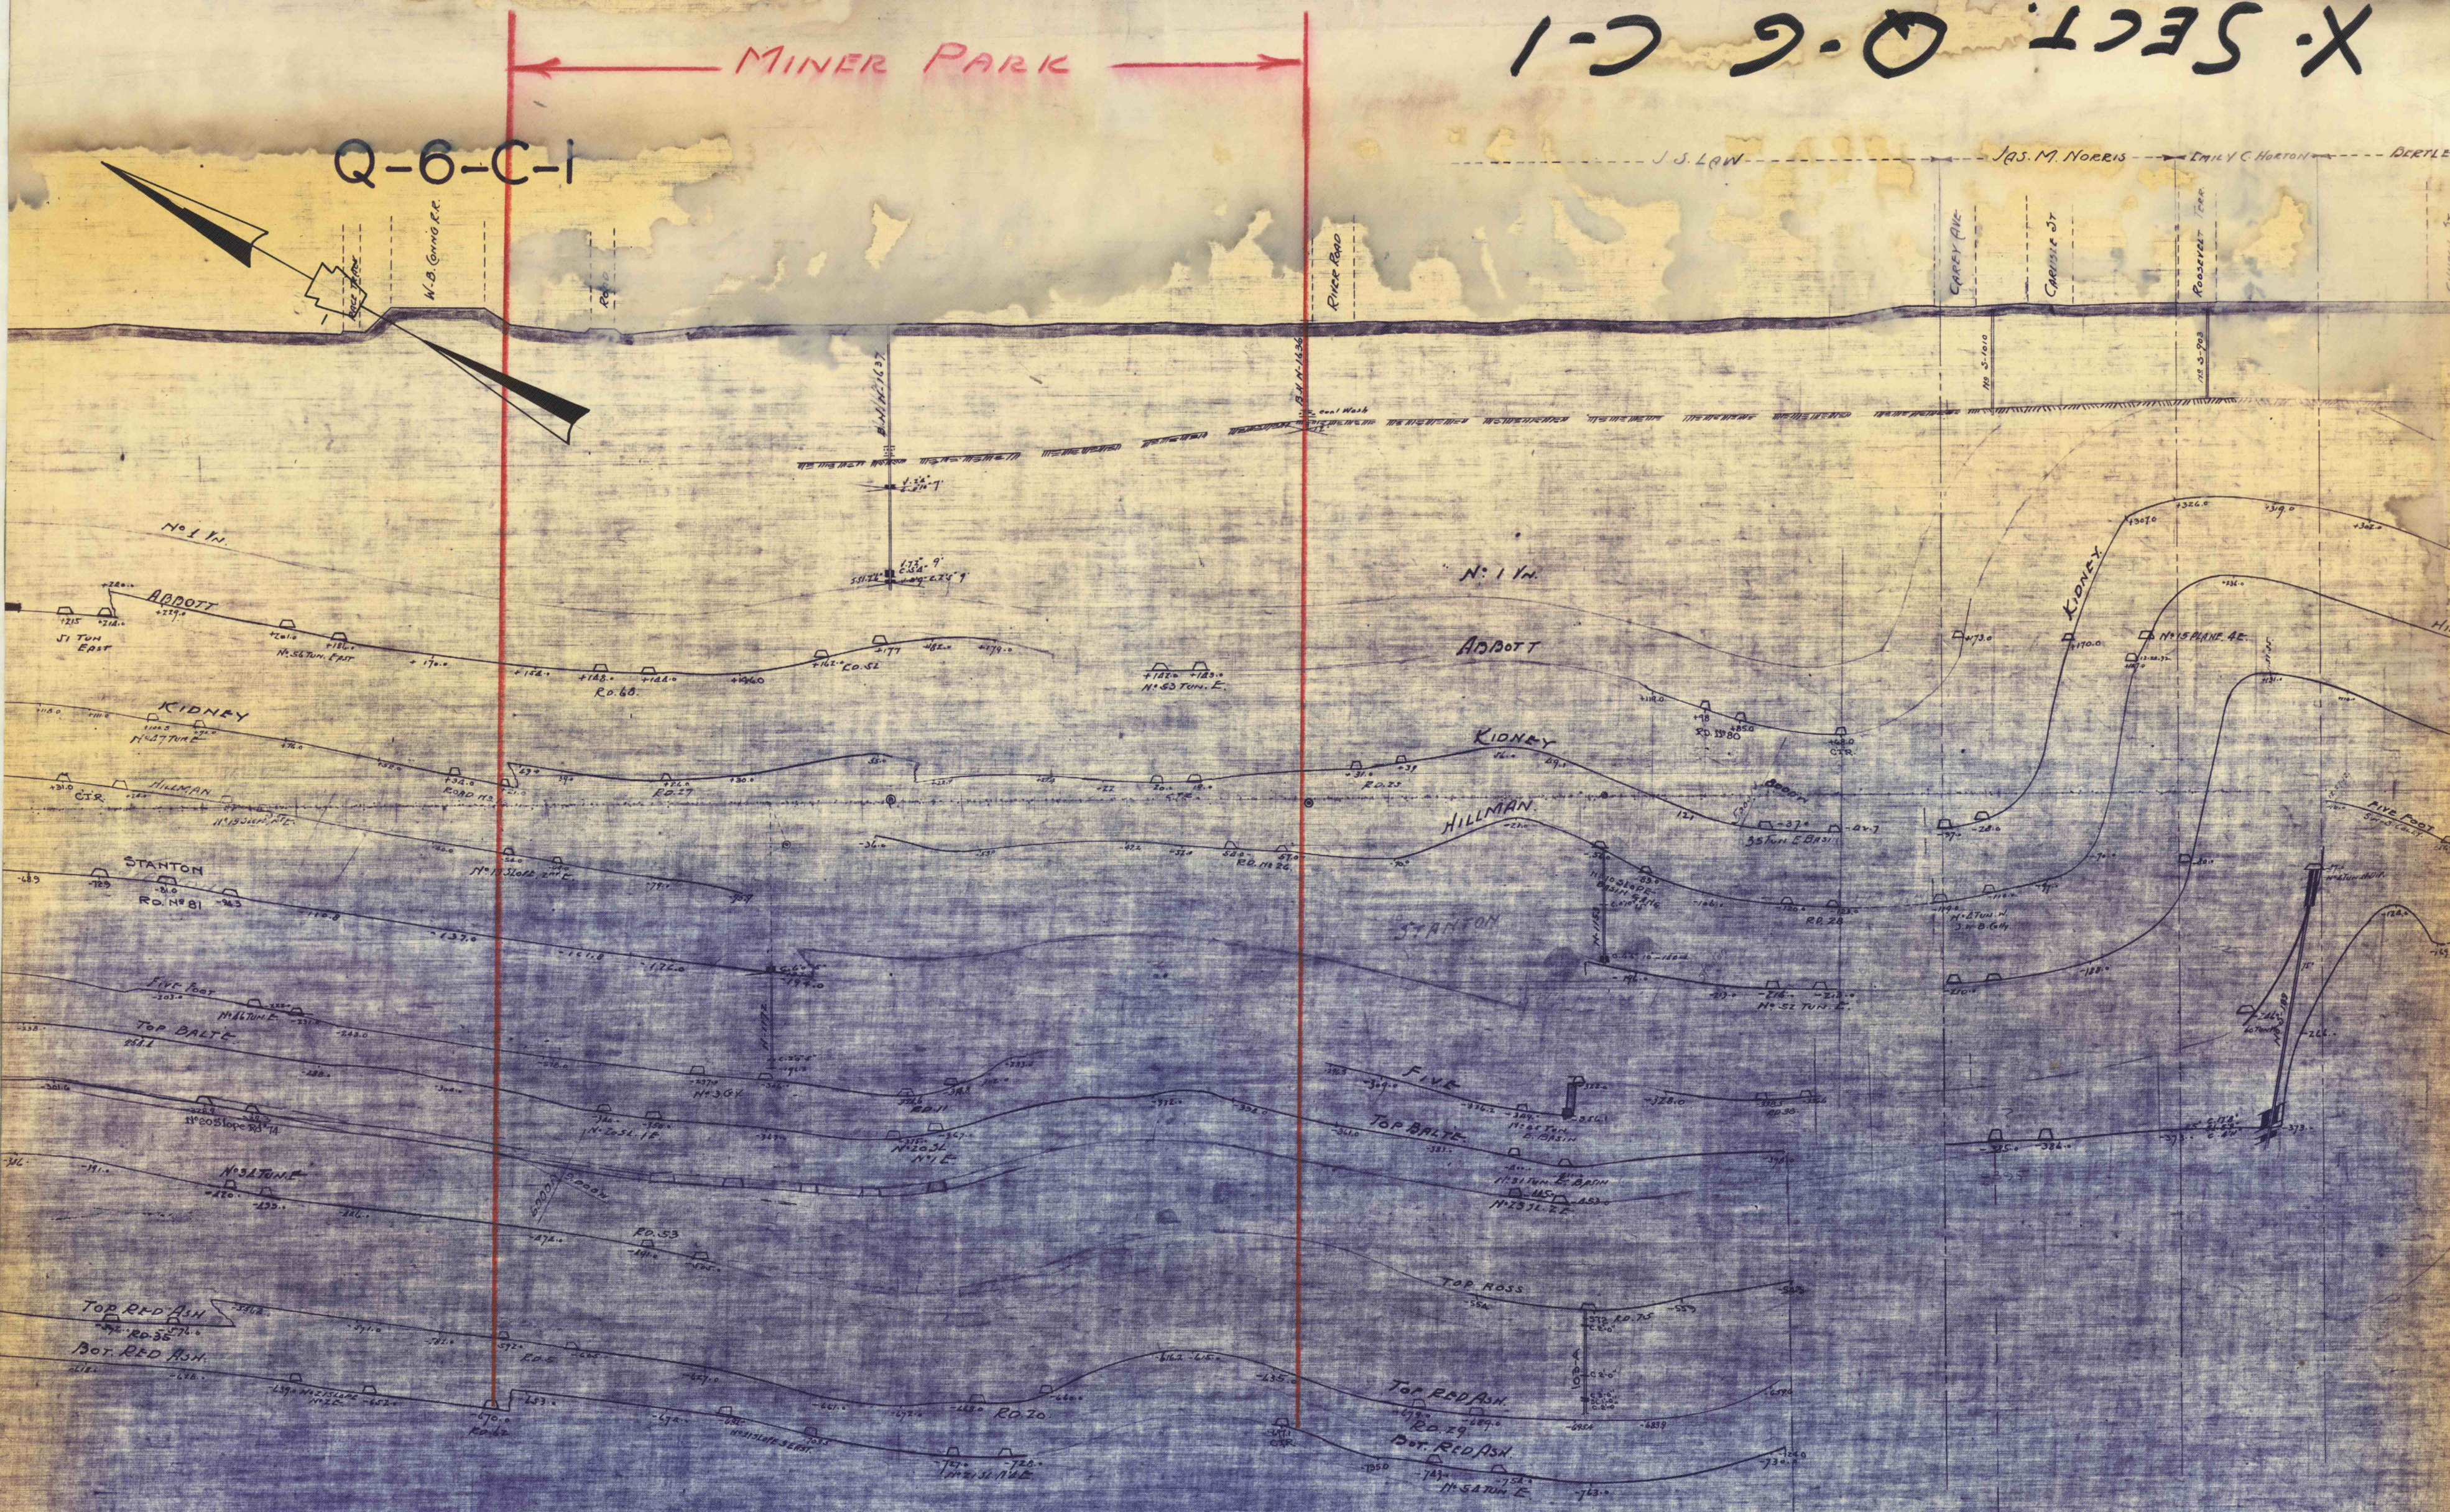

2 M	✓	3-16-50 SA	
	✓		
	✓		
	✓		
	✓		
8-25-54 SA	✓		
	✓		
	✓		
5-21-9-9-54 SA	✓		

8000' 10000'

1000' 5000'