


No 2 DUNMORE VEIN

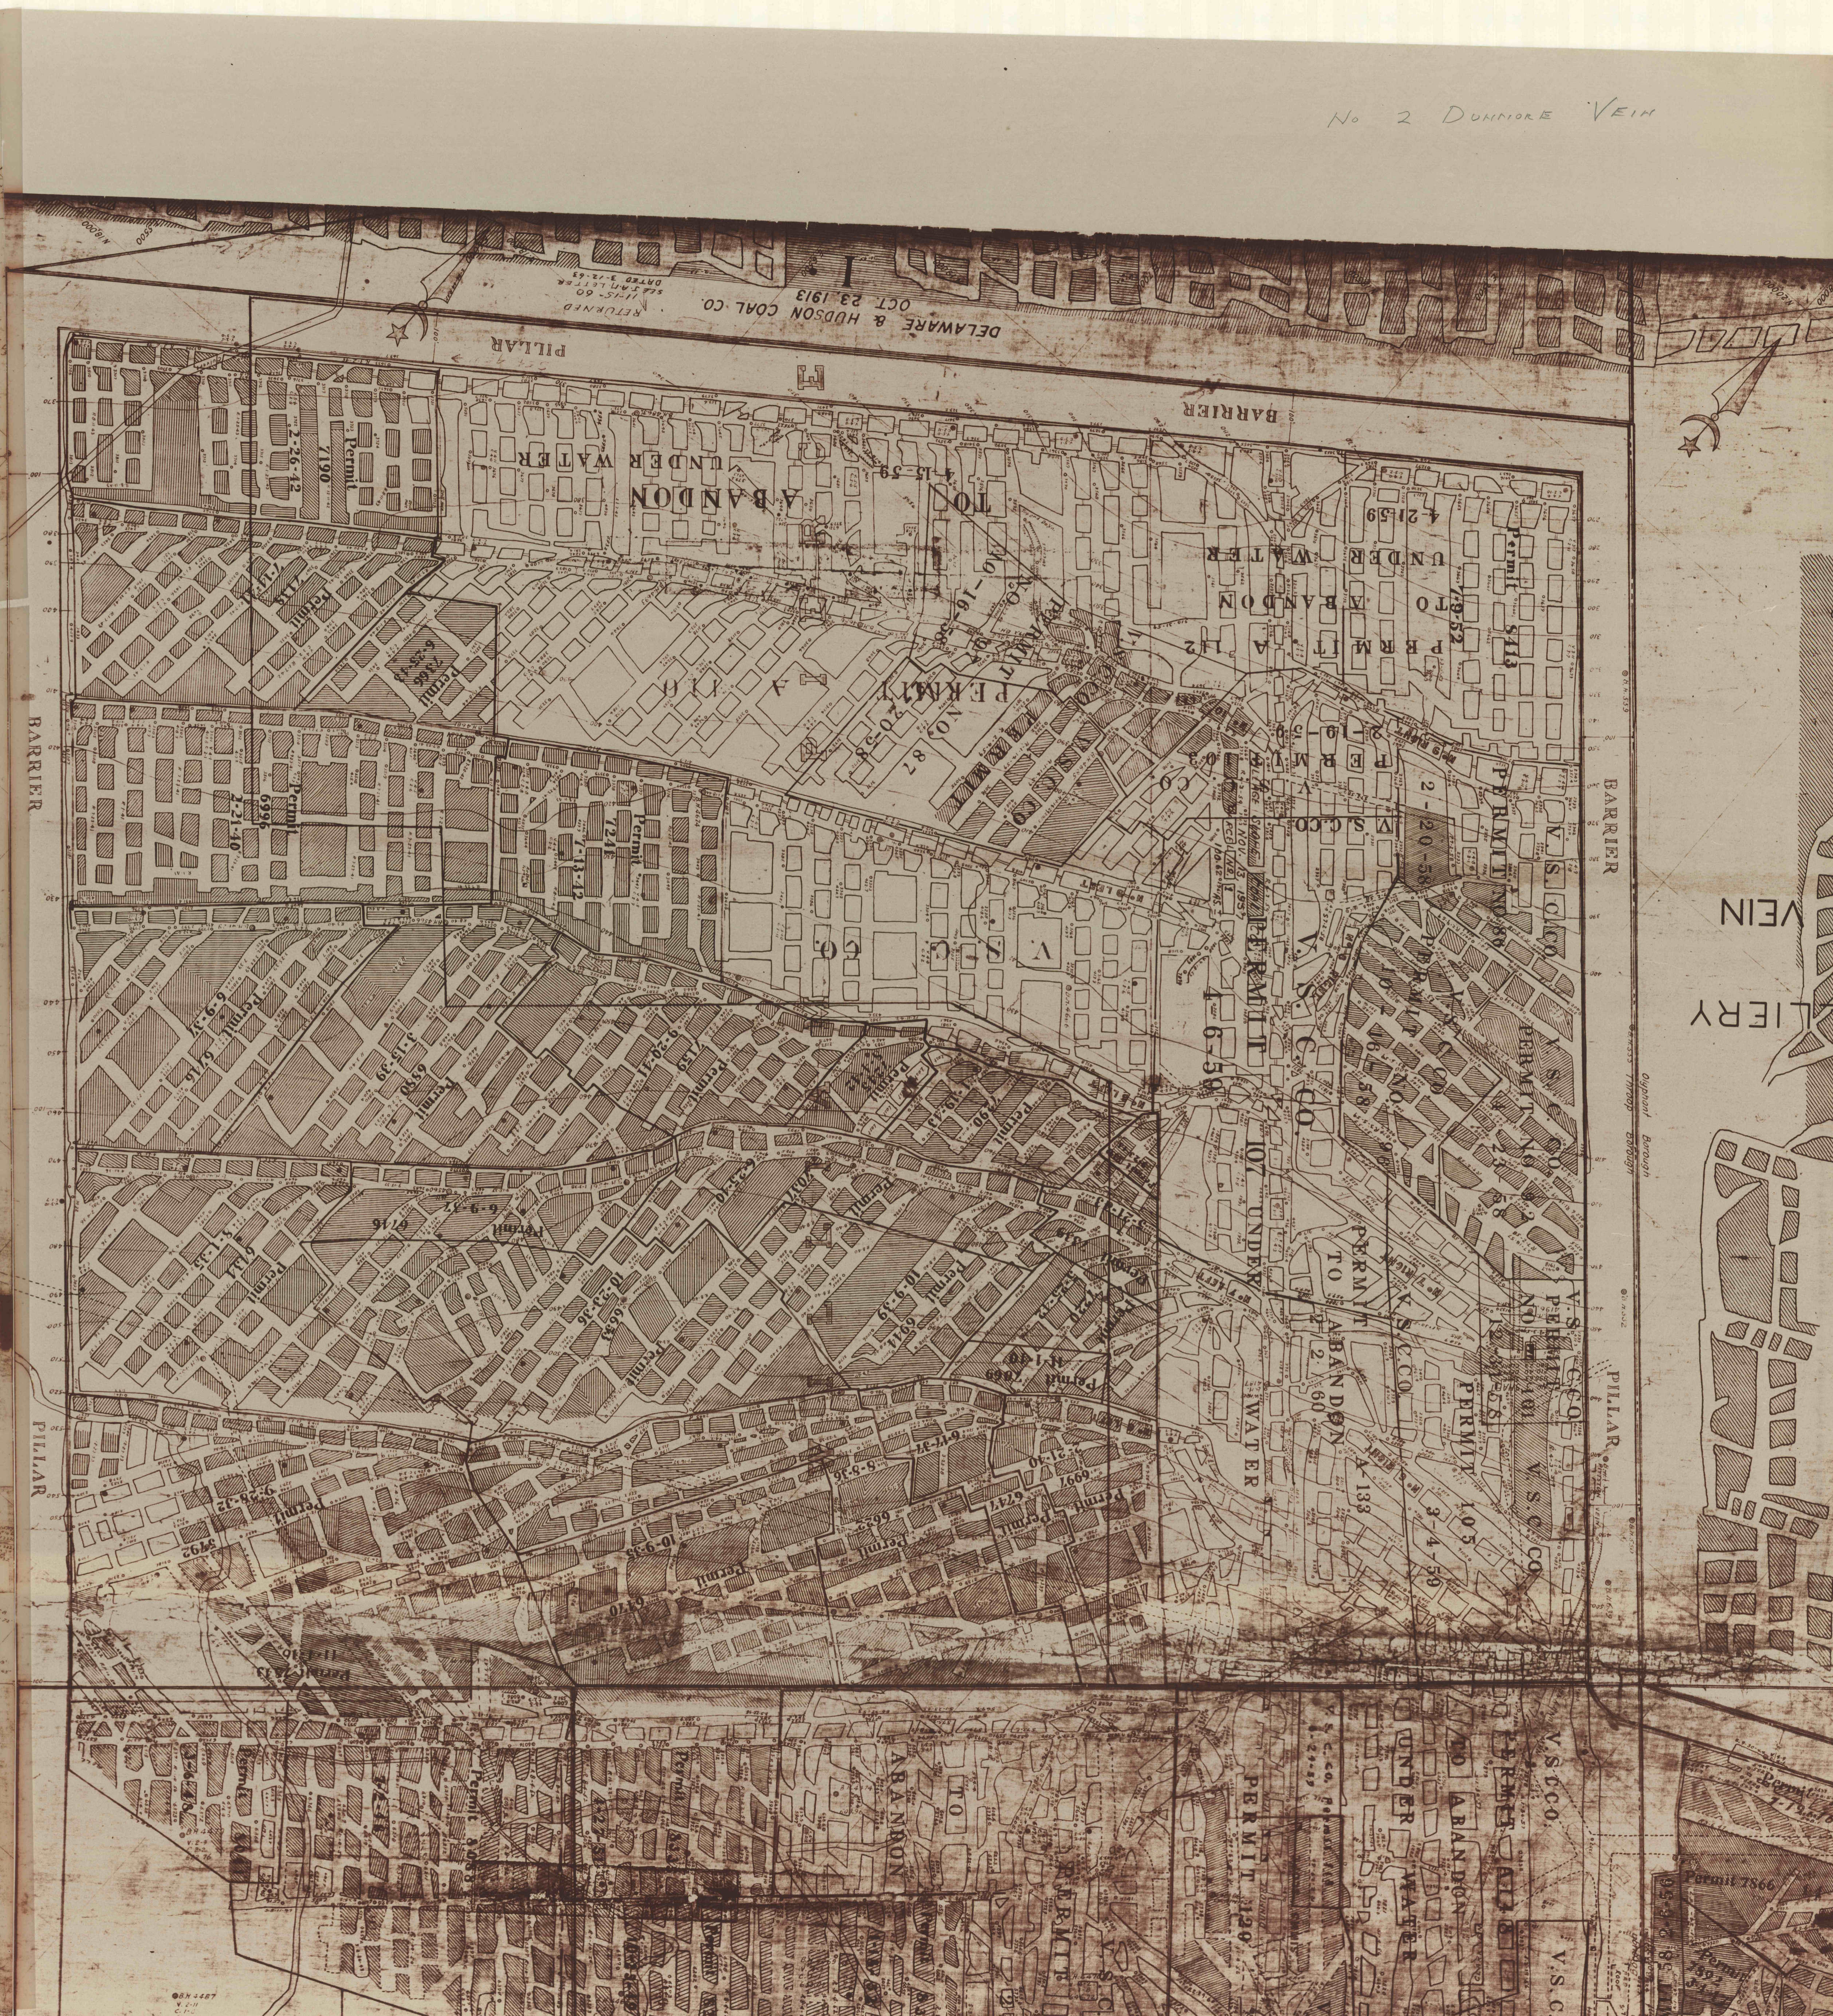

LIERY VEIN

