


OLYPIANT DIVISION
 CROSS SECTION
 21-22

LOOKING S.W. THRU PROPERTY
 IN VICINITY OF VAUGHAN STREET
 SCALE 1"=100'

Underwood Collyery - Perryville Coal Co.
 Penna. C. Co. For T. Thomson Coal Co.
 Div. # 3
 Div. # 2

PAWNEER CO. For T. Thomson Coal Co.
 Div. # 1
 Div. # 2

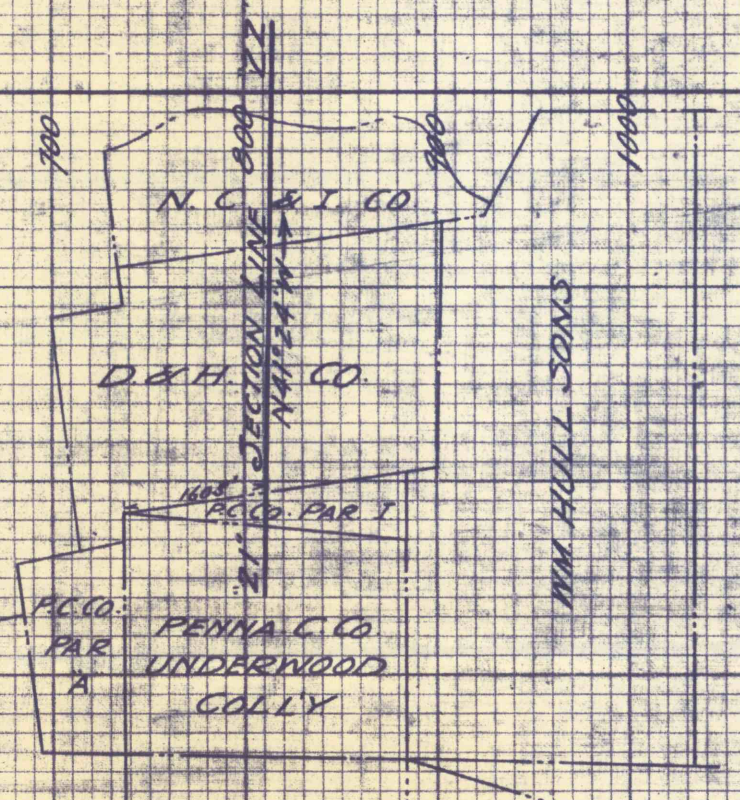

POSTED	BY	POSTED	BY
11-21-32	K.M.		
6-6-34	K.M.		
12-31-34	K.M.		
7-26-35	K.M.		
7-27-36	K.M.		
10-26-37	K.M.		
5-28-41	K.M.		
9-9-42	H.R.		
3-14-54	H.R.		