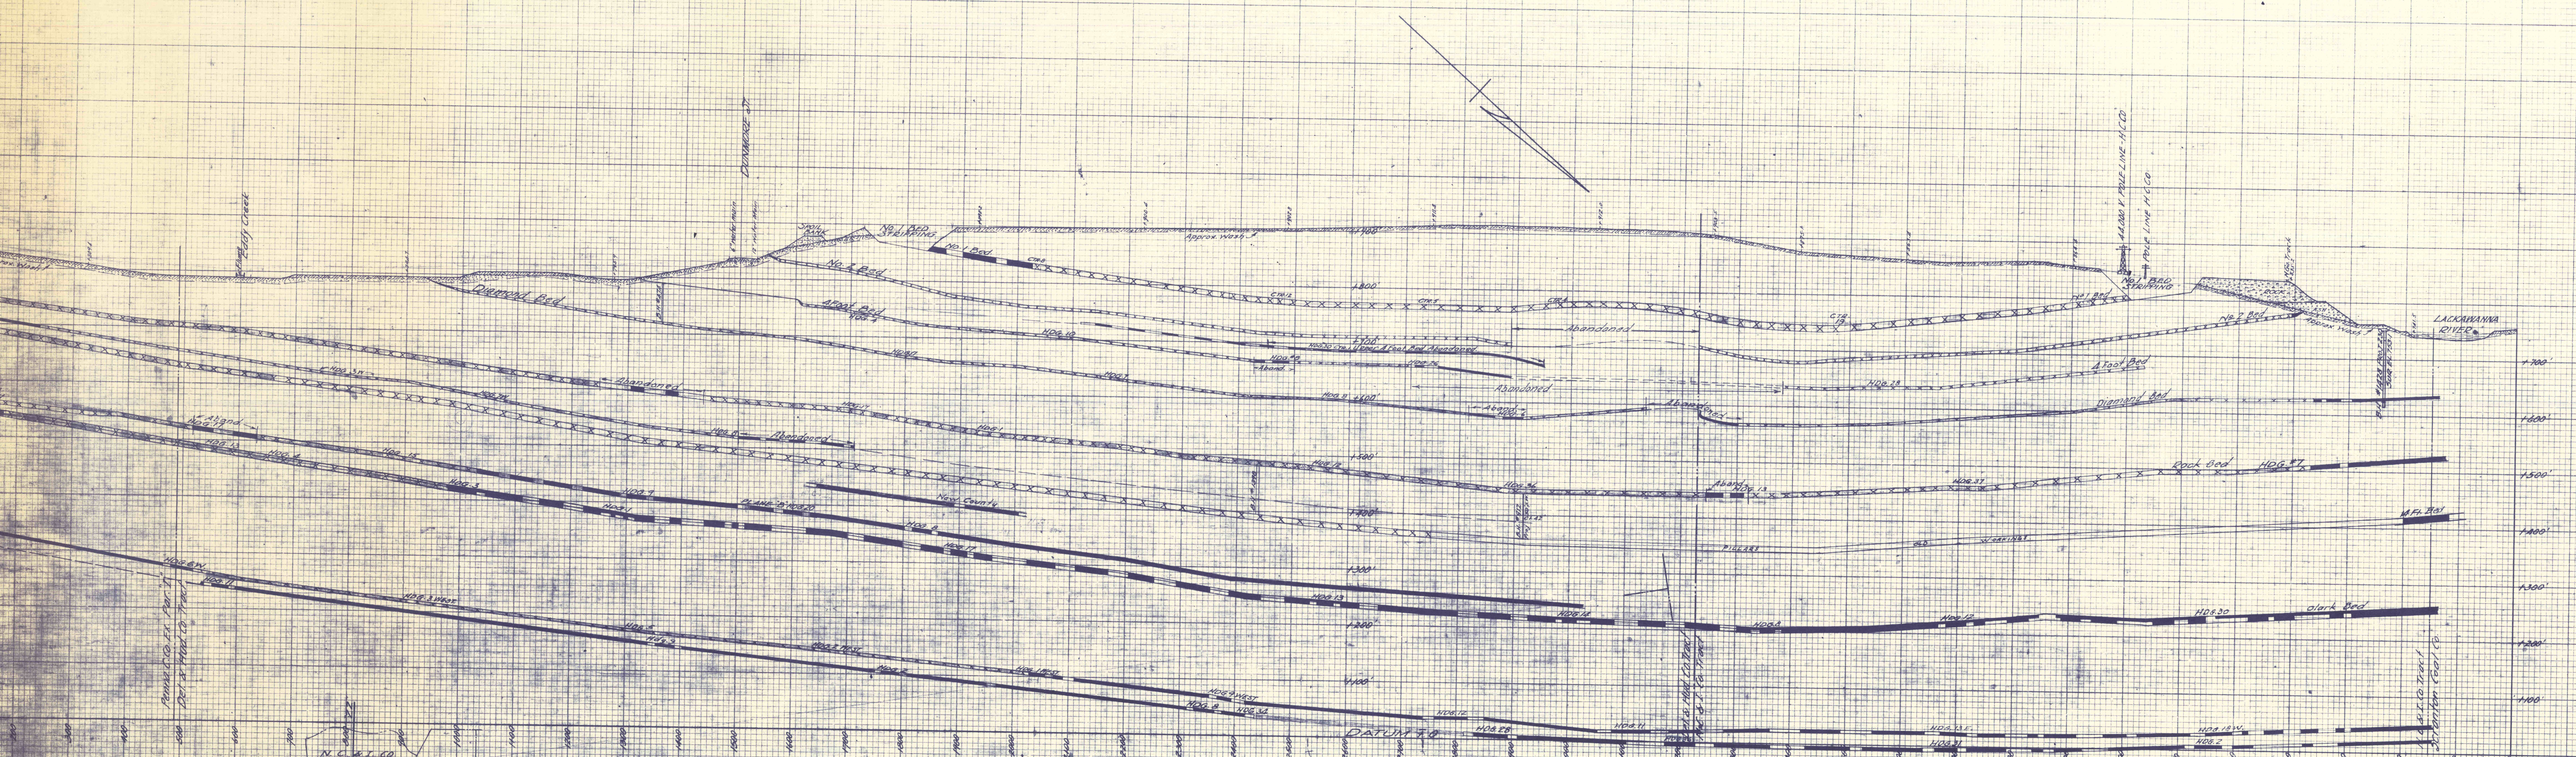

OLYPHANT DIVISION
CROSS SECTION
21-22

LOOKING S.W. THRU PROPERTY
IN VICINITY OF VAUGHAN STREET
SCALE 1"=100' JAN. 27, 1930

POSTED	BY	POSTED	BY
11-21-32	K.M.		
6-16-34	K.M.		
12-21-34	K.M.		
7-26-35	K.M.		
7-27-36	K.M.		
6-26-37	K.M.		
8-22-40	K.M.		
9-9-42	H.E.		
3-10-44	H.E.		