


34.2083+3
35.5.0
5.1.000 7.1.1

EXETER
CLEAR SPRINGS

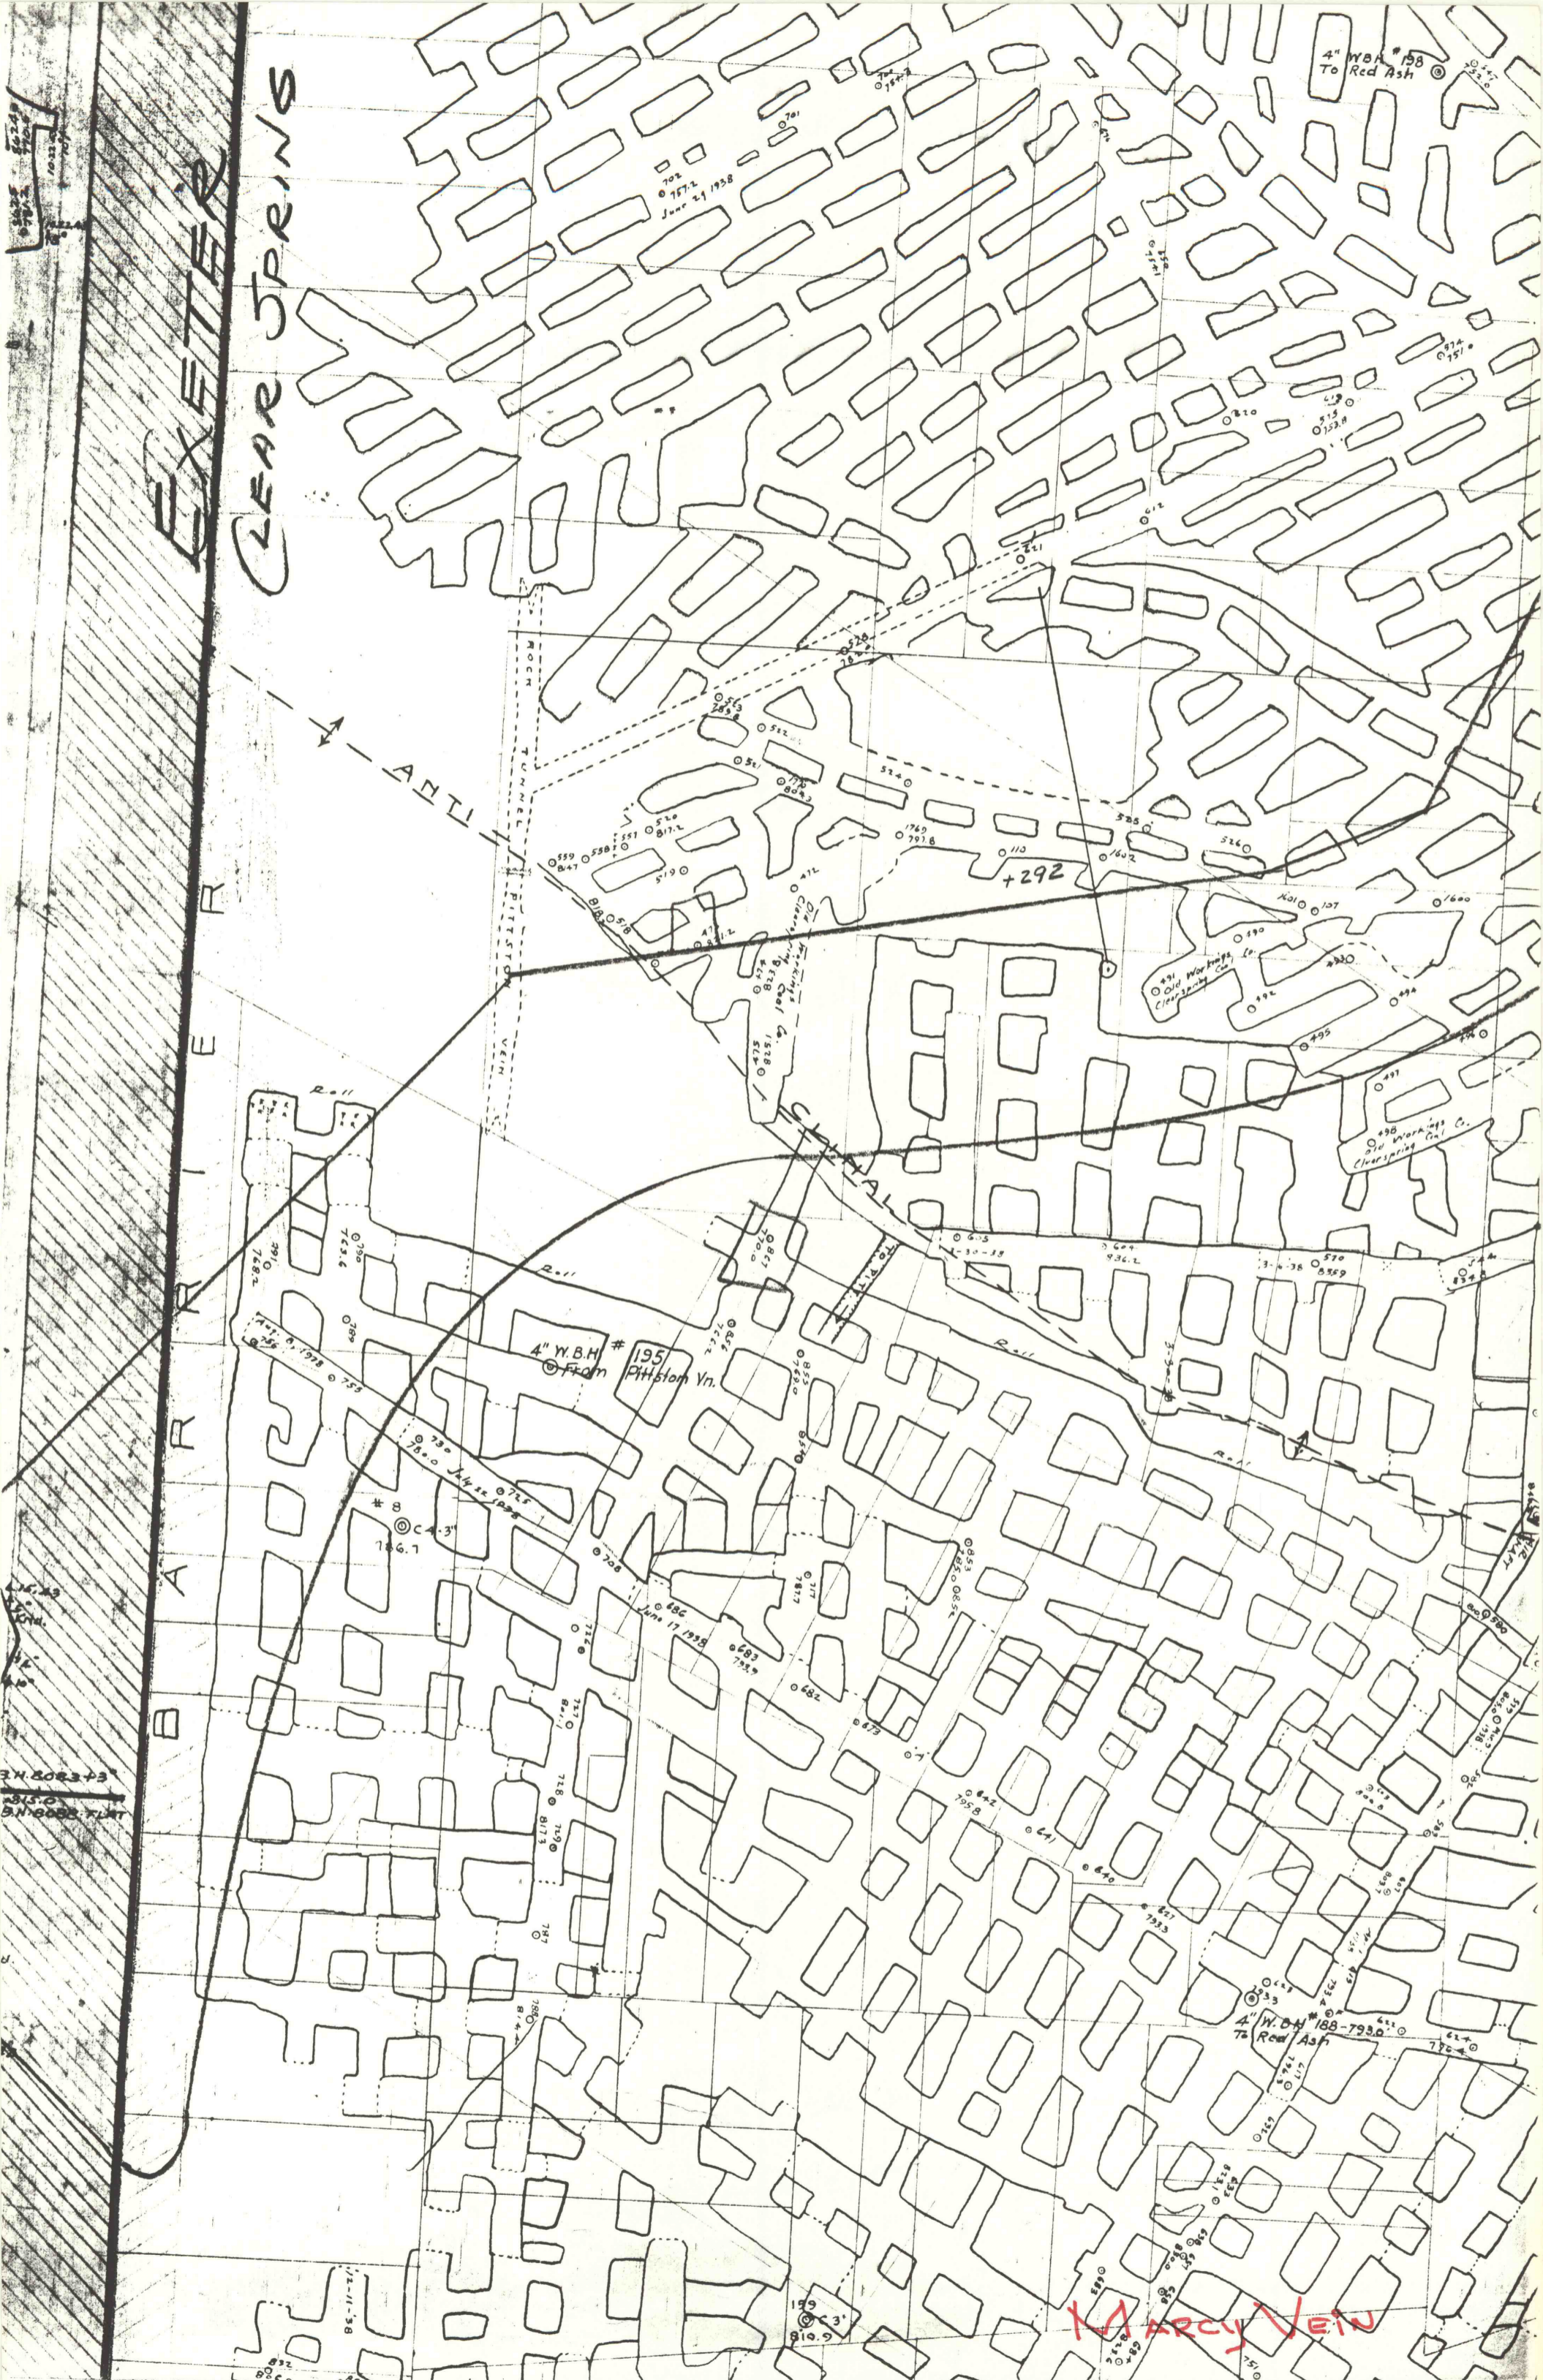

4" W.B.H. # 198
To Red Ash

70x
757.2
June 21 1938

ANTI

+292

4" W.B.H. # 195
Pittston Yn.

4" W.B.H. # 188-793.0
To Red Ash

MARCY VEIN