


AND GREENWOOD

7 J

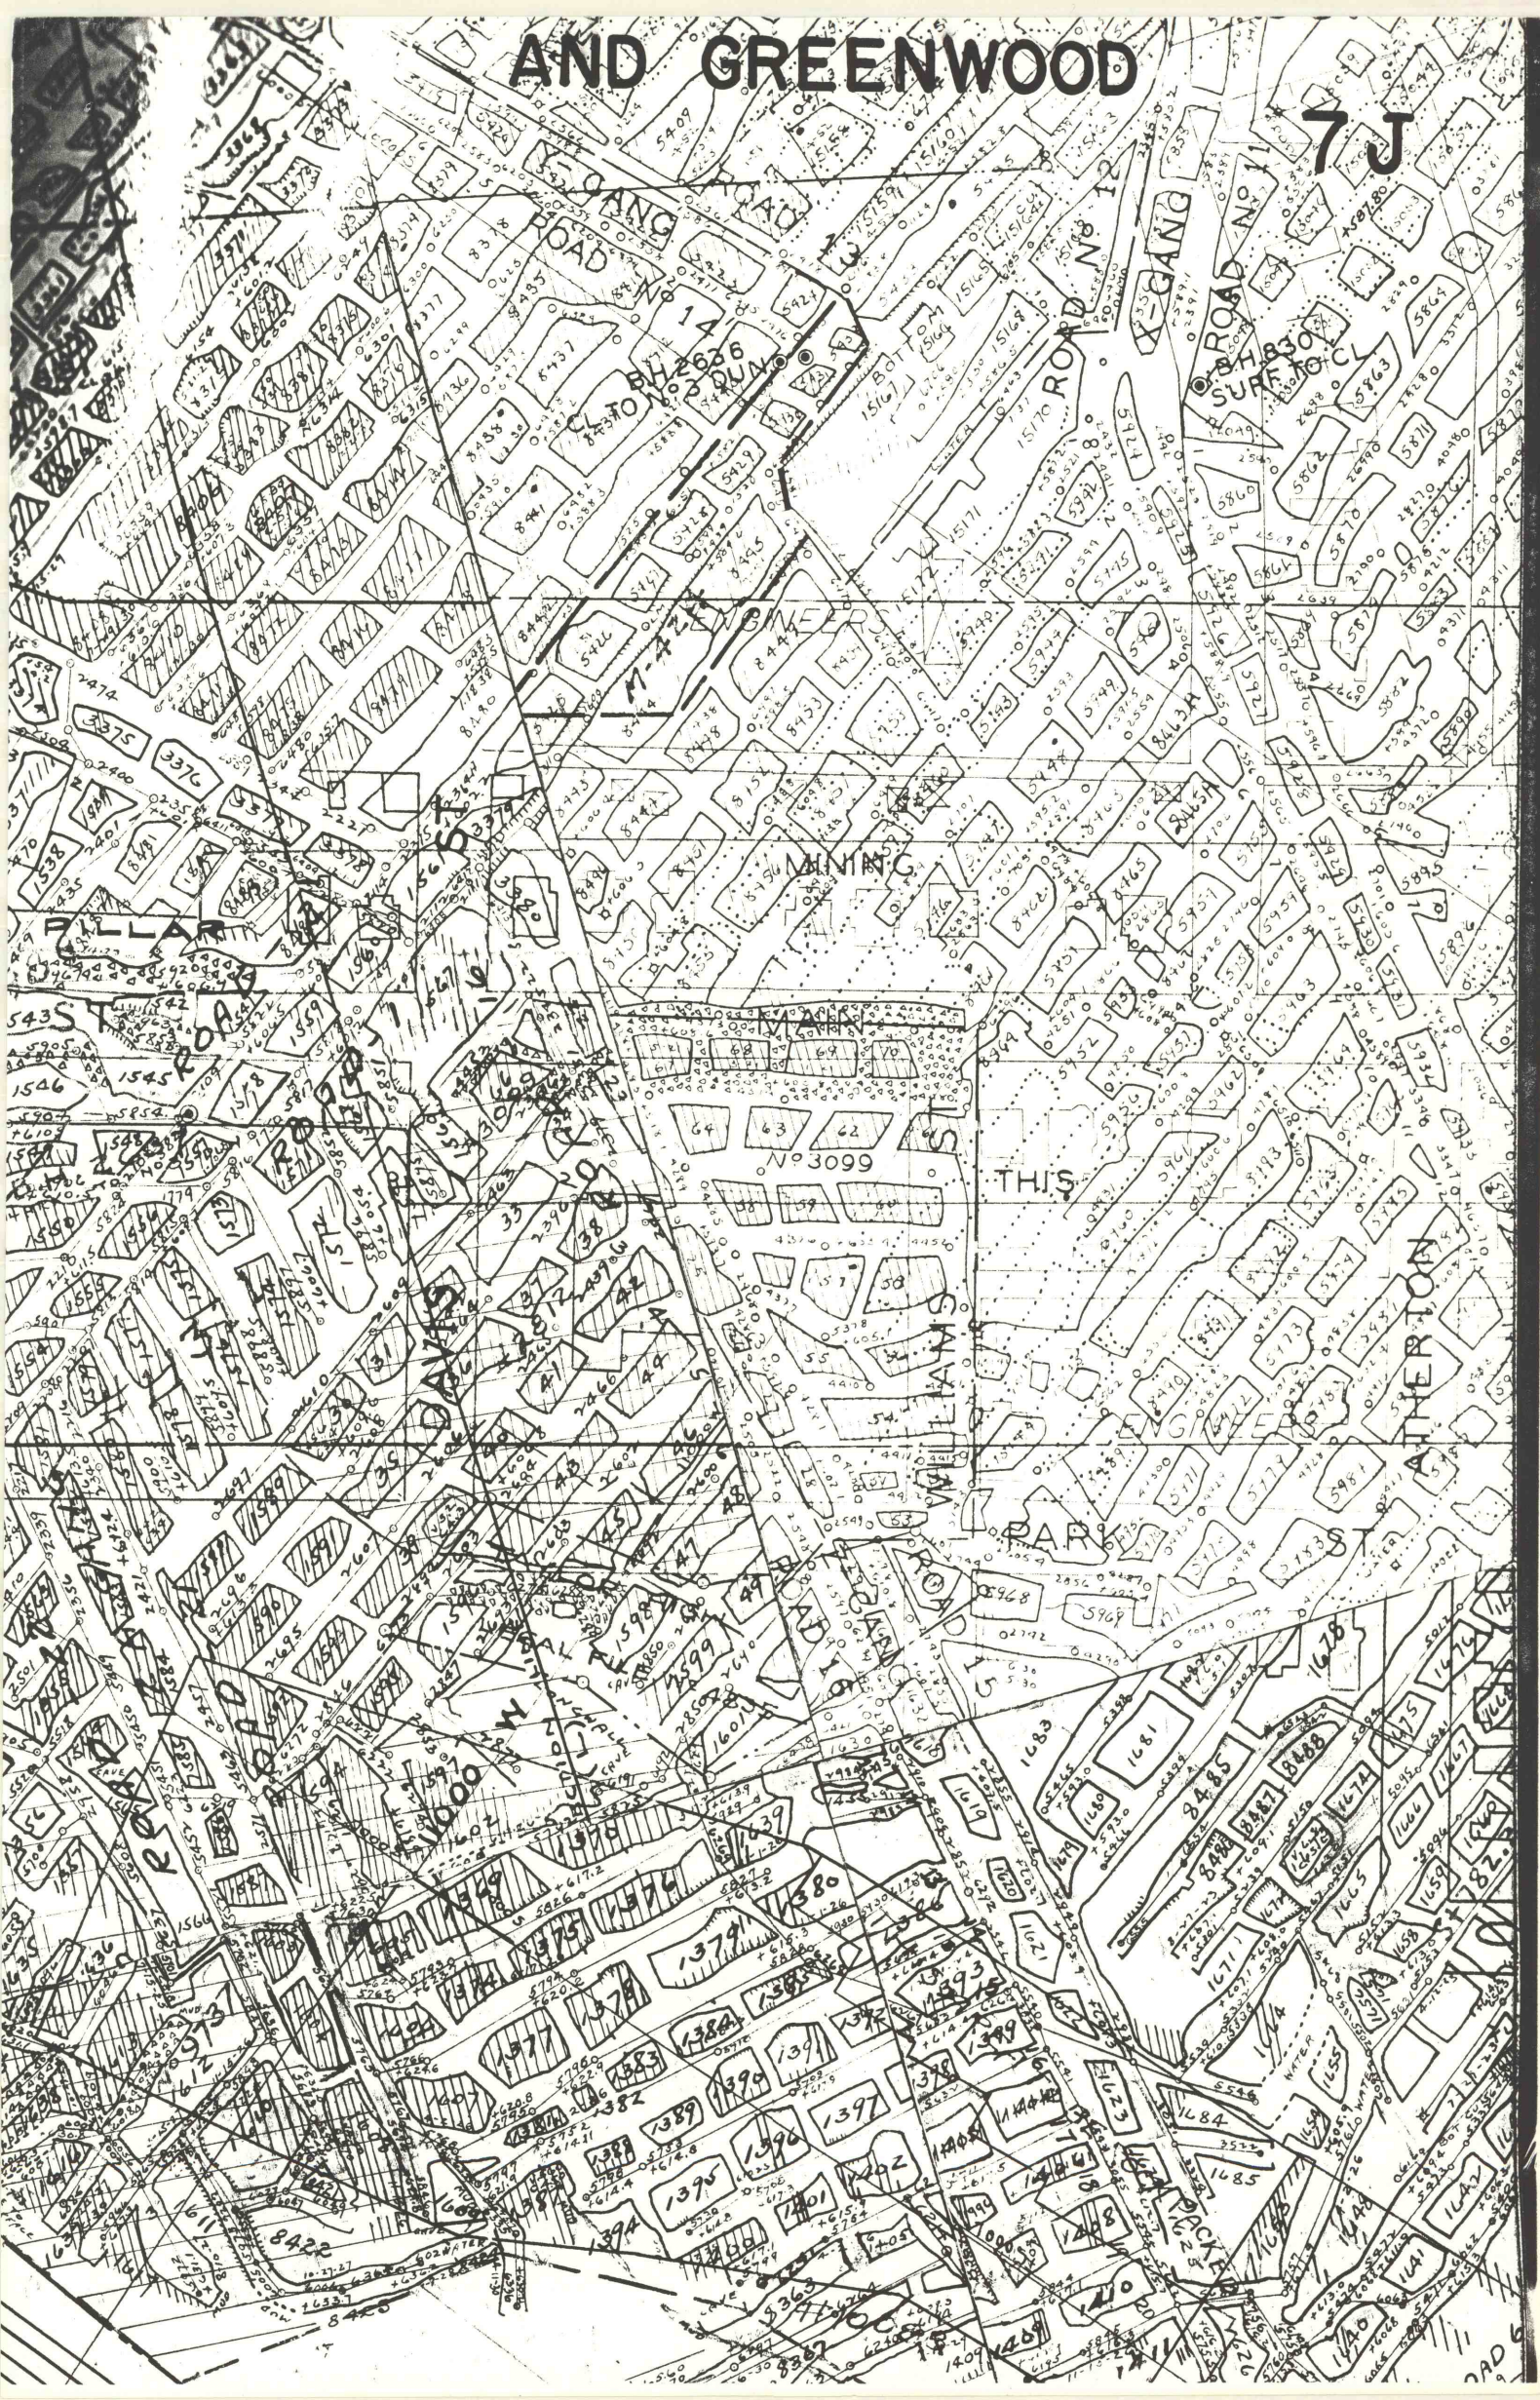

ROAD

ROAD NO 12

ROAD

ROAD NO 1

ROAD

ROAD

MINING

PILLAR

ROAD

THIS

PARK

ST

ROAD

ROAD

ROAD

ROAD

ROAD