


OXFORD SHAFT SECTION
SURFACE
SLIDE - No 7-1

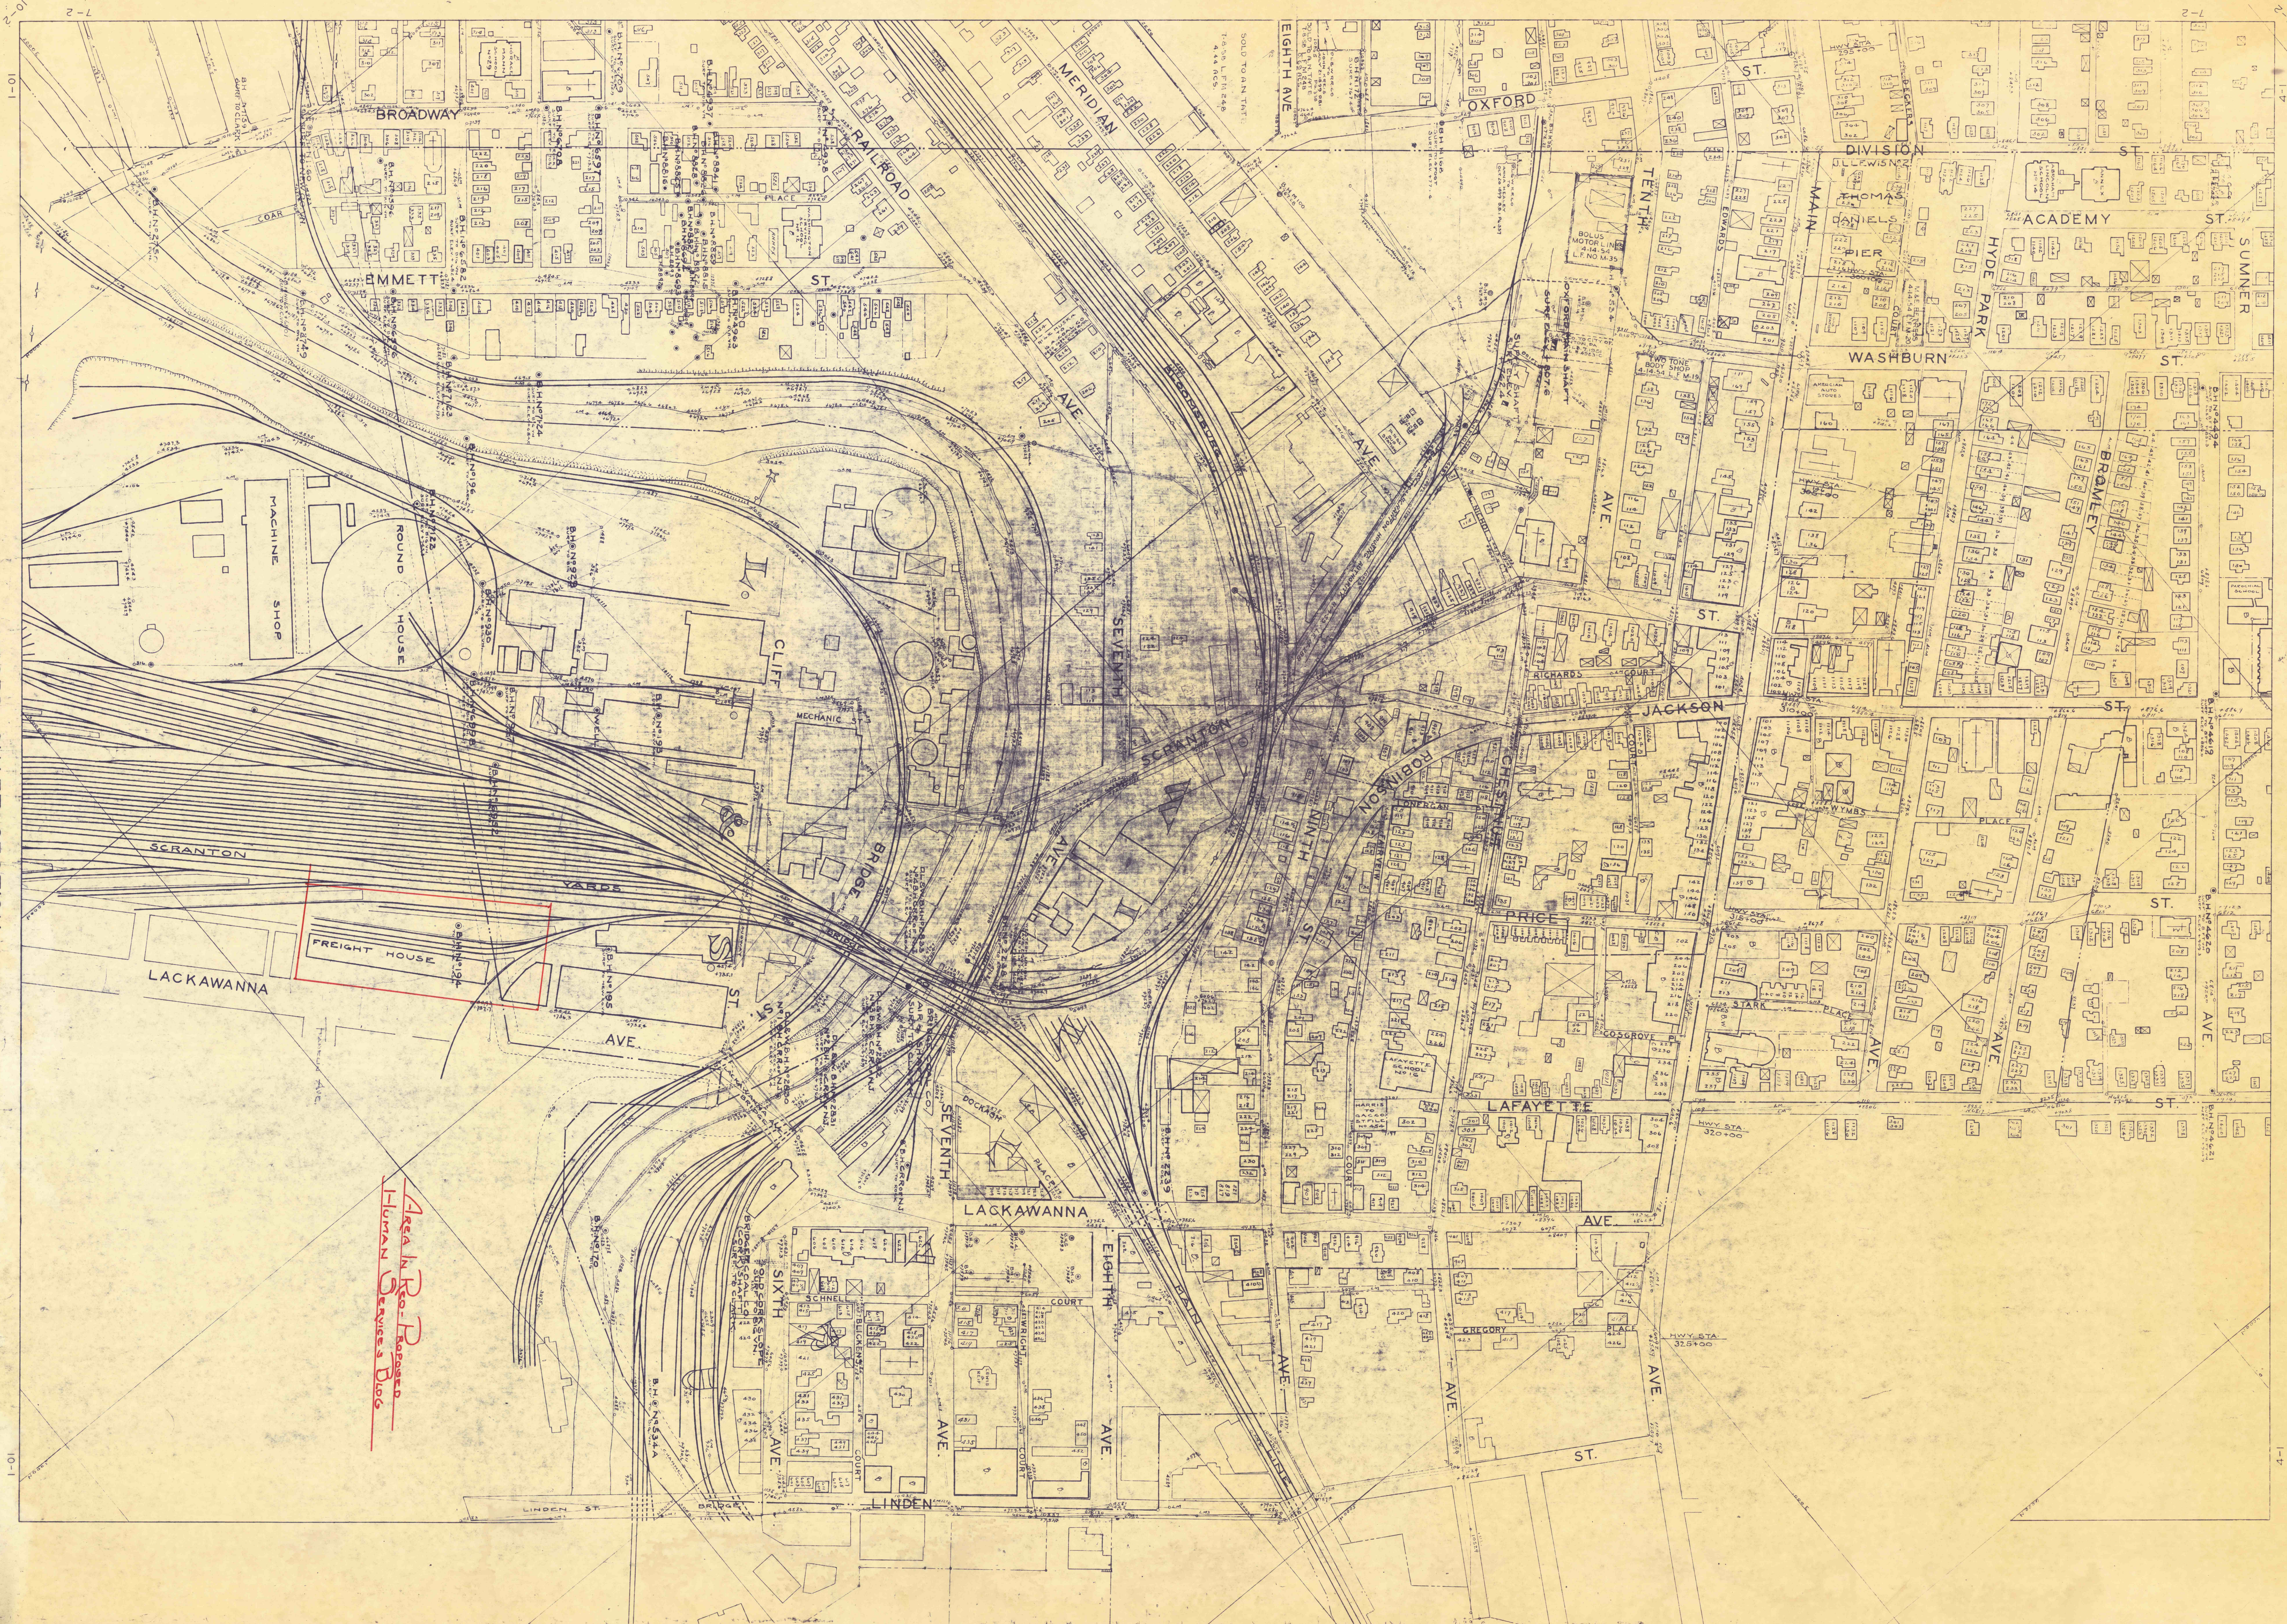

OXFORD SHAFT SECTION
SURFACE
SLIDE - No 7-1

Area in Red -
Human Services Dept

1-10-01-B