


B-10-A-3

NOV 20 1914

- OXFORD SHAFT SECTION -  
No 1 DUNMORE VEIN  
SLIDE-7-1

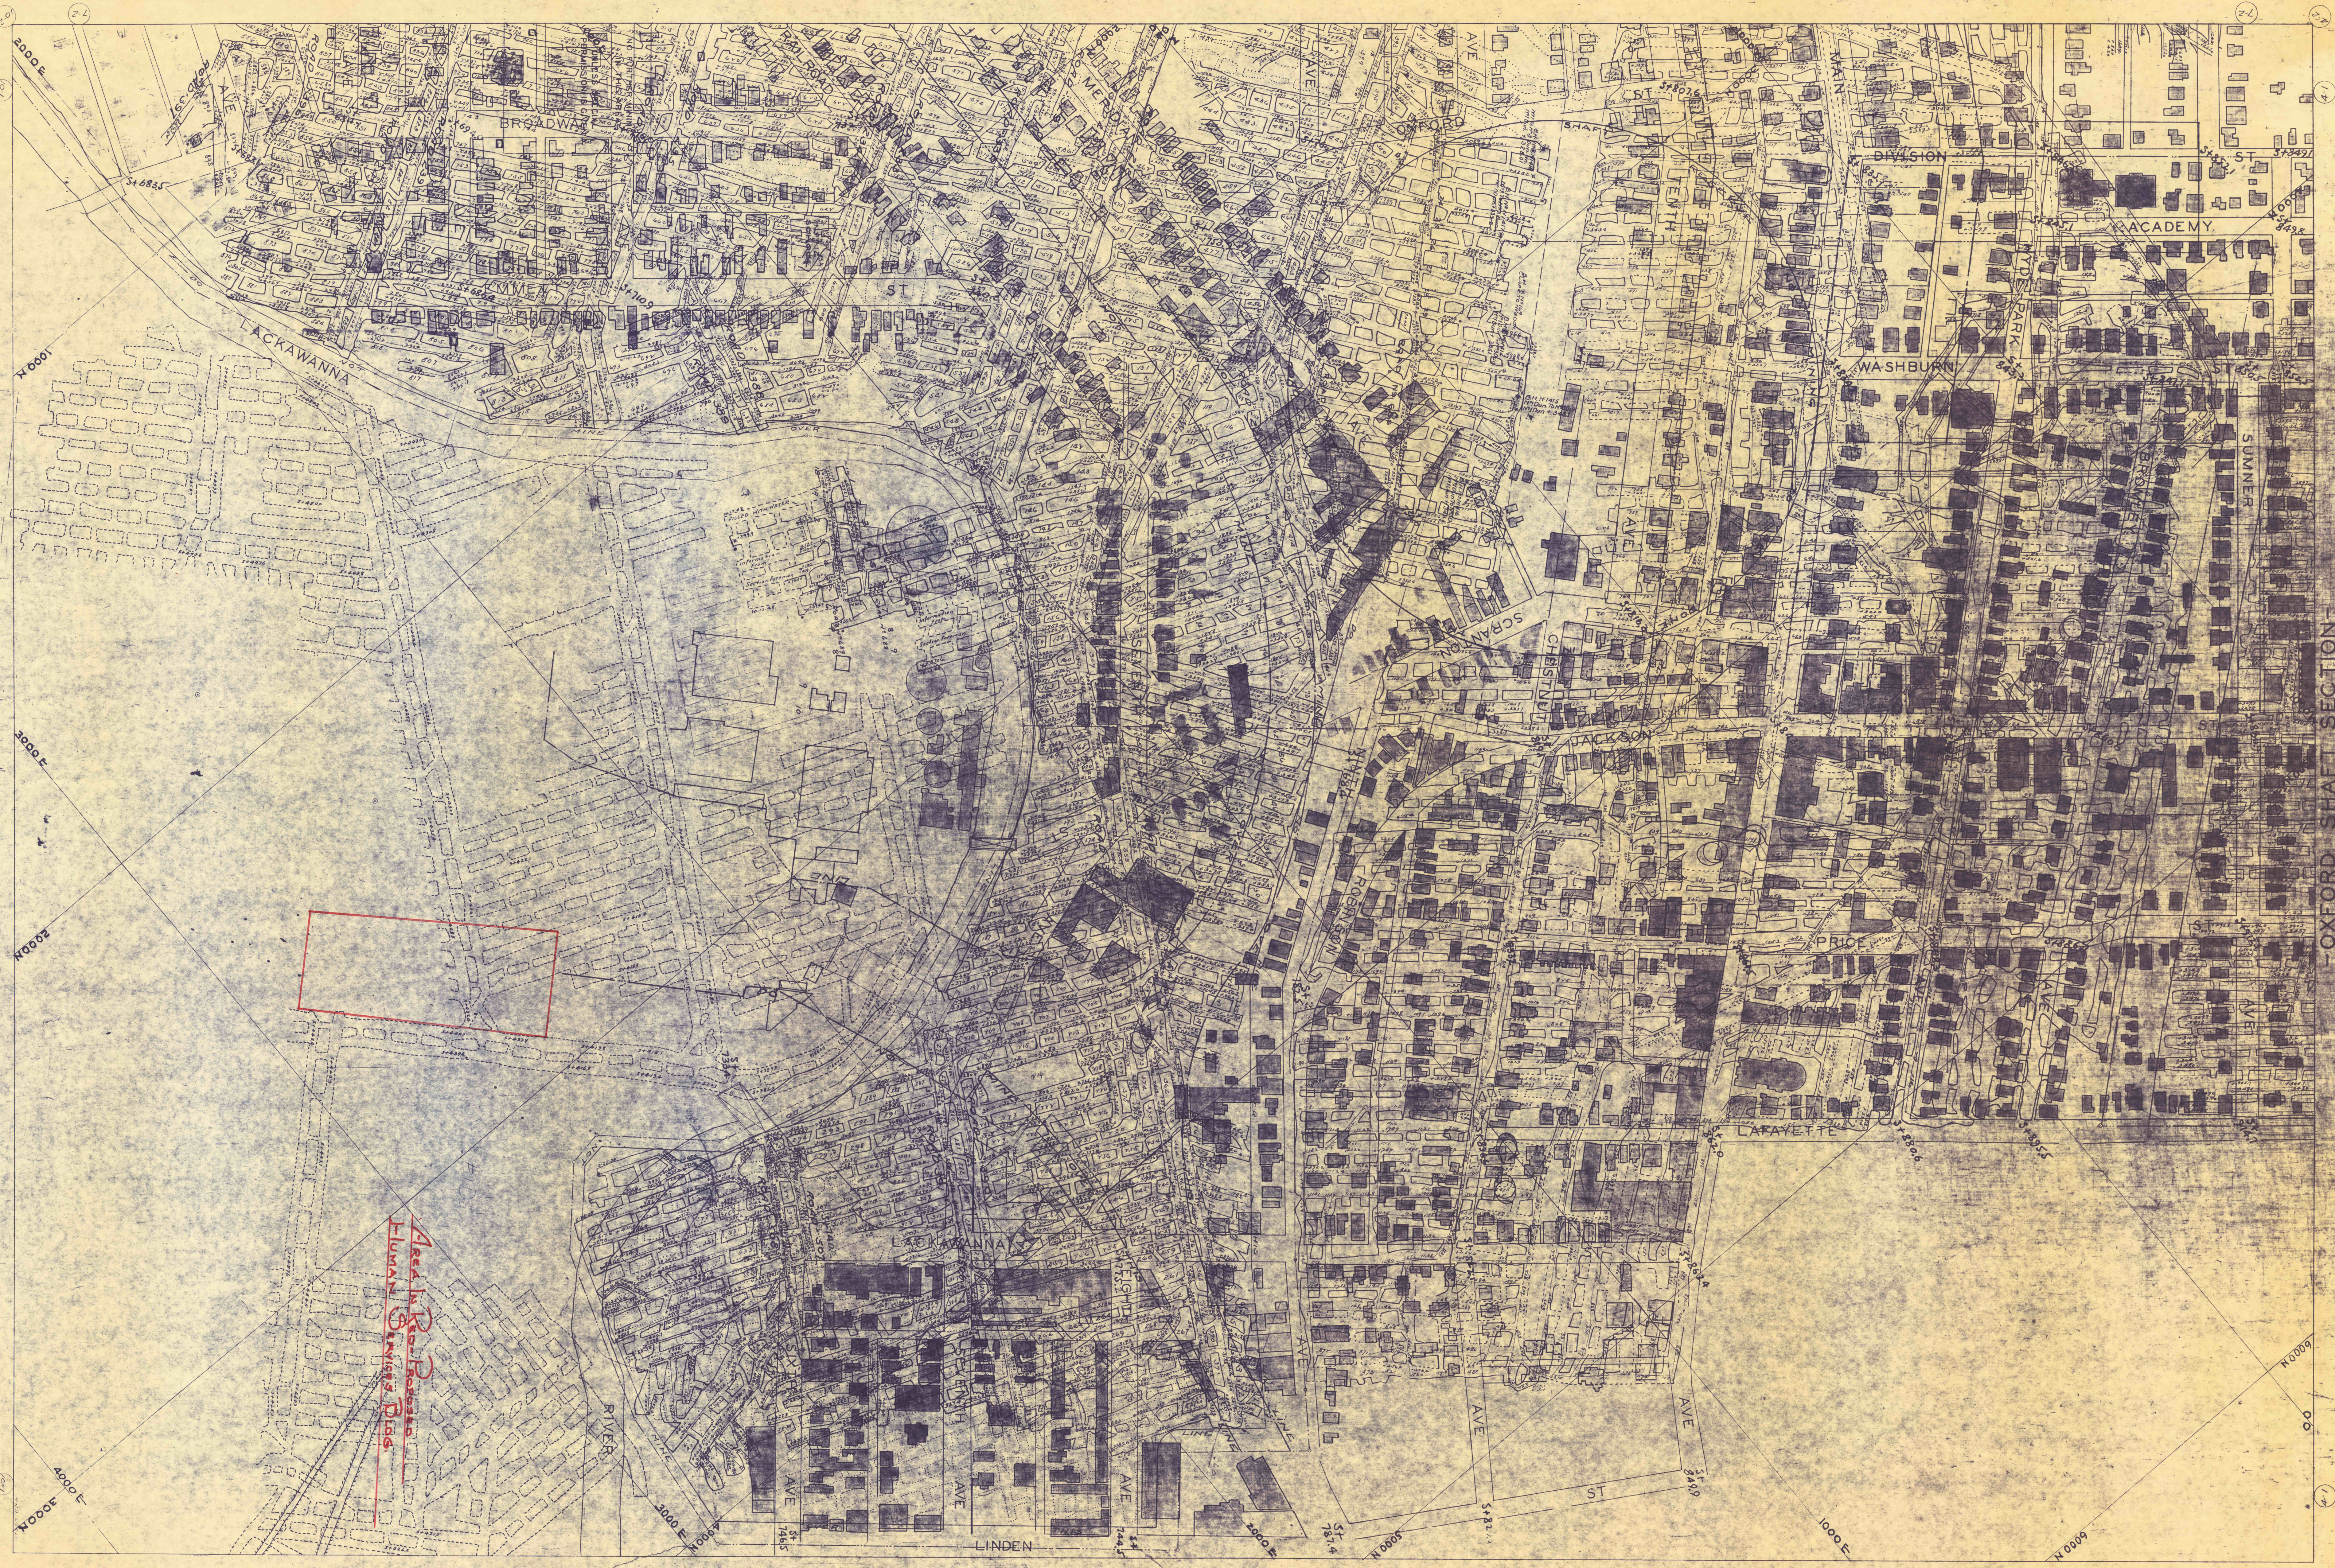

*Area in Red Box  
Linden Ave  
Price St*

- OXFORD SHAFT SECTION -  
No 1 DUNMORE VEIN  
SLIDE-7-1