


PROJECT

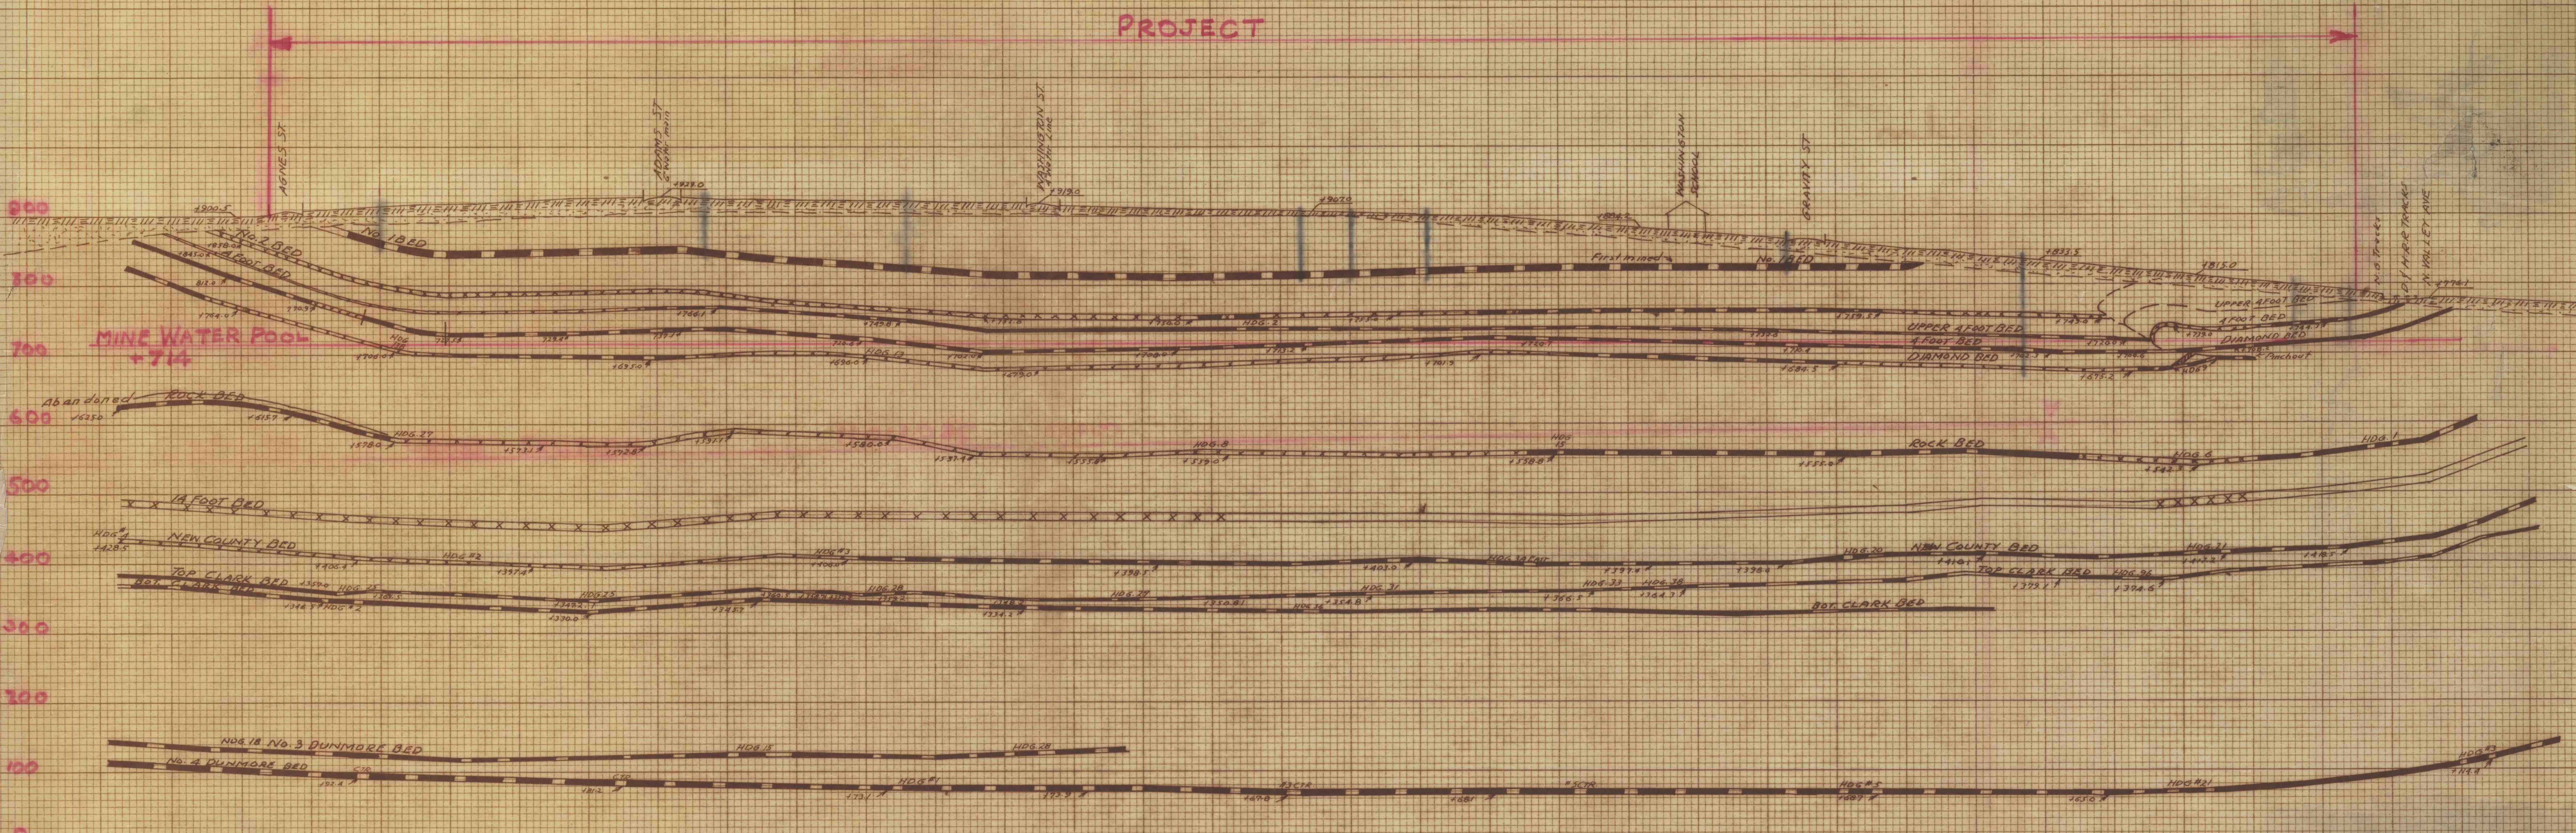

OLYPHANT DIVISION
CROSS SECTION

A-B

THRU COAL MEASURES LOOKING S. W.
BELL LOT TO LACKA COAL CO. LTD.

SCALE 1"=100'