


PROJECT

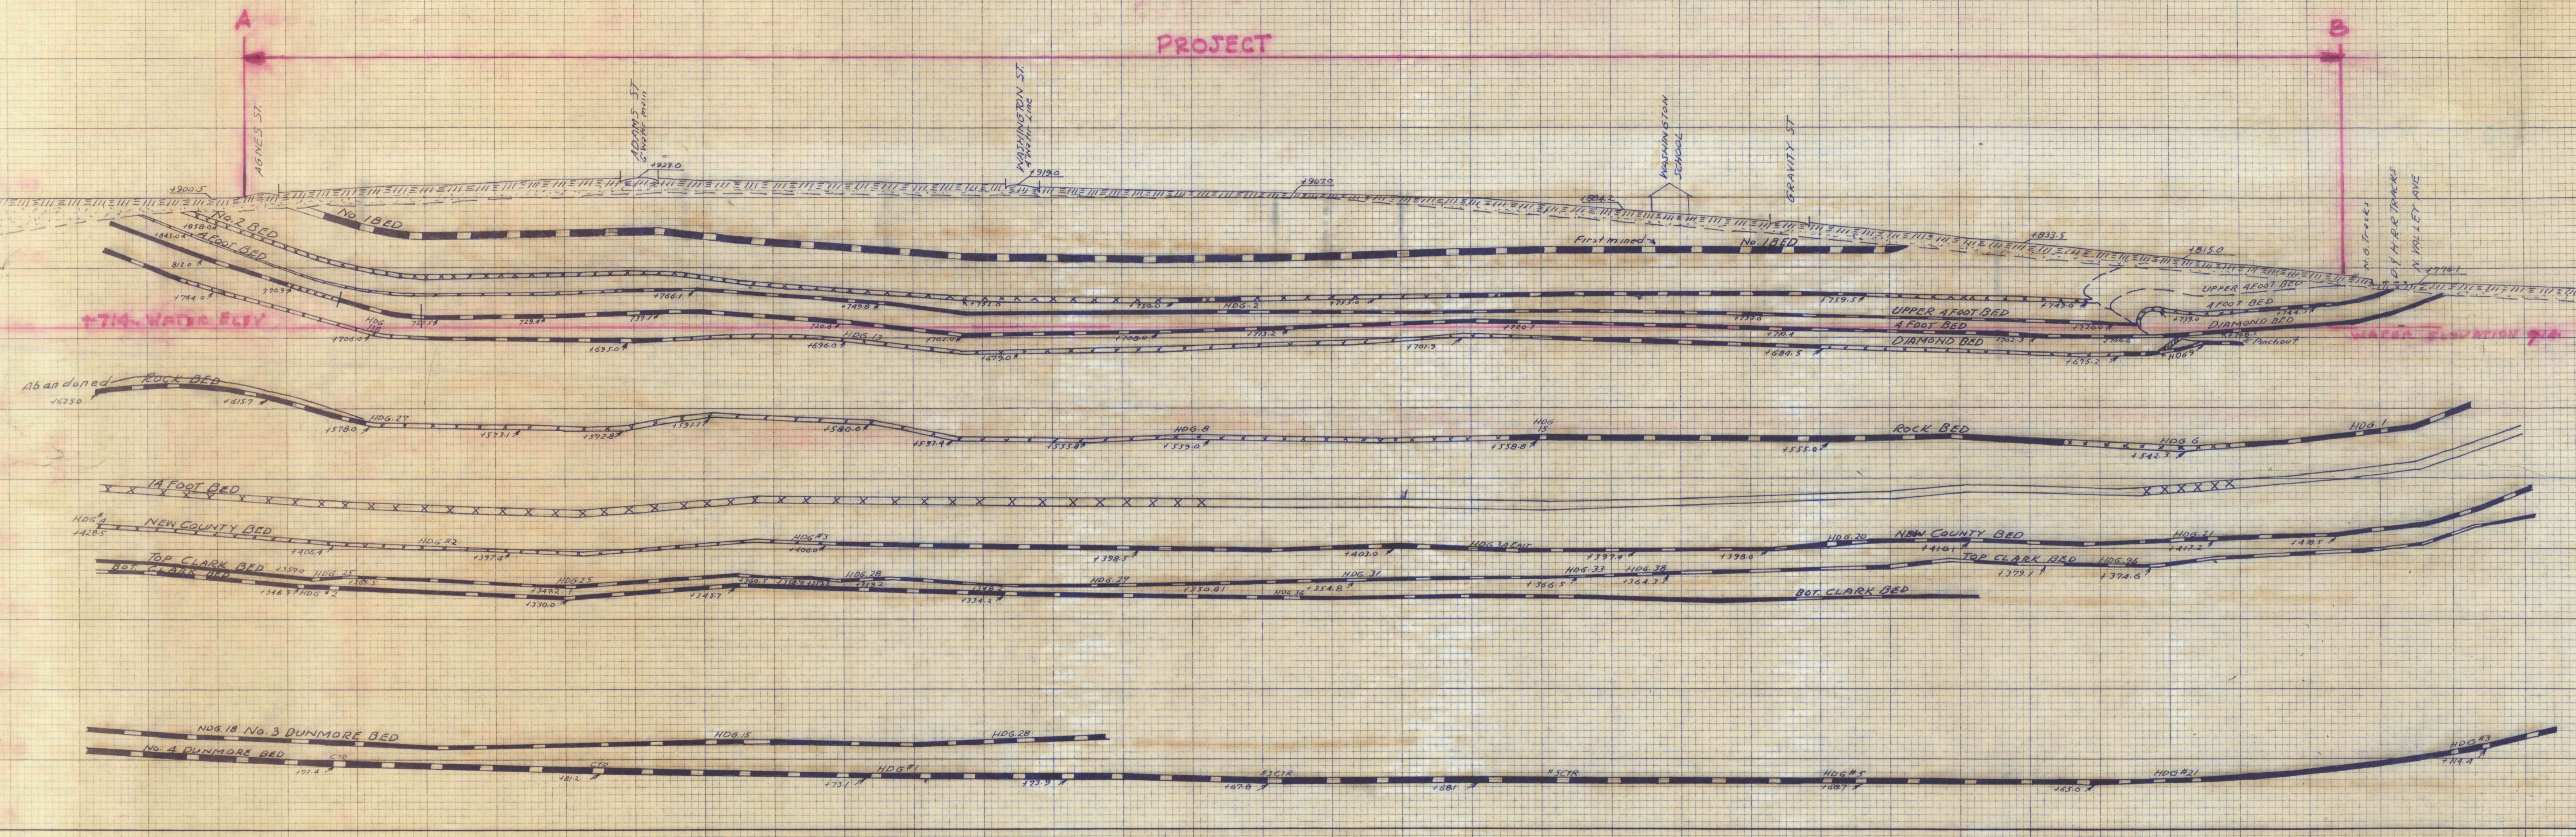

OLYPHANT DIVISION  
CROSS SECTION

A-B

THRU COAL MEASURES LOOKING S.W.  
BELL LOT TO LACKA COAL CO. LTD.

SCALE 1"=100'