





GEORGE

LEE

WARRAN

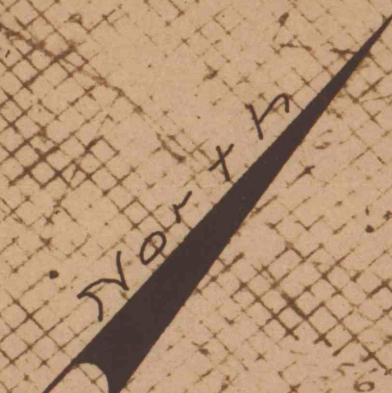

-  COMPLETED BOREHOLE
-  DELETED BOREHOLE

 3-3-82 AS DRILLED

THE LAND AND WATER CONSERVATION AND RECLAMATION ACT  
 SUBSIDENCE PROJECT NO. S.L. -322  
 SURFACE MAP SHOWING  
 BOREHOLE LOCATIONS  
 COTTAGE STREET AND GREENFIELD ROAD SUBSIDENCE AREA  
 CITY OF CARBONDALE  
 LACKAWANNA COUNTY, PENNSYLVANIA  
 SCALE: 1" = 100' APRIL 1972  
 PENNSYLVANIA DEPARTMENT OF ENVIRONMENTAL RESOURCES

EXHIBIT "A"