
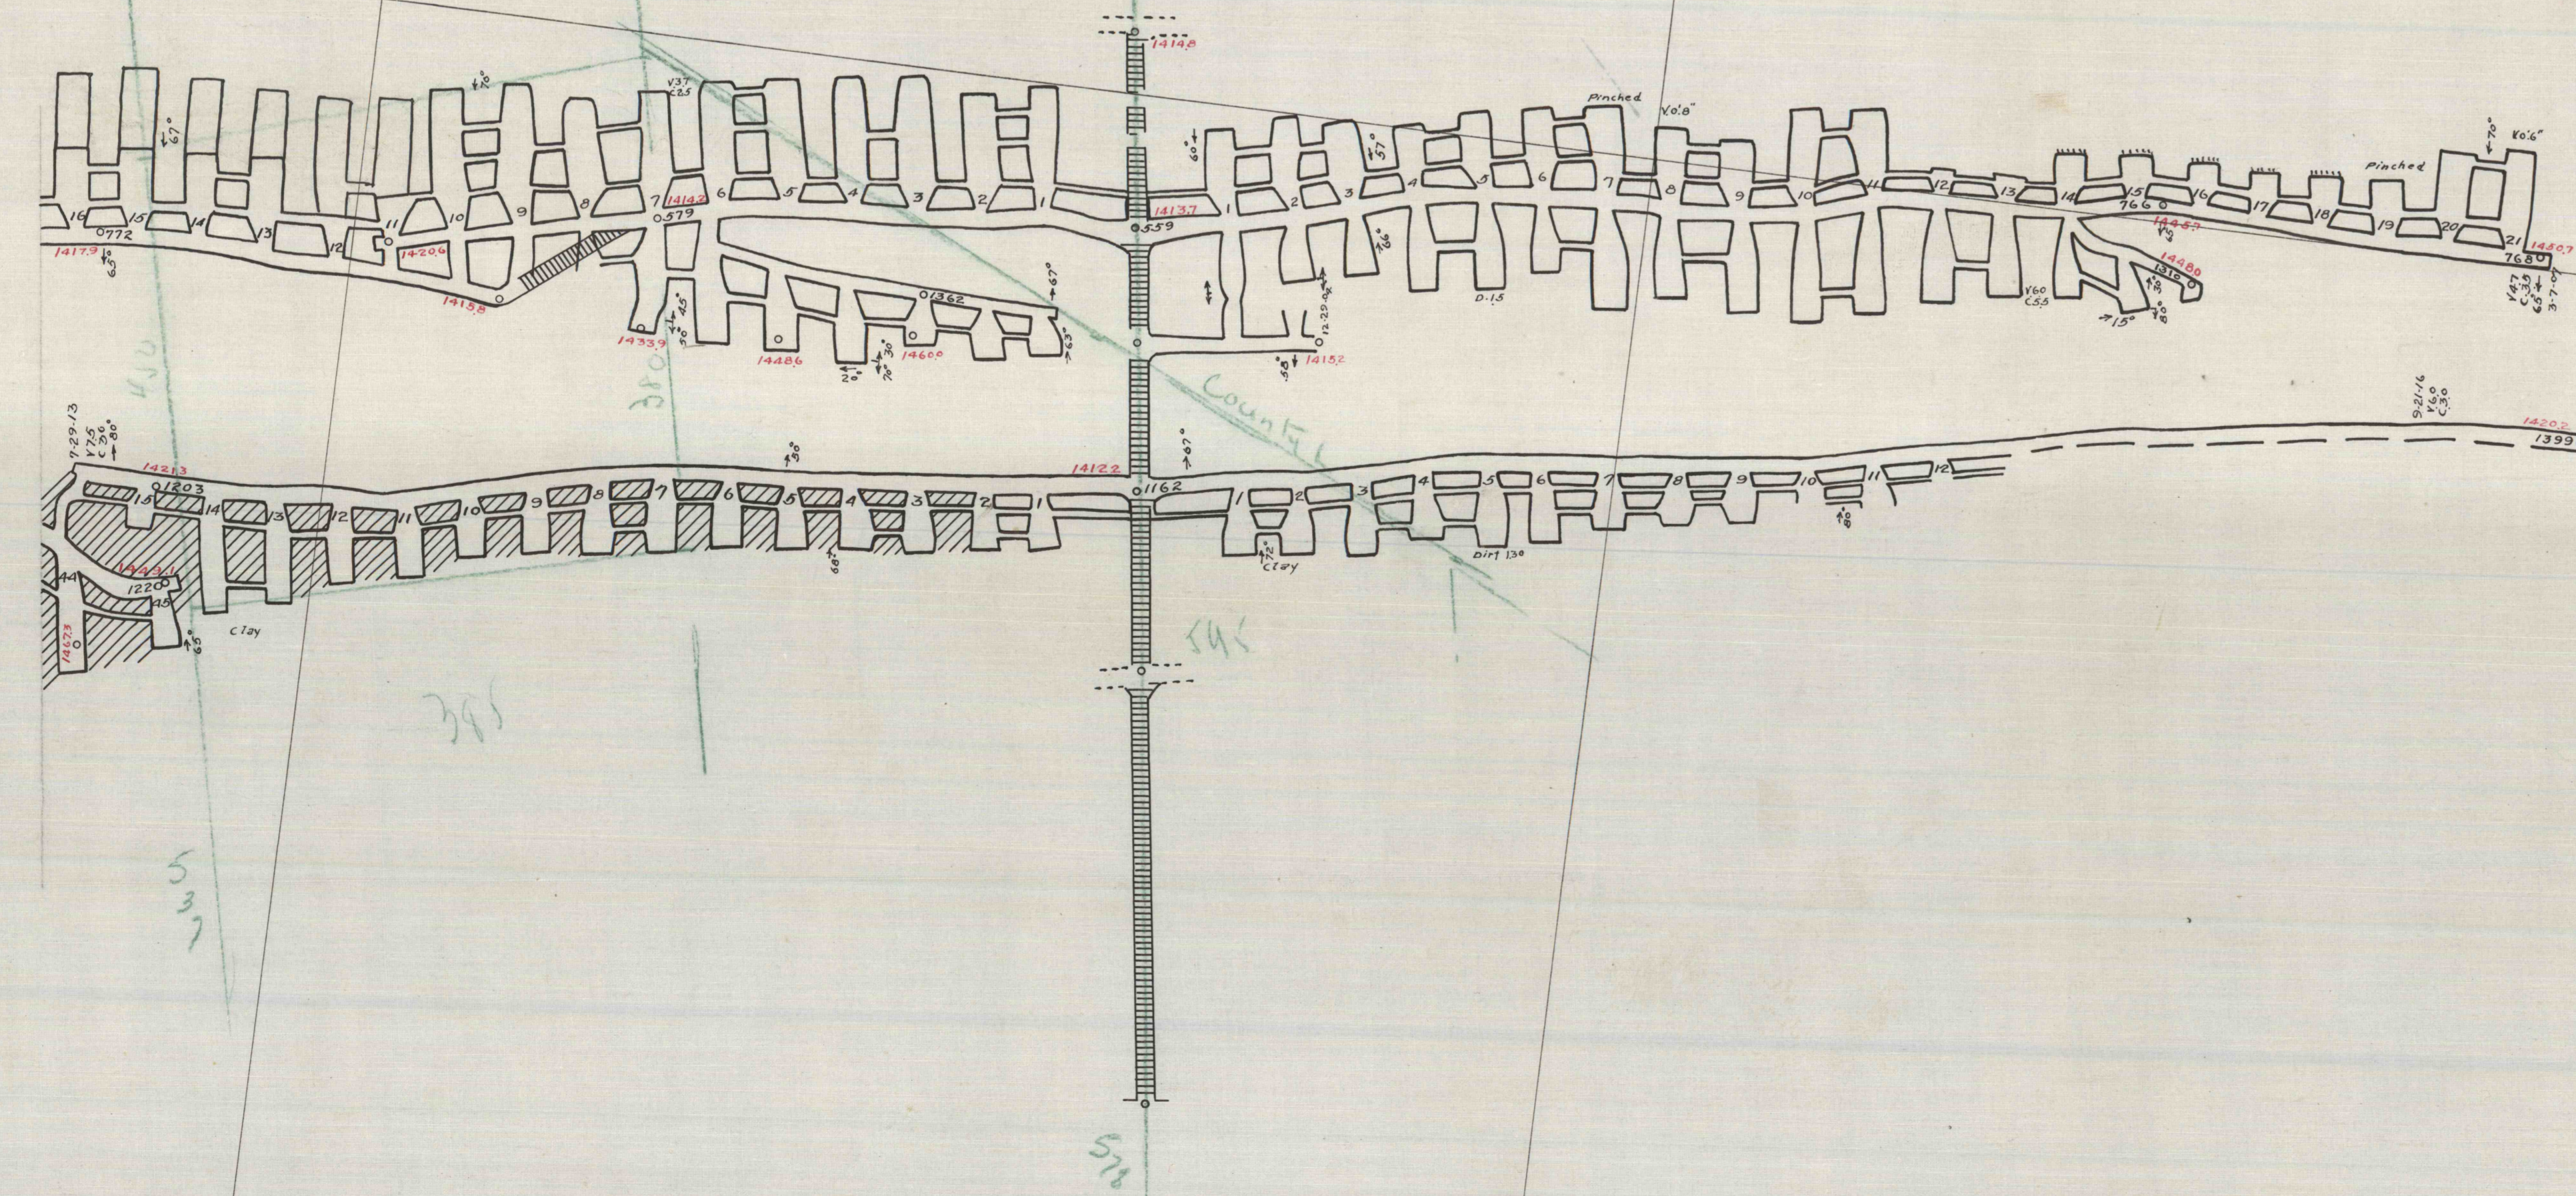



 

