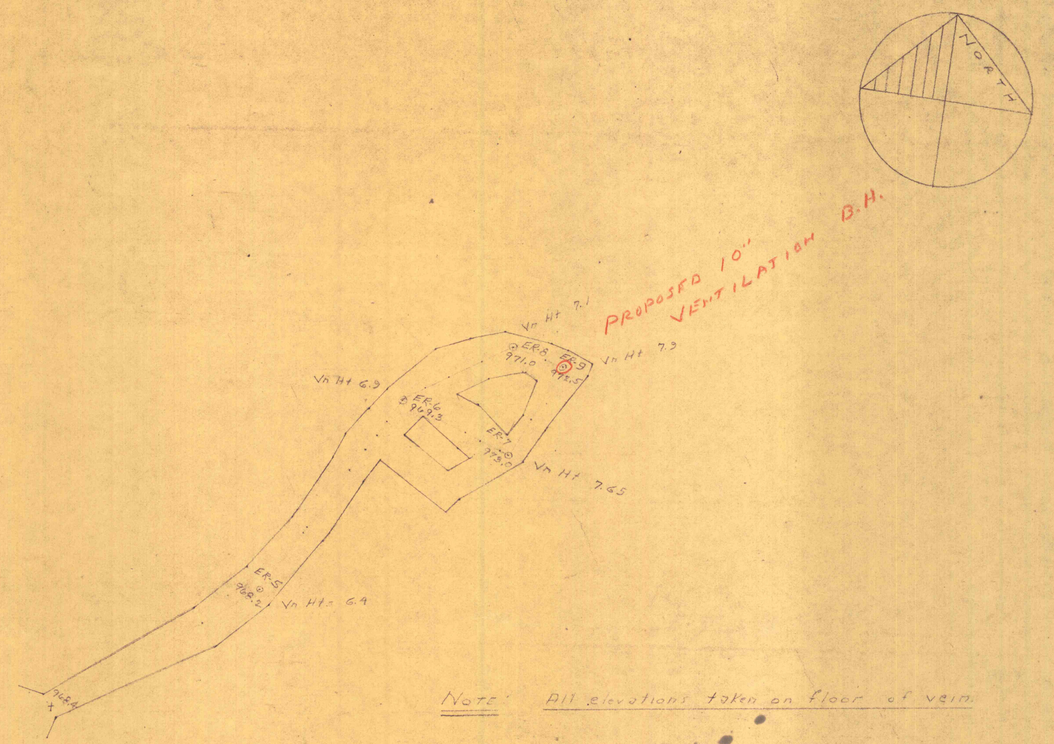

Note: All elevations taken on floor of vein.

VEIN MAP

BROOKS MINE

SCRANTON PENNA

SCALE 1" = 20' 3.22.76