


MAMMOTH/SKID MORE
VEINS
1" = 200'

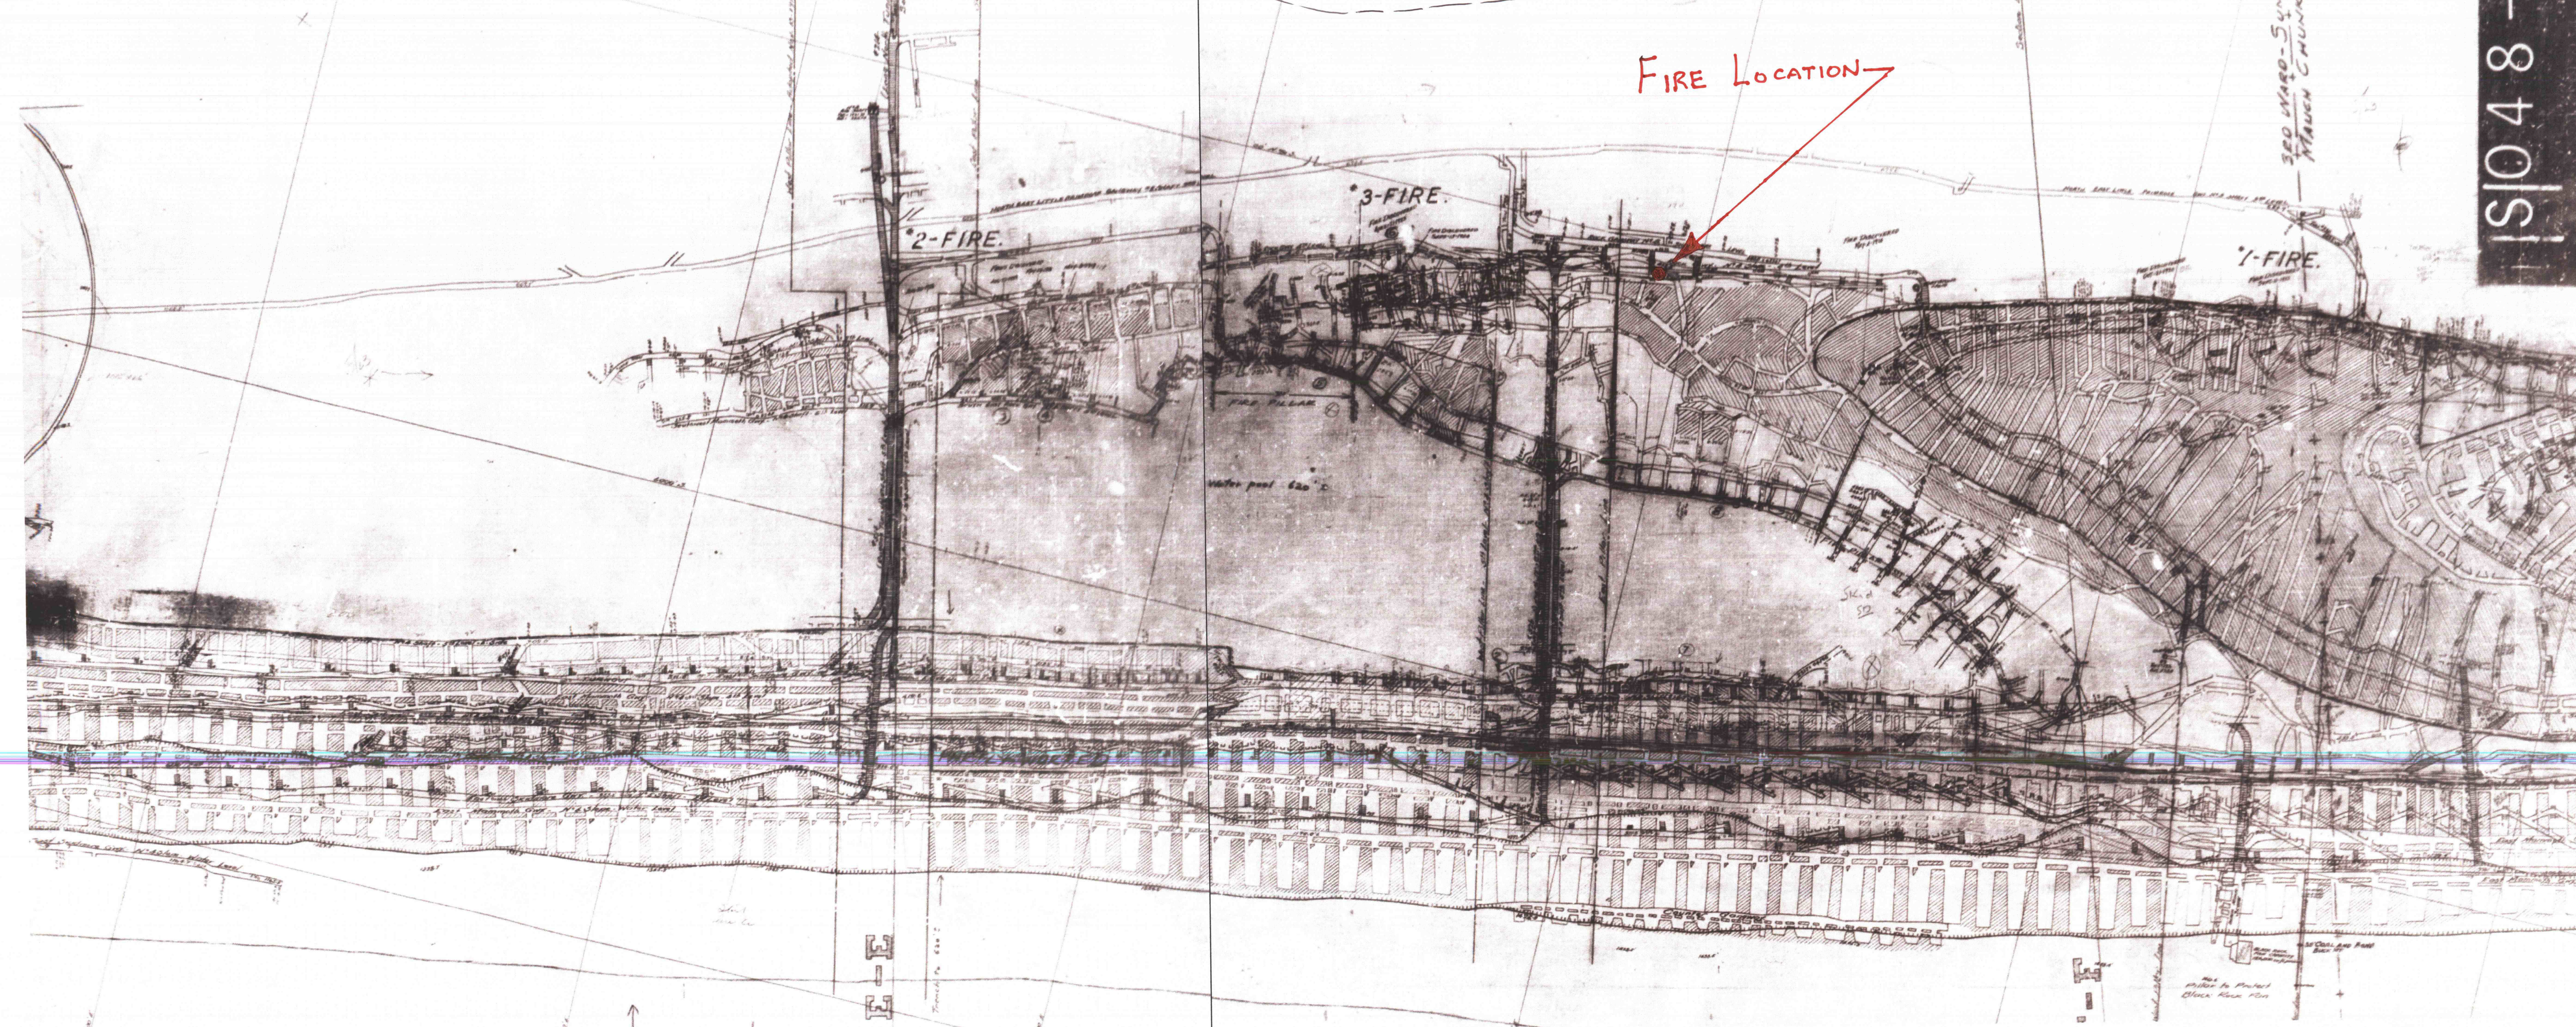

ISO 48-1009371