


TEMPORARY BENCH MARKS		
No	Elevation	Location and description
3	999.40	9" Spike in twin 12" maple 25' left of Sta. 22+50B
4	1204.77	9" Spike vertical in twin 12" Oak 10' right Sta. 0+65B


For location of Bench Marks see Dwg. No. 3

TRAVERSE JOINT LOCATION			
Station	Joint Type	Station	Joint Type
12+30	1	17+50	1
12+60	1	17+60	2
12+80	2	17+90	1
13+20	1	18+20	1
13+50	1	18+50	2
13+80	2	18+80	1
14+10	1	19+10	1
14+50	2	19+40	2
14+80	1	19+70	1
15+10	1	20+00	1
15+40	2	20+30	2
15+70	1	20+60	1
16+00	1	20+90	1
16+30	2	21+20	2
16+60	1	21+50	1
16+90	1	21+73	1
17+20	2		

NOTES:
 1. For General Notes see Dwg. No. 3
 2. For Cross Sections and Details see Dwg. Nos. 6 and 7.

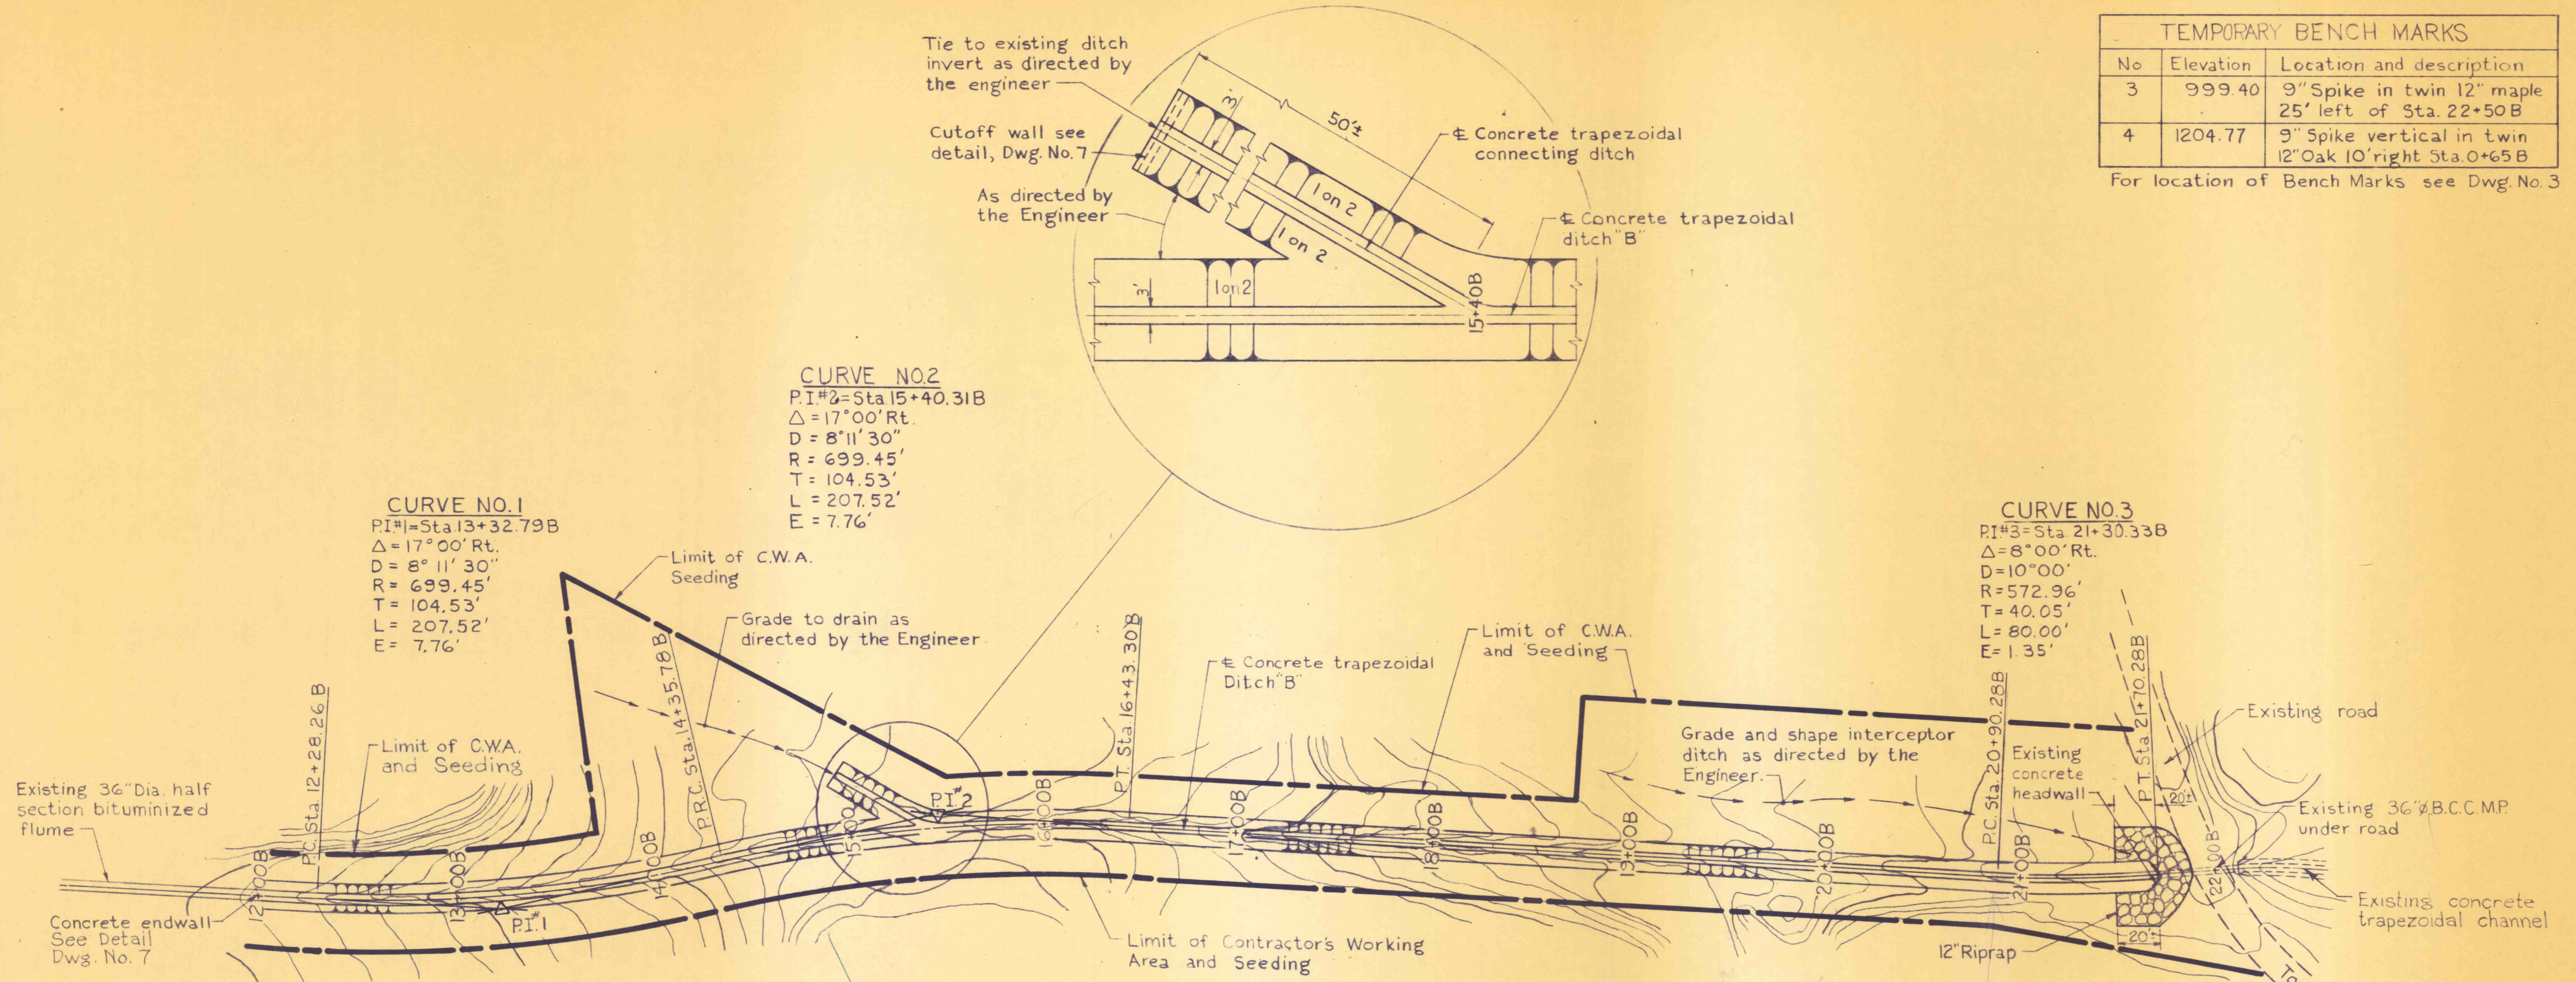

PLAN
Scale: 1in=50ft.

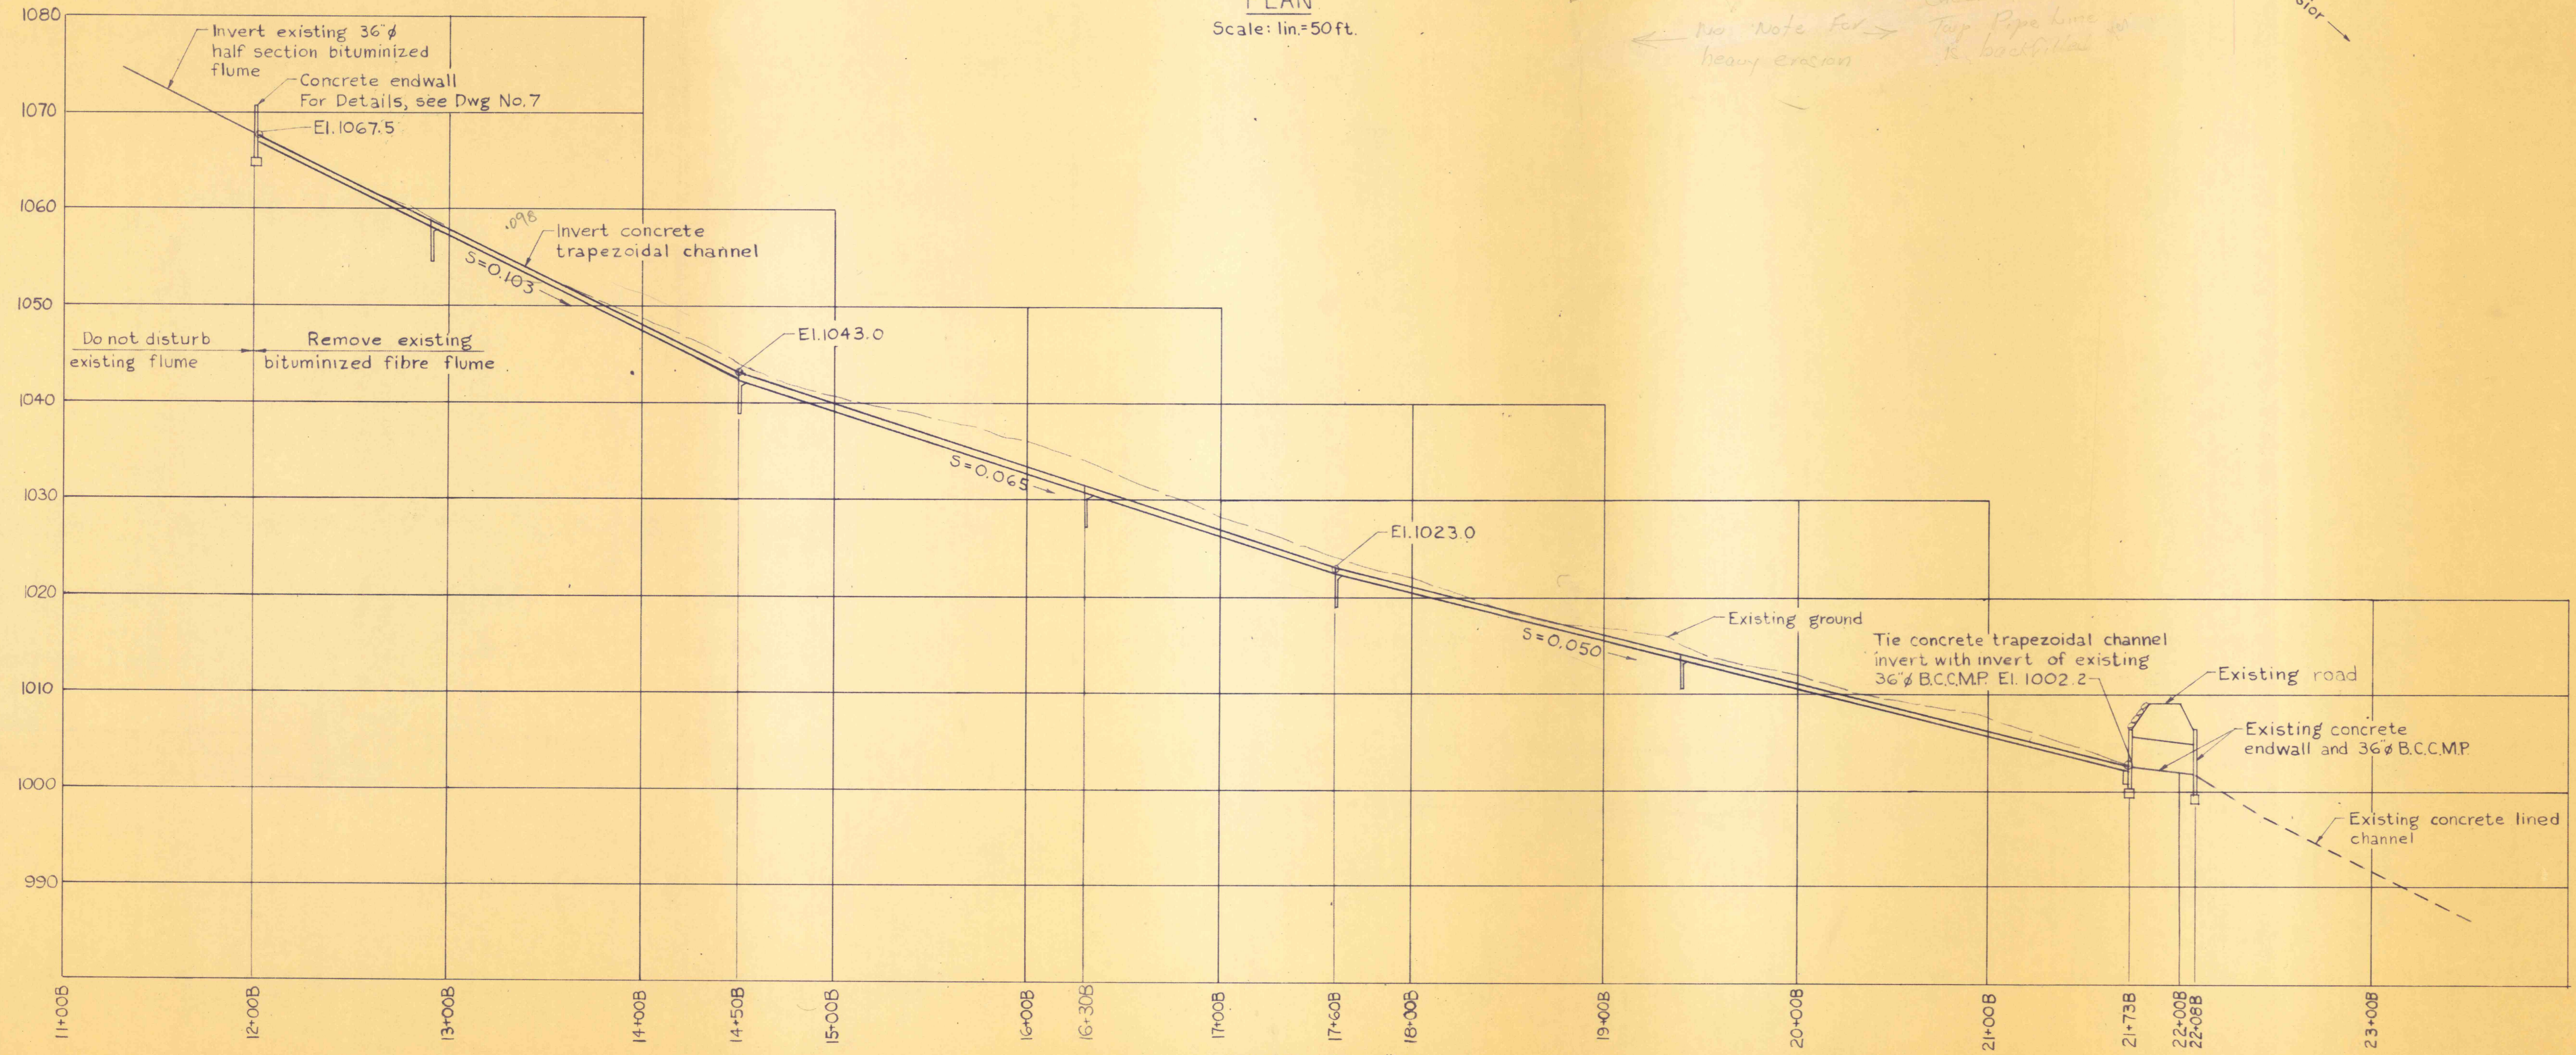

PROFILE "B"
Scale: Hor. 1in=50ft. Vert. 1in=10ft.

PRE FINAL

NO.	DATE	REVISION	APPR.
SUBMITTED			
PROJECT CO-ORDINATOR			
APPROVED			
CHIEF - DIVISION OF MINE RECLAMATION			
APPROVED			
DIRECTOR - BUREAU OF DESIGN			
COMMONWEALTH OF PENNSYLVANIA DEPARTMENT OF ENVIRONMENTAL RESOURCES OFFICE OF RESOURCES MANAGEMENT CONTRACT NO. SL 113-2-3 MINE DRAINAGE POLLUTION ABATEMENT REMEDIAL WORK SHAMOKIN CREEK WATERSHED NORTHUMBERLAND CO. PENNSYLVANIA			
DITCH B PLAN AND PROFILE			
DRAWN BY L. J. C.	DATE 8/2/76	DRAWING NO. 5 of 7	
CHECKED BY	SCALE AS SHOWN		