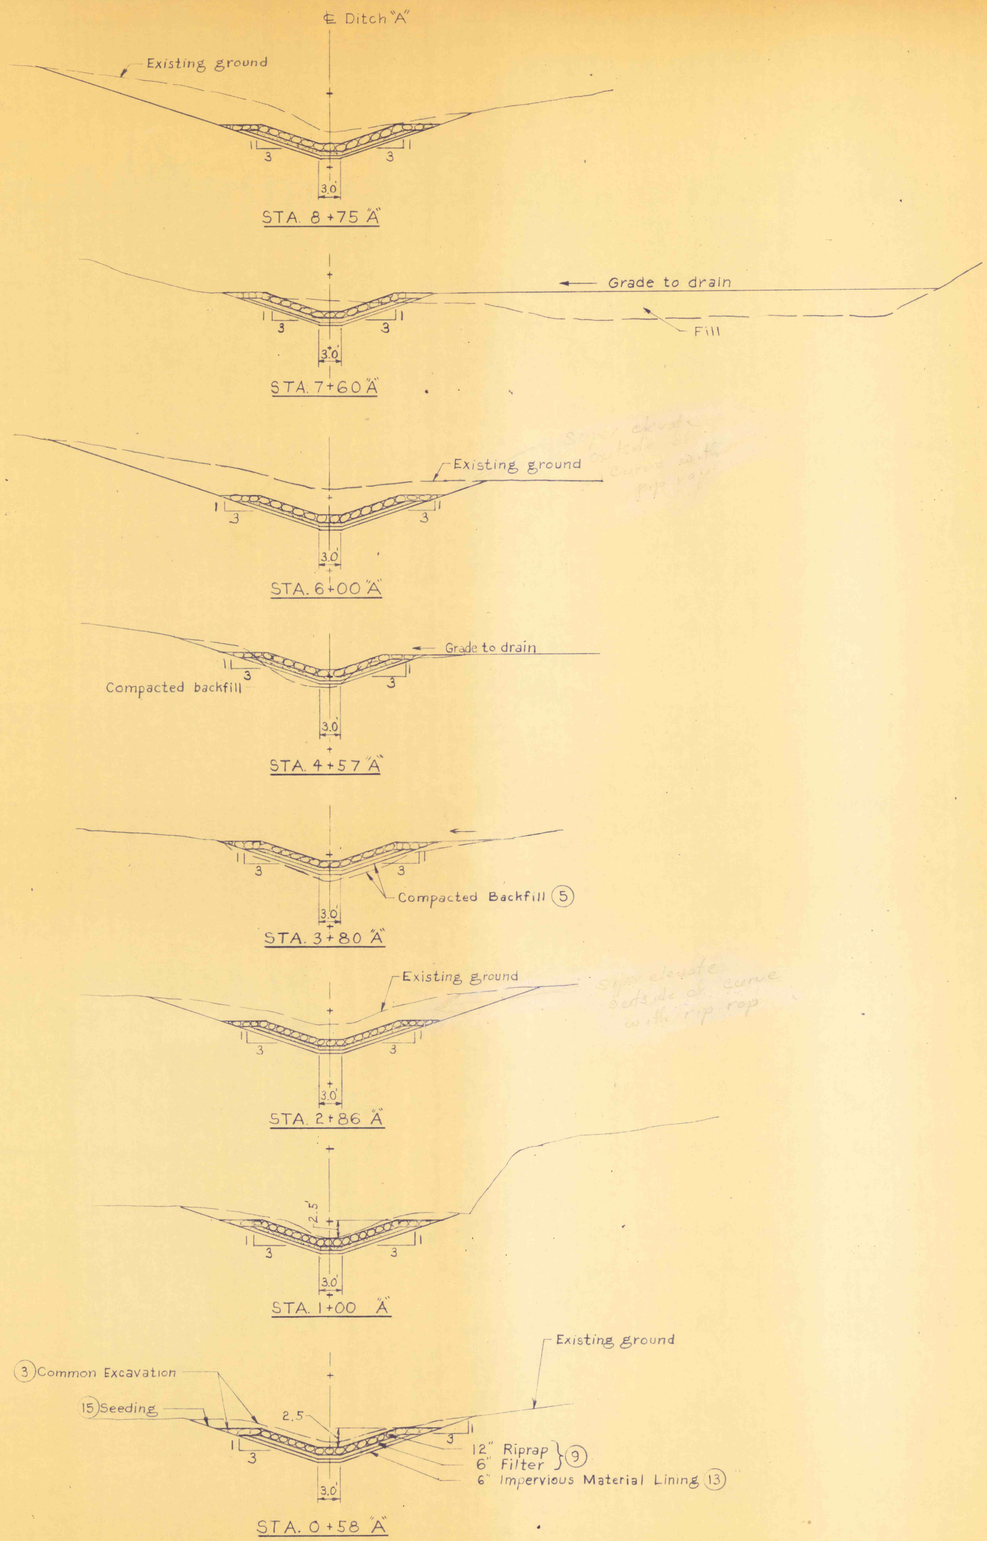

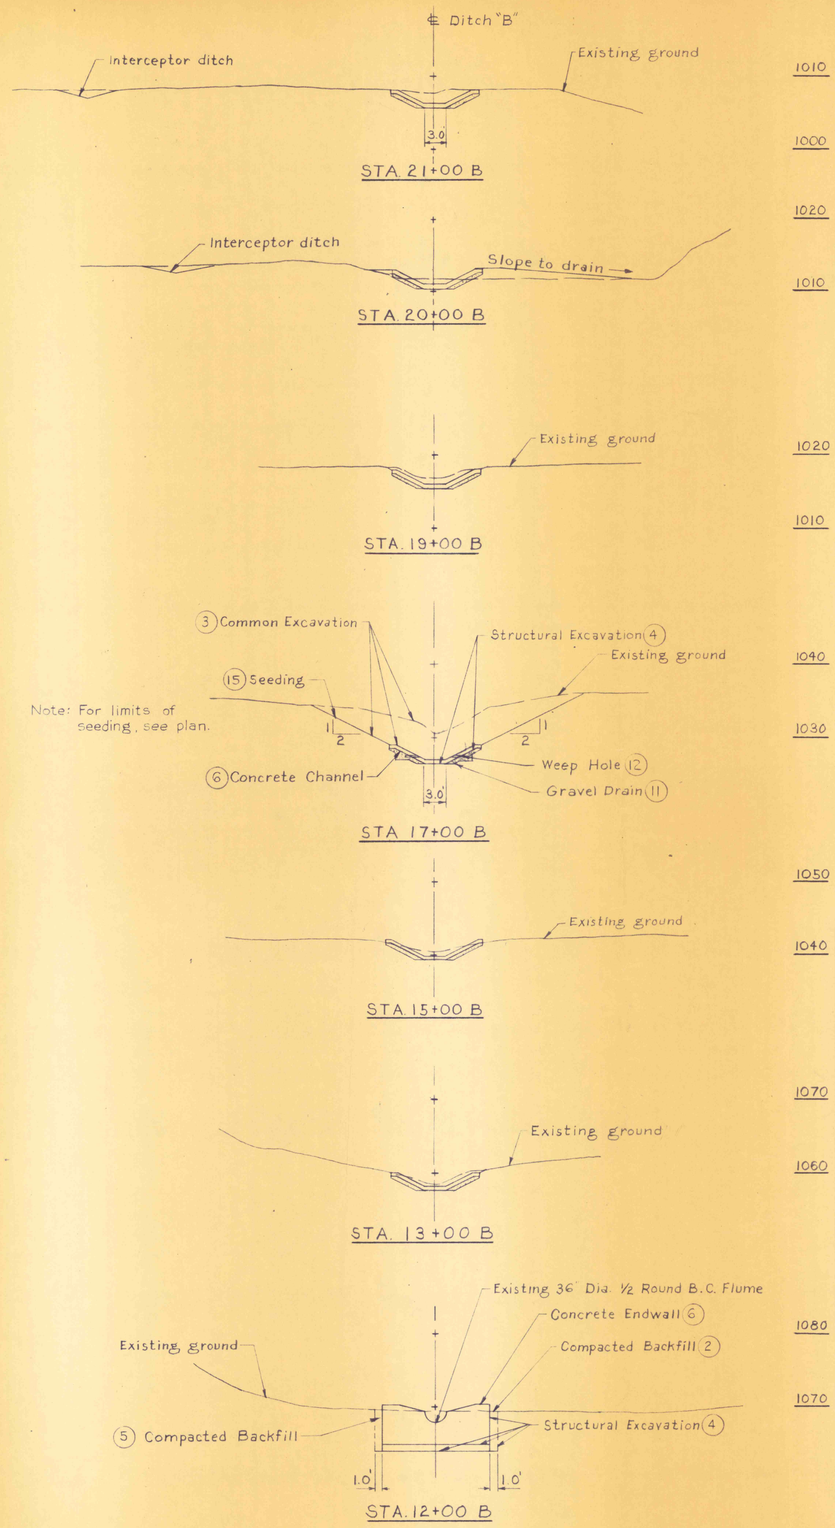

NOTES:

1. For Plan and Profile of Ditch "A", see Dwg. No. 4.
2. For Plan and Profile of Ditch "B", see Dwg. No. 5.
3. For Details and Concrete Notes, see Dwg. No. 7.
4. Remove existing bituminized flume upstream of Sta. 12+00 and stockpile within the C.W.A. limits as directed by the Engineer.

PRE FINAL

NO.	DATE	REVISION	APPR

SUBMITTED
PROJECT CO-ORDINATOR
APPROVED
CHIEF - DIVISION OF MINE RECLAMATION
APPROVED
DIRECTOR - BUREAU OF DESIGN

COMMONWEALTH OF PENNSYLVANIA
DEPARTMENT OF ENVIRONMENTAL RESOURCES
OFFICE OF RESOURCES MANAGEMENT

CONTRACT NO. SL 113-2-3

MINE DRAINAGE POLLUTION ABATEMENT
REMEDIAL WORK
SHAMOKIN CREEK WATERSHED

NORTHUMBERLAND CO. PENNSYLVANIA

CROSS SECTIONS

DRAWN BY	DATE	DRAWING NO.
W.M.C.		6 of 7
CHECKED BY	SCALE 1 in. = 10 ft.	