


DON & ROBERTINA EIGHMY  
(SURFACE)  
THOMAS E. REITZ  
(MINERALS)

PENNA. STATE GAME LANDS  
(SURFACE)  
THOMAS E. REITZ  
(MINERALS)  

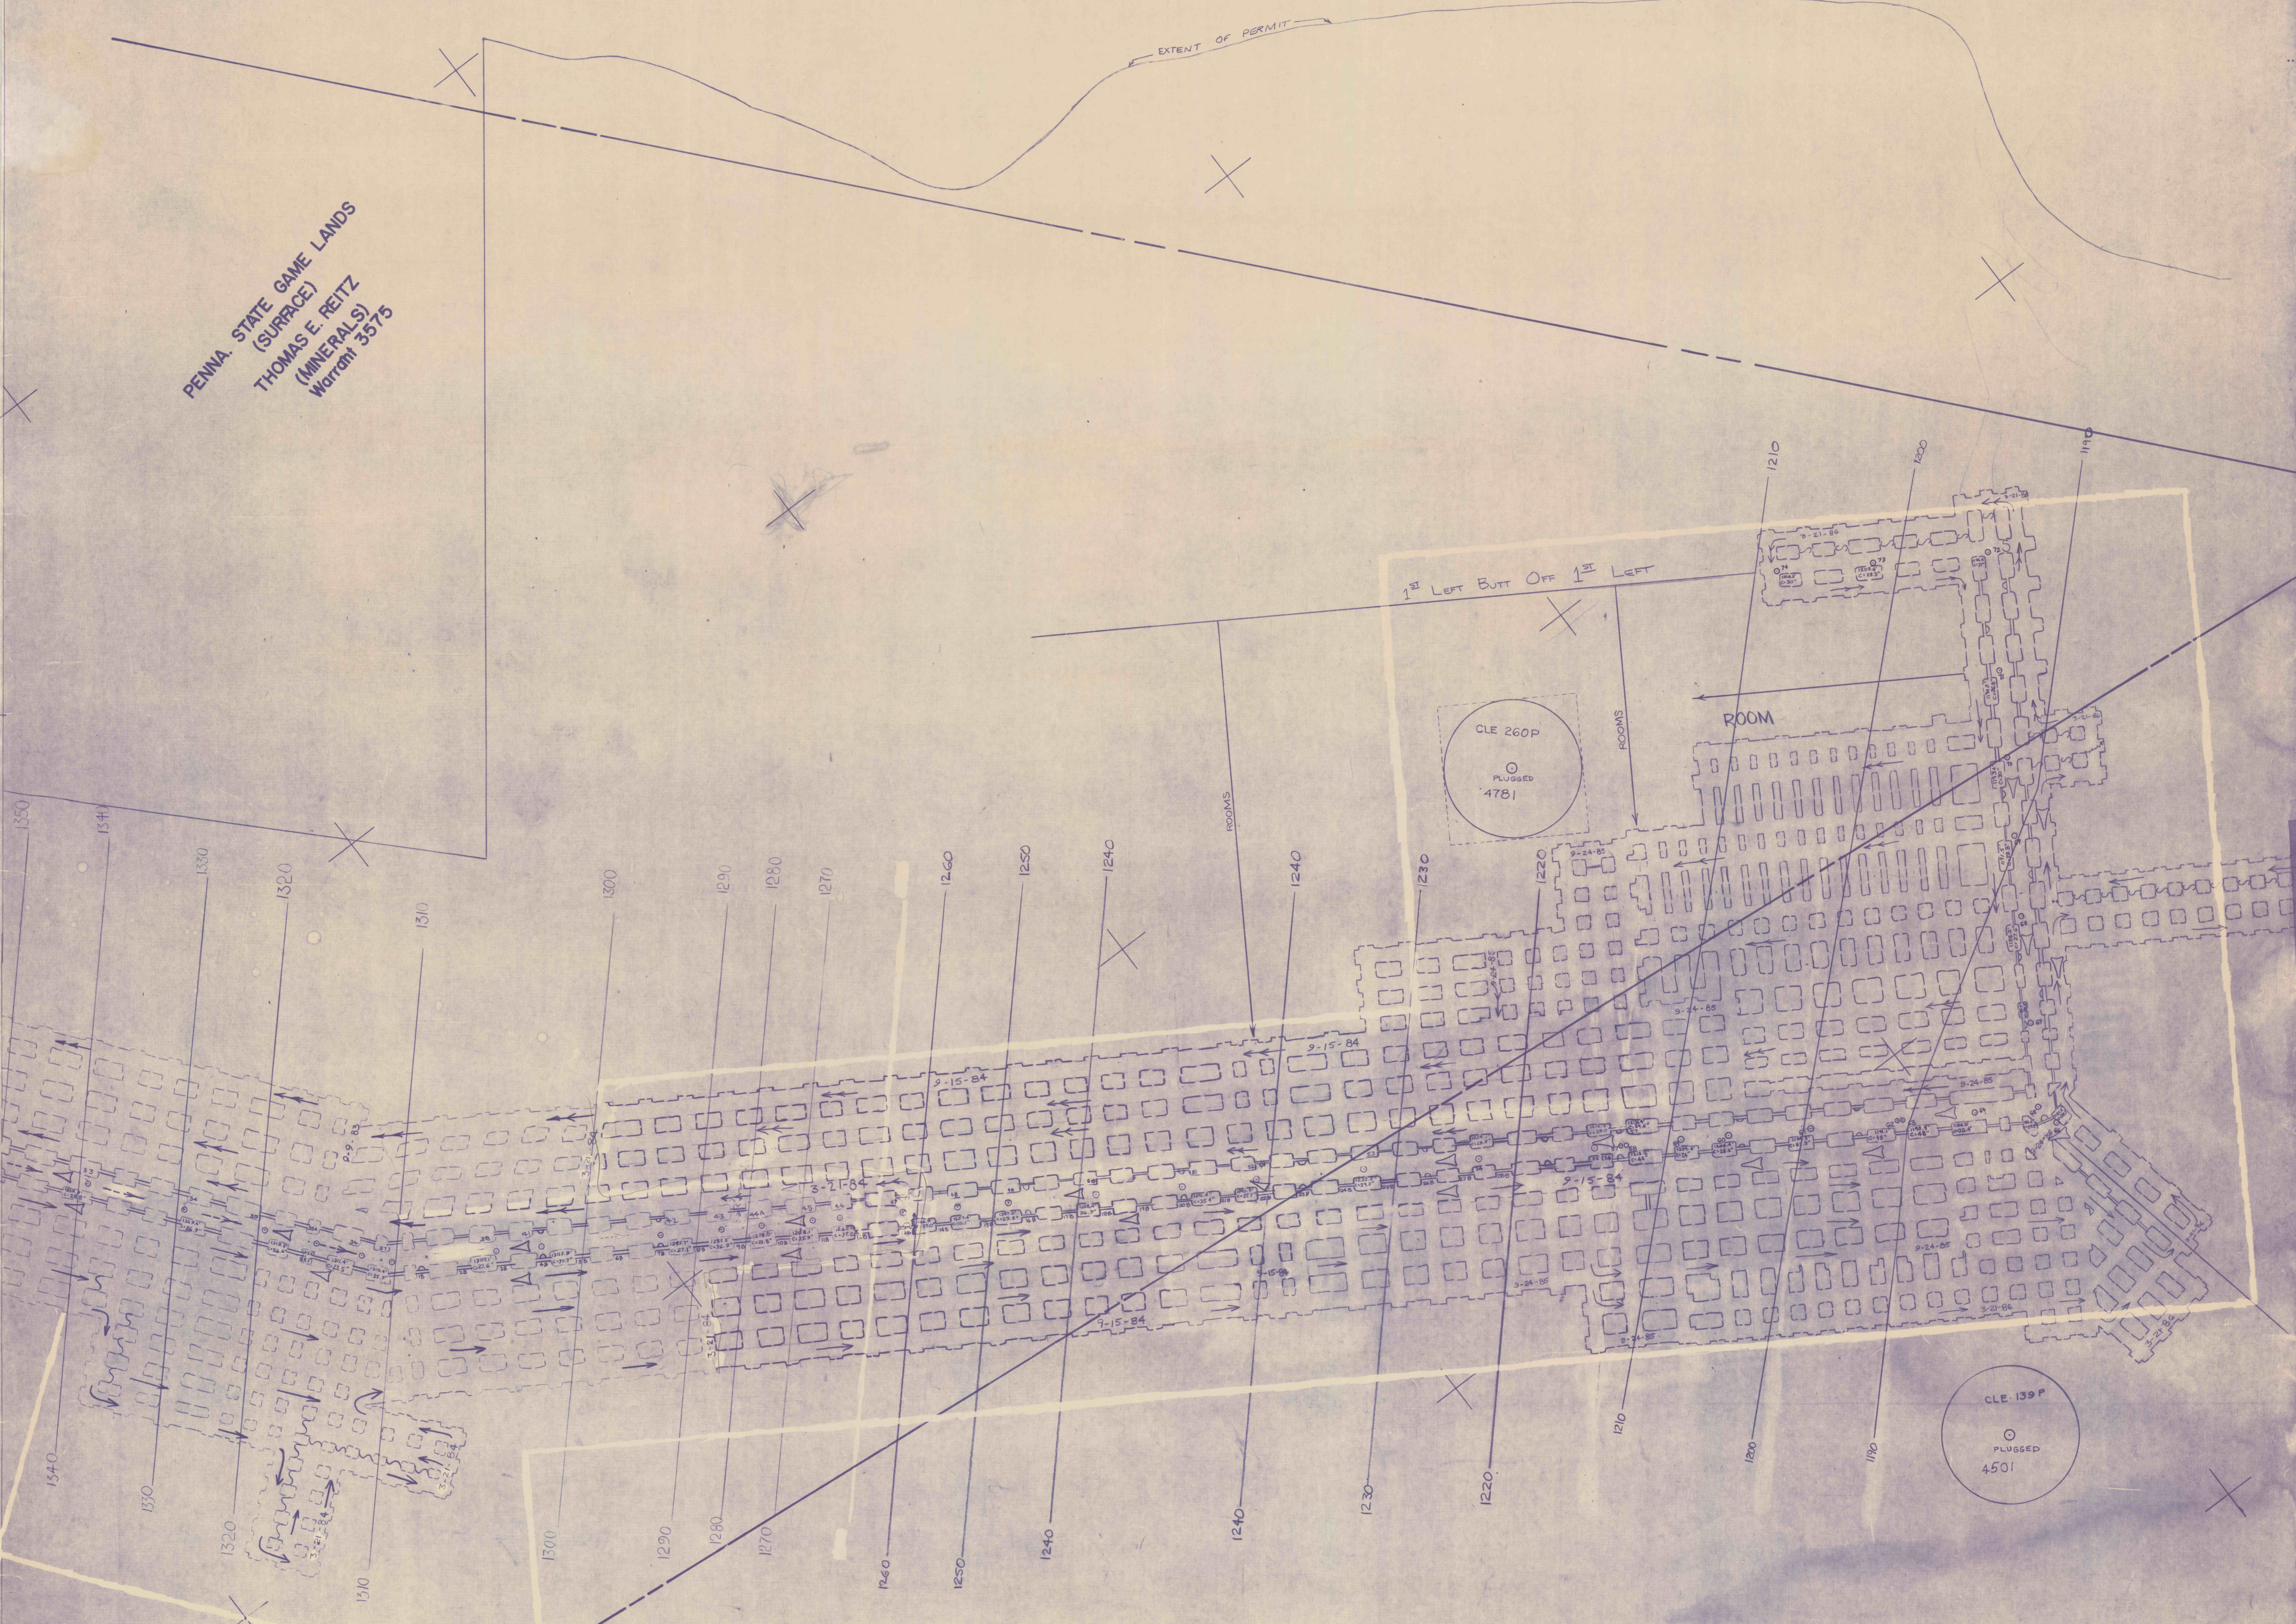

DEVELOPMENT BY ADVANCE ROOMING PLAN 'A'  
DEVELOPMENT BY ADVANCE ROOMING PLAN 'B'  
DEVELOPMENT BY ADVANCE ROOMING PLAN 'A'  
DEVELOPMENT BY ADVANCE ROOMING PLAN 'B'

GREEN GLEN CORP.  
(SURFACE)  
THOMAS E. REITZ  
(MINERALS)  
Warrant 3576

CLE 47P  
PLUSED  
2928



Glen Ivan Corp.  
VENTILATION MAP  
Bark Camp No. 2

Huston Township, Clearfield County PA

SCALE - 1 inch = 100 feet  
FEBRUARY 2, 1971  
CLEARFIELD, PA  
HESS & FISHER  
ENGINEERS, INC.  
2 of 2 M-0192B

