


WARRANT NO. 2000
WARRANT NO. 2001

MINE WORKS TO DATE 10/24/84 K.W.B.
MINE WORKS TO DATE 4/20/85 K.W.B.
MINE WORKS TO DATE 10/25/85 K.W.B.

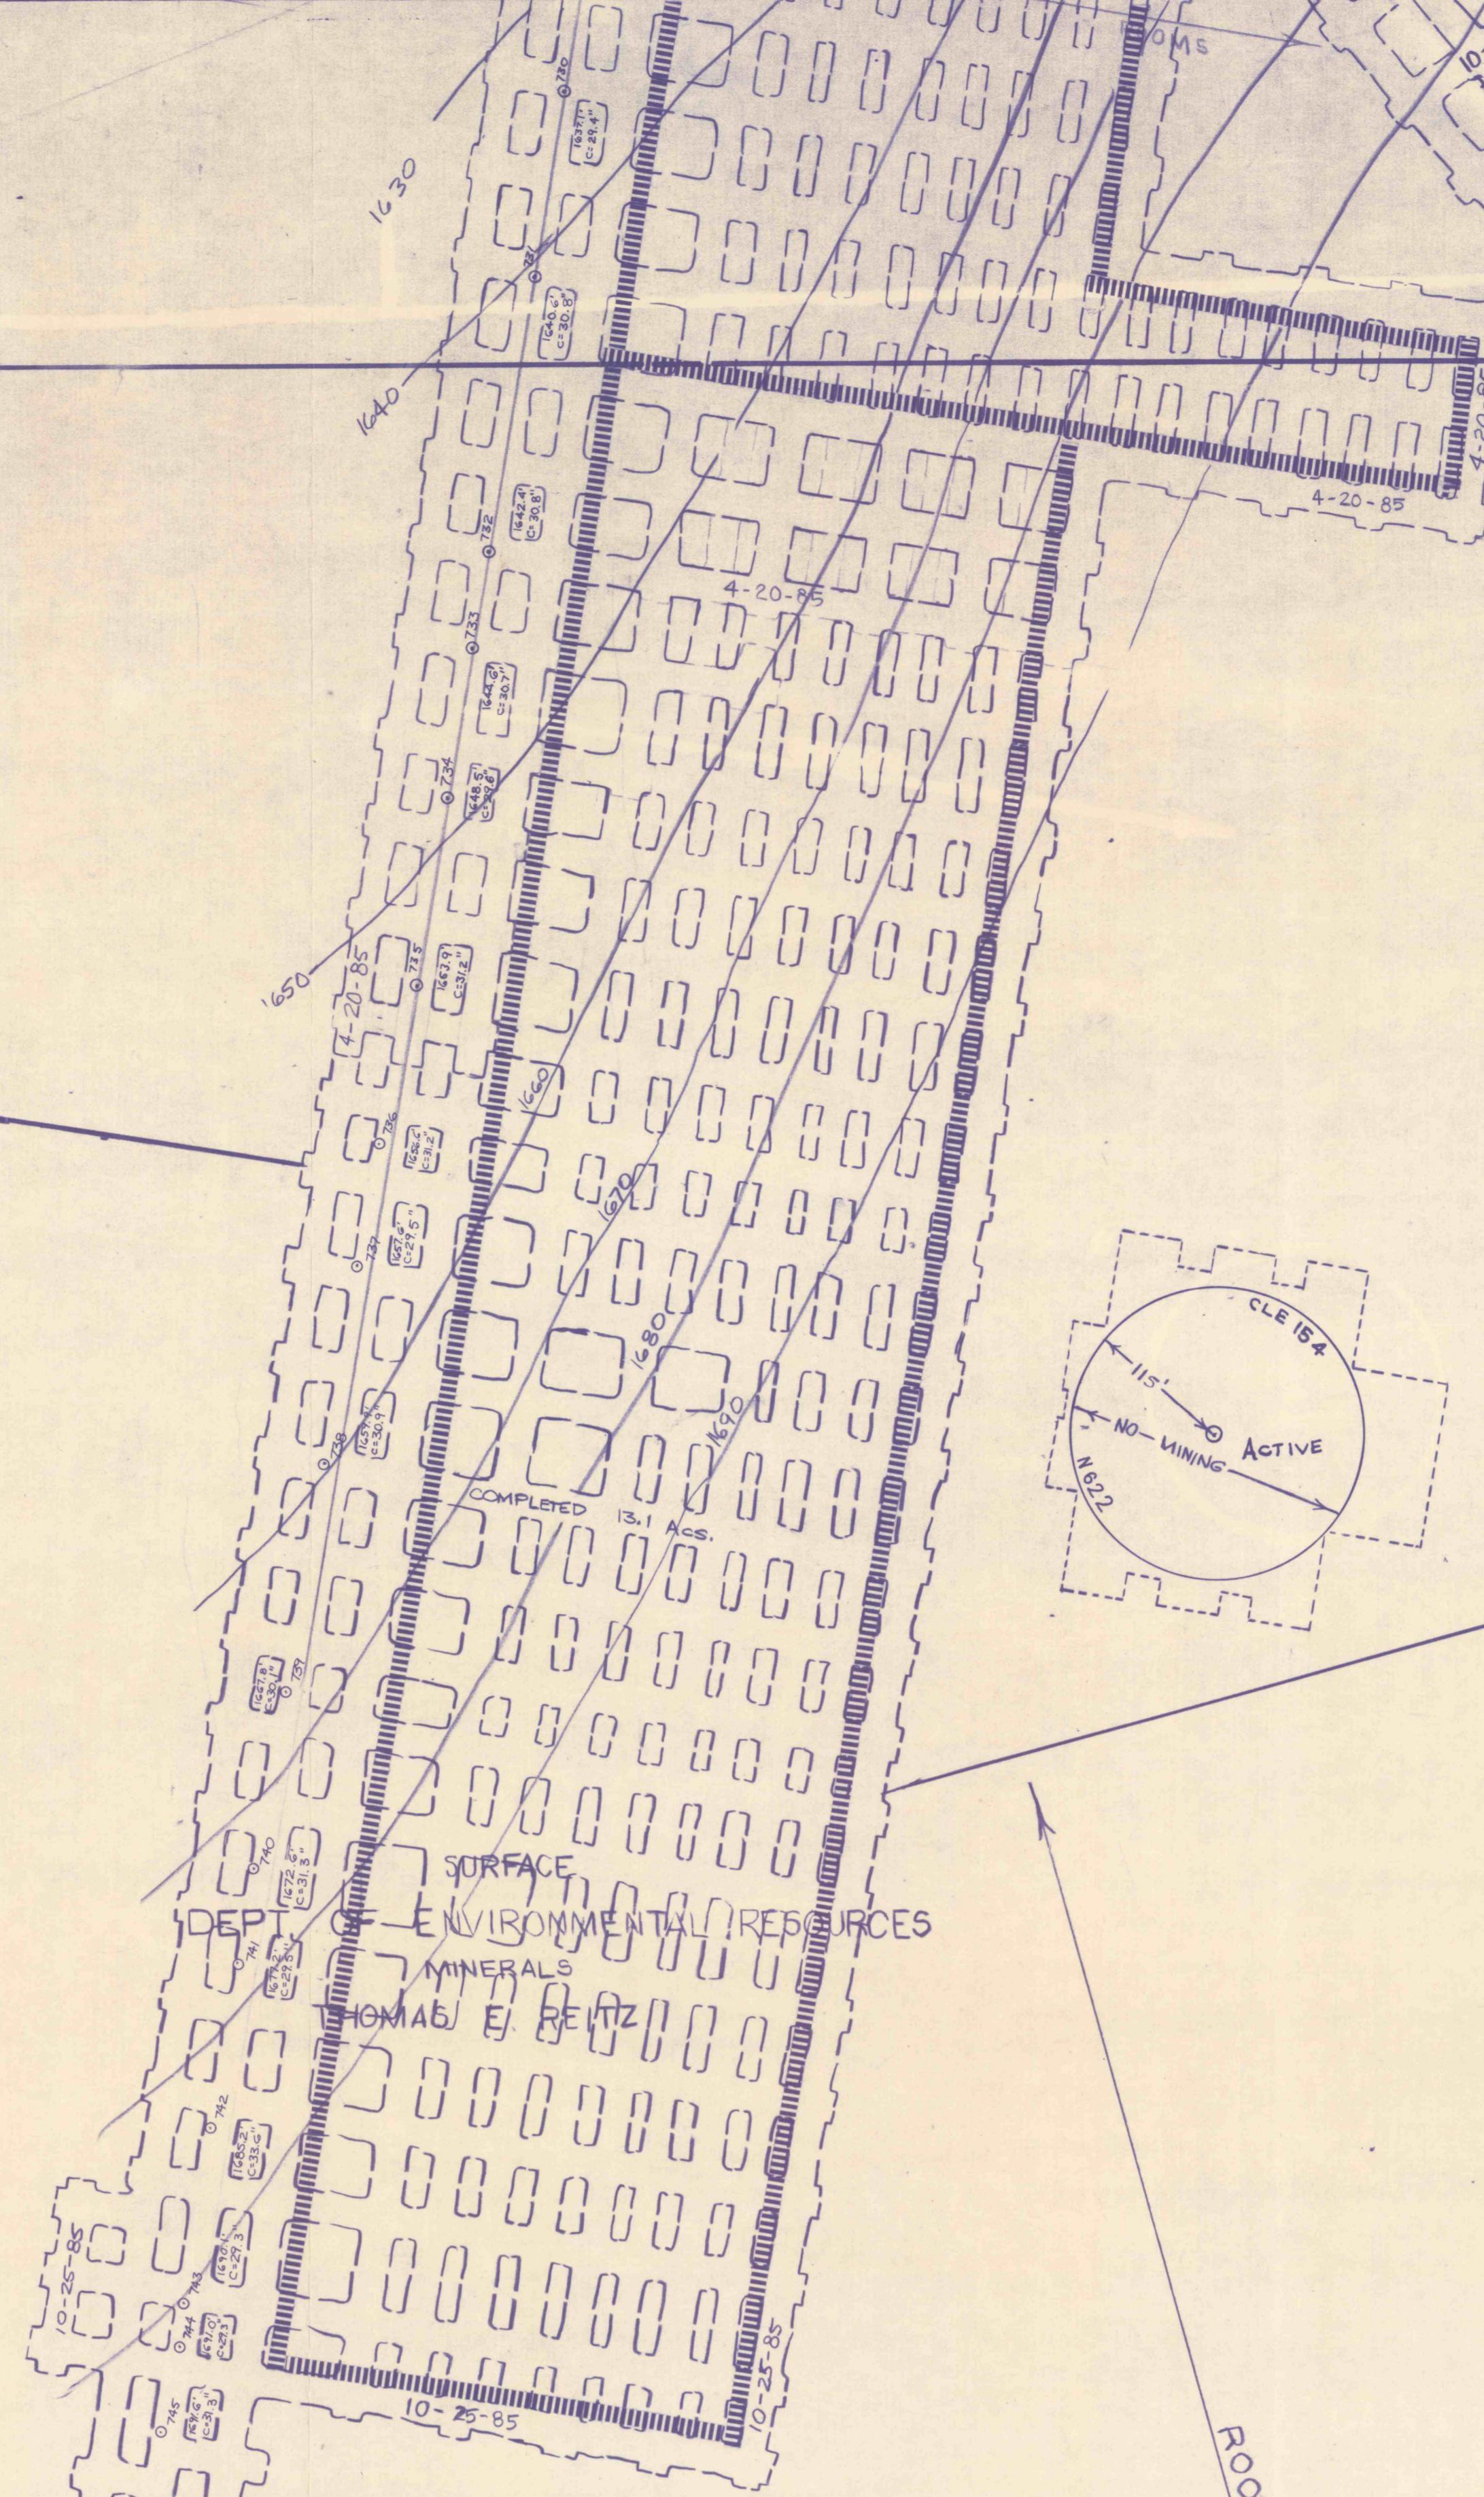

ROOMS
SURFACE
DEPT. OF ENVIRONMENTAL RESOURCES
MINERALS
THOMAS E. REITZ

ROOMS
1st LEFT BUTT OFF 1st RIGHT SUBMAIN

1st RIGHT SUBMAIN
SIX ENTRY SYSTEM

200' BARRIER

L.H. OUTCROP

EXTENT OF PERMIT

LEGEND
CONTEMPLATED MINING 88.1 AC. 11/5/85 TO 5/5/86
MINING COMPLETED AREA 13.1 AC.

GLEN IRVAN CORP.
BARK CAMP NO. 1

HUSTON TWP CLEARFIELD CO.
SCALE - 1 INCH = 100 FEET
JANUARY, 1985 HESS & FISHER ENGINEERS, INC.
CLEARFIELD, PA.

Subsidence Map
SHEET 4B OF 4
M-0190 C

SEE SHEET 4A OF 4 FOR LEGEND & NOTES.

MINE WORKS TO DATE 10-25-85 K.W.B.

- ARTHUR BUHITE
- PAUL LESPER et al
- ROBERT C. MCGARVEY
- H.E. BUHITE
- MARK REITER et al
- FRED DENMLER et al
- ANTHONY J. OLIVERI
- HOWARD E. SHEARER
- BERNICE B. WOLFE
- JAMES PUDLO
- OWLS NEST CAMP