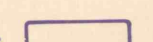
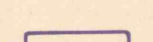



MINE WORKS TO DATE 10-25-85 K.W.B.
 MINE WORKS TO DATE 4-20-85 K.W.B.
 MINE WORKS TO DATE 10-24-84 K.W.B.
 Mine Works To Date 4-20-84 K.W.B.
 MINE WORKS TO DATE 10-2-83 K.W.B.
 MINE WORK TO DATE 4-9-83 K.W.B.

MINERALS
 THOMAS E. REITZ
 SURFACE
 DEPT. OF ENVIRONMENTAL RESOURCES


SURFACE
 DEPT. OF ENVIRONMENTAL RESOURCES
 MINERALS
 THOMAS E. REITZ

LEGEND
 CONTEMPLATED MINING 84.3 Acs. 
 5/5/85 TO 11/5/85
 MINING COMPLETED AREA 11.2 Acs. 

FRANK A. RISCHITELLI

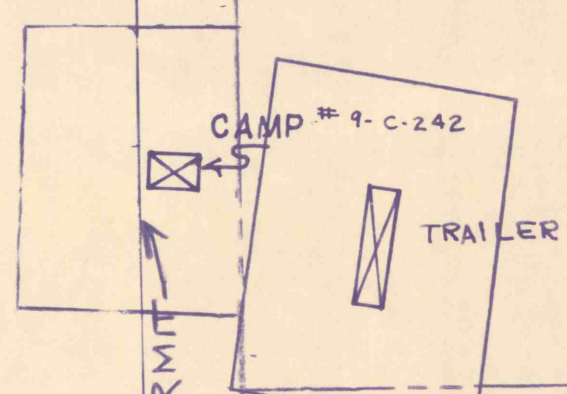

RICHARD L. PRAVE

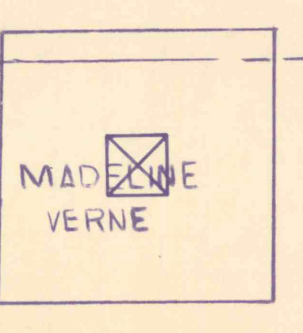

HELEN NILES
#1

GLEN IRVAN CORP.
BARK CAMP NO. 1
BOSTON TWP. CLEARFIELD CO.

SCALE - 1 INCH = 100 FEET
JANUARY, 1985
CLEARFIELD, PA.
HESS & FISHER ENGINEERS, INC.

SHEET 3 OF 4
M-01900

