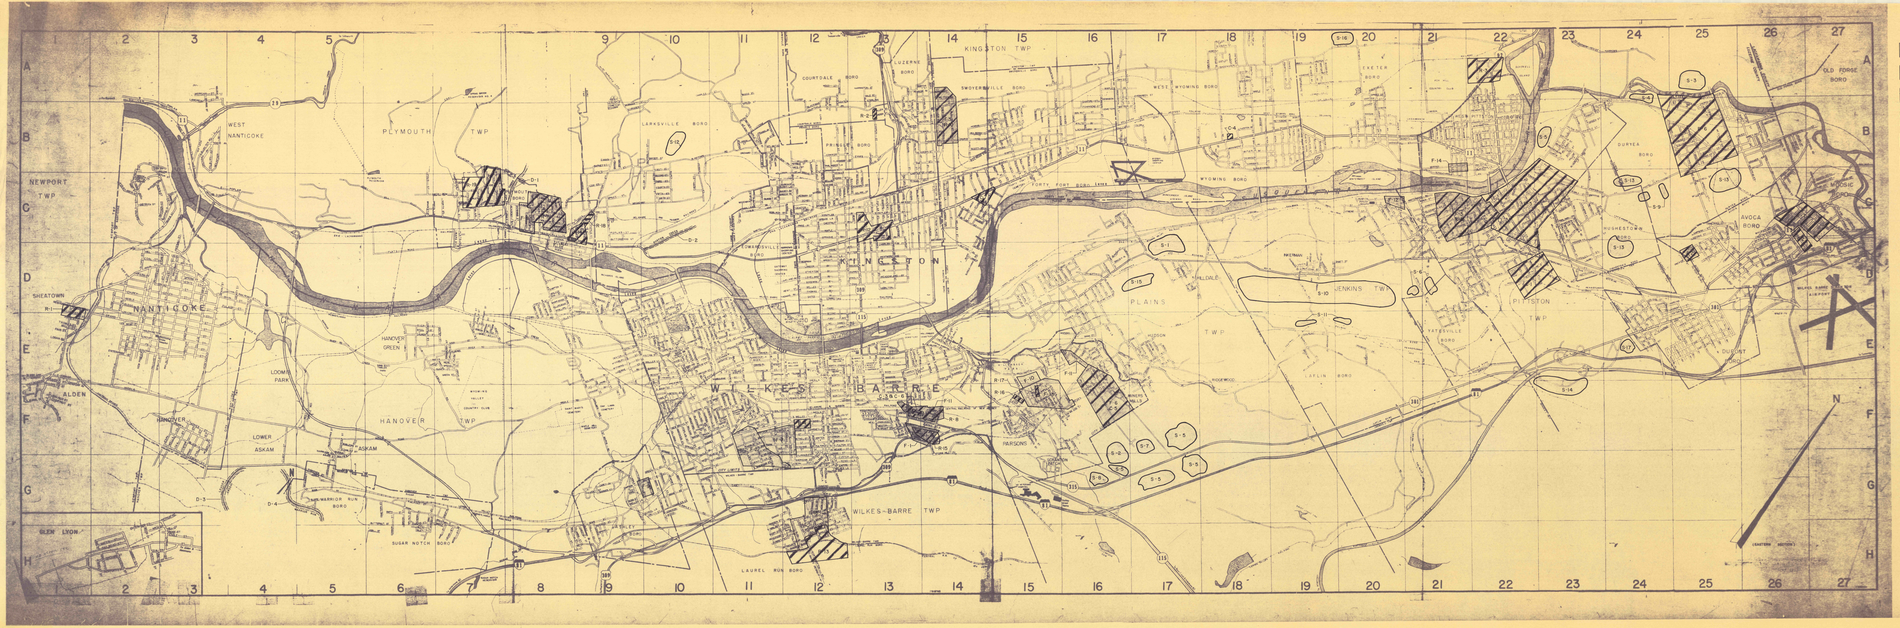

LEGEND

- STRIP PIT RECLAMATION PROJECTS
- STATE FLUSHING PROJECTS
- STATE ROTARY DRILLING PROJECTS
- STATE ROTARY DRILLING & STATE FLUSHING PROJECTS
- STATE CORE DRILLING PROJECTS
- STATE CORE DRILLING & STATE FLUSHING PROJECTS
- STATE-FEDERAL MINE DRAINAGE PROJECTS

S-STRIP PIT RECLAMATION PROJECTS

S-1: NR 22
S-2: NR 29
S-3: NR 27
S-5: NR 28
S-6: NR 8
S-7: NR 7
S-8: NR 6
S-9: NR 1
S-10: NR 45
S-11: NR 50
S-12: NR 47
S-13: NR 35
S-14: NR 34
S-15: NR 54
S-16: NRD 34
S-17: NRD 35

F-FLUSHING PROJECTS

F-1: ASP-8
F-3: ASP-9
F-5: ASP-15
F-6: ASP-16
F-7: ASP-17
F-8: ASP-23
F-9: PIB-83
F-10: SL 465
F-11: SL 415
F-12: FE 40-5-2
F-13: NRD 3
F-14: SL 442-A
F-15: NR 88
F-16: SL 475-101

R-ROTARY DRILLING PROJECTS

R-1: SL 430
R-2: SL 440-1
R-3: SL 442-A
R-4: SL 444
R-5: SL 470-101.5
R-6: SL 484-100.5 AREA 1
R-7: SL 484-101.5 AREA 2
R-8: FE 40-5
R-9: FE 40-5
R-10: FE 40-7-1
R-11: FE 40-8-1
R-12: NR 41
R-13: SL 442-63 & 65
R-14: NR 58
R-15: NR 79
R-16: NR 89
R-17: NR 90A & 90B
R-18: NR 91
R-19: OSM 40(706)-81.101.5

C-CORE DRILLING PROJECTS

C-1: SL 481
C-2: SL 465-10.5
C-3: SL 479-101.5
C-4: SL 481-10.5
C-5: FE 40-17
C-6: SL 479-102.5
C-7: SL 400-10.5

D-STATE-FEDERAL MINE DRAINAGE PROJECTS

D-1: PROJECT NO. 23
D-2: PROJECT NO. 3
D-3: PROJECT NO. 14
D-4: PROJECT BY U.A. CORP.