

Note: The contractor shall comply with Act 287 of the General Assembly which defines the procedures for notification to Public Utilities prior to excavation, drilling, or demolition work using power equipment or explosives.


UTILITY LISTINGS

COMPANY	TYPE OF FACILITY	ADDRESS	PHONE
Penna. Power & Light Co.	Overhead & Underground Transmission Lines	P.O. Box 236 Jeffrey & Industrial Roads Frocksville, Pa. 17931	(717) 462-1933
Roaring Creek Water Co.	Underground Water Lines	204 East Sunbury Street Shamokin, Pa. 17872	(717) 648-5783



NO.	DATE	REVISION	APPR.
2	3-88	Completed Bore Hole	30
1	3-88	Deleted or Relocated	

Designer: *[Signature]*
 Project Engineer: *[Signature]*
 Chief Engineer: *[Signature]*
 Approved: *[Signature]*

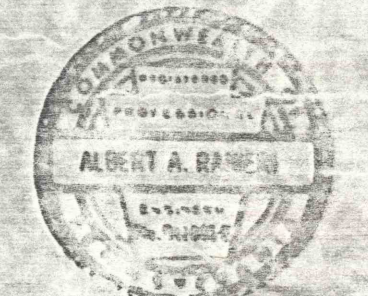

COMMONWEALTH OF PENNSYLVANIA
 DEPARTMENT OF ENVIRONMENTAL RESOURCES
 OFFICE OF RESOURCE MANAGEMENT

CONTRACT NO. OSM 49 (510) 101.5
 GLEN BURN MINE FIRE
 EXPLORATORY DRILLING PROJECT

COAL TWP., CITY OF SHAMOKIN
 NORTHUMBERLAND CO., PA

SITE LOCATION, AND
 BOREHOLE PLAN

SHT. 2 of 2

ALL DIMENSIONS AND EXISTING CONDITIONS SHALL BE CHECKED AND VERIFIED BY CONTRACTOR AT THE SITE.

