


PENNSYLVANIA COAL CO
 No. 14 COLLIERY

WILKES BARRE COLLIERIES CO
 Note: Wilkes Barre Collieries Co Now John Carlon Coal Co

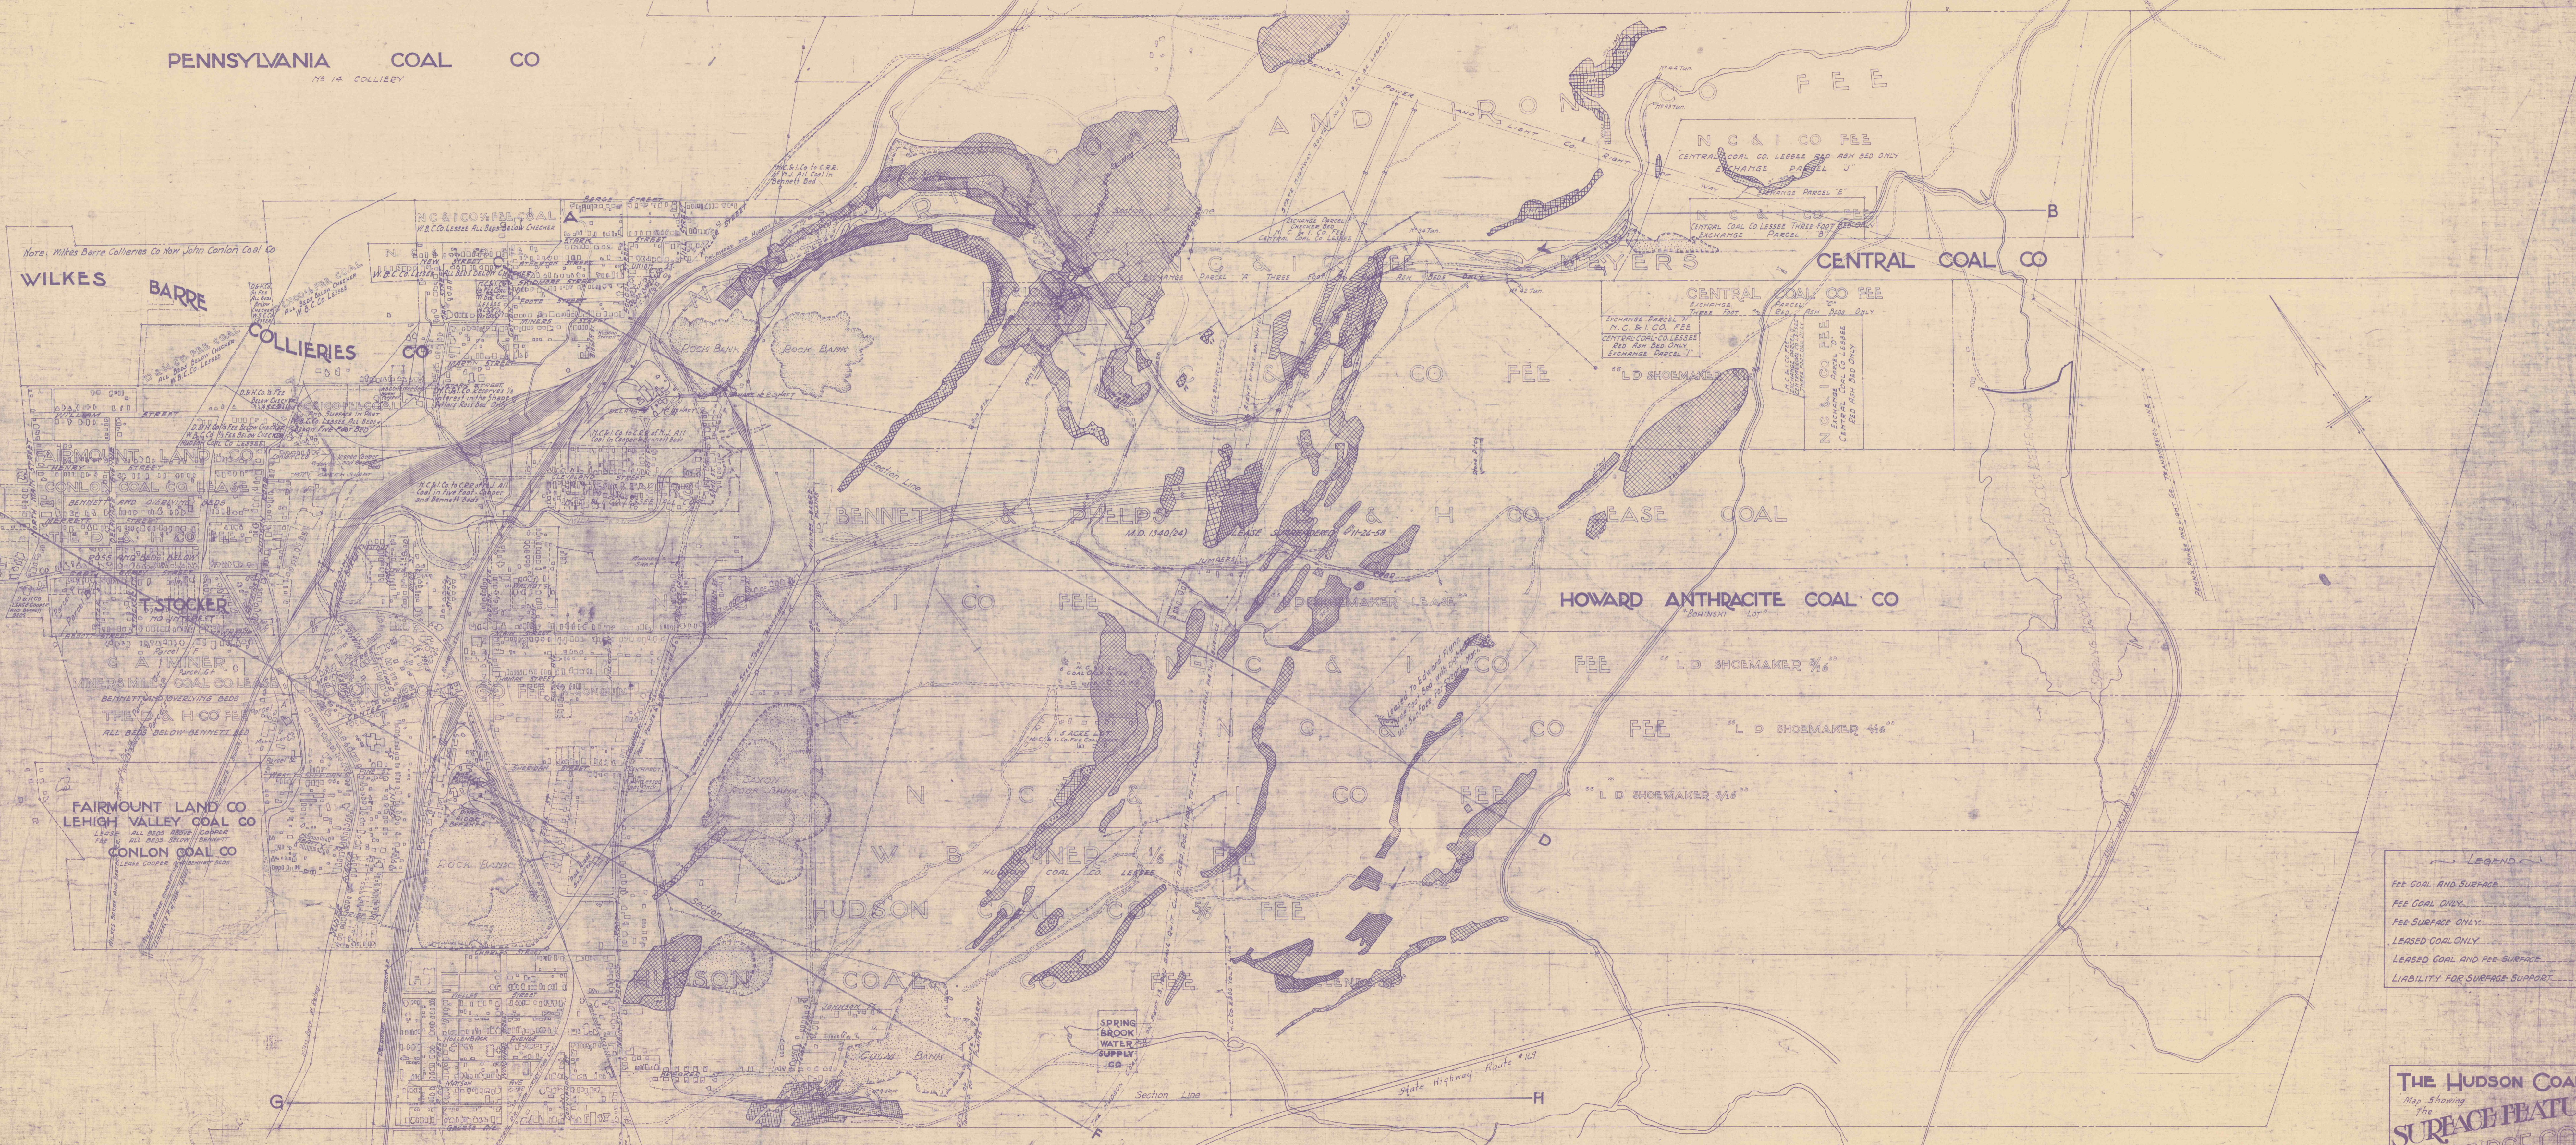

Legend

FEE COAL AND SURFACE	(Pattern)
FEE COAL ONLY	(Pattern)
FEE SURFACE ONLY	(Pattern)
LEASED COAL ONLY	(Pattern)
LEASED COAL AND FEE SURFACE	(Pattern)
LIABILITY FOR SURFACE SUPPORT	(Pattern)

Surf Features Checked with 100 ft. Traverses
 Oct. 1931 A.E.M.
 Nov. 1932 W.C.
 June 1934 S.M.
 Feb. 1935 S.M.

THE HUDSON COAL CO
 Map Showing
SURFACE FEATURES
 AT PINE RIDGE COLLIERY
 Scale 1"=400'
 Office of
 The Forecast Department