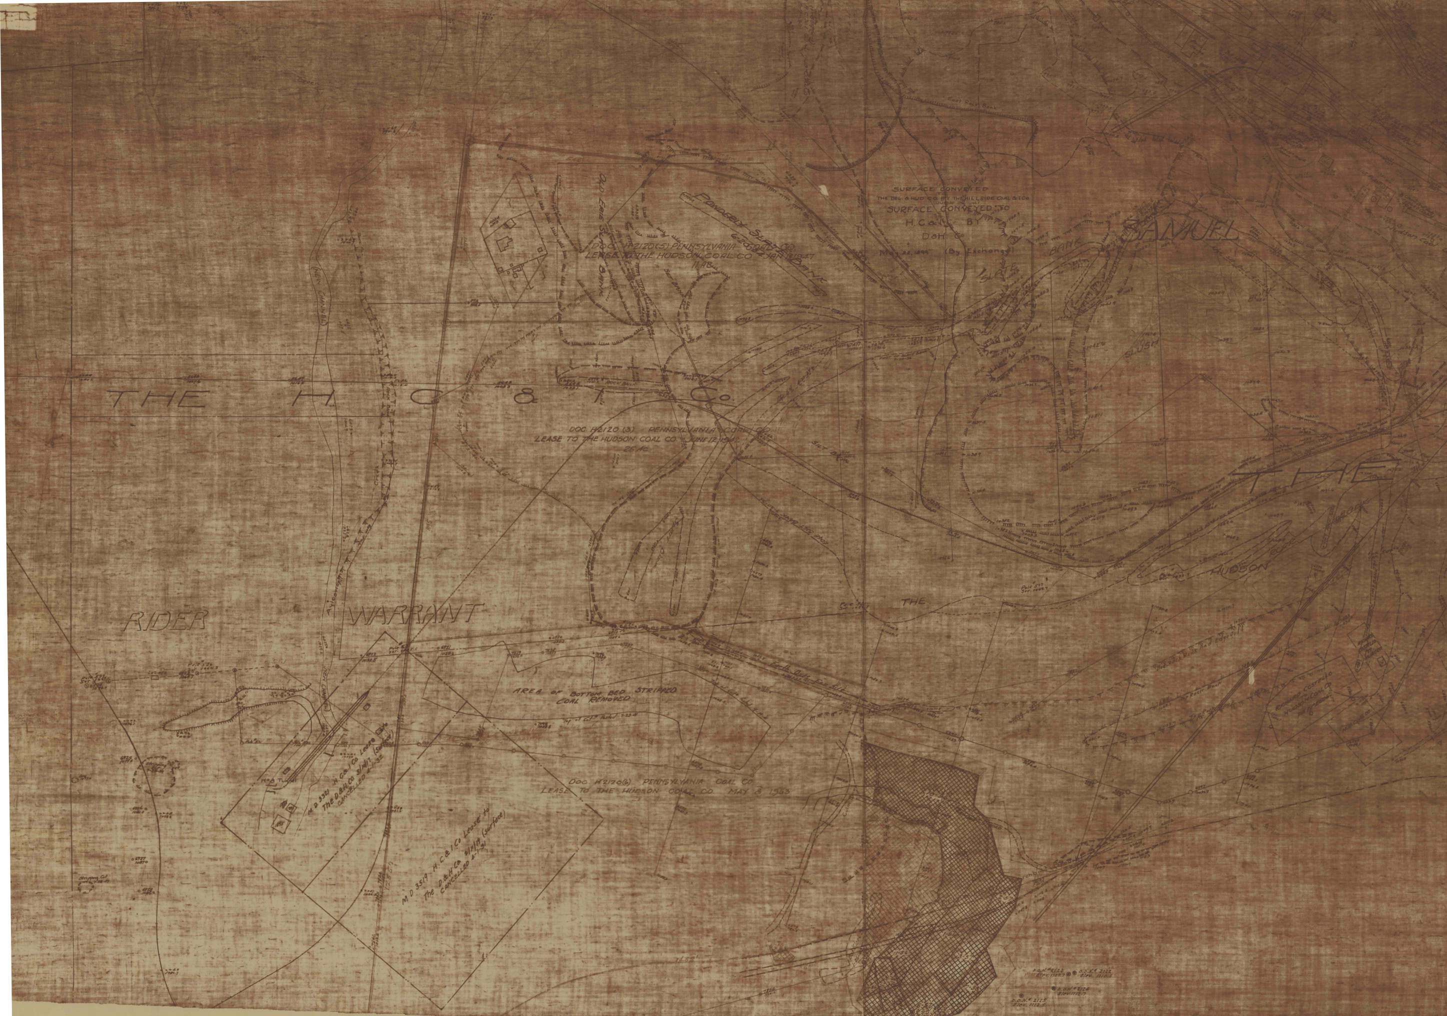
THE H. C & I. Co.
RIDER WARRANT
SAMUEL
THE
THE HUDSON
SURFACE CONVEYED TO THE DEL. & HUD. CO. BY THE HILLSIDE COAL & I. Co.
SURFACE CONVEYED TO H. C & I. Co BY D&H Co
May 22, 1899 (By Exchange)
SLATE
BANK
SLUSH
POWDERLY SLATE CO.
6-20634 JAN 1 1947
OLD ERIE SLATE BANK
SLT BANK
DOC. H2120(5) PENNSYLVANIA COAL CO
LEASE TO THE HUDSON COAL CO
11 AC.
ROCK BANK
DOC. H2120 (3) PENNSYLVANIA COAL CO.
LEASE TO THE HUDSON COAL CO. JUNE 12 1942
25 AC.
NEW CHANNEL
AREA of BOTTOM BED STRIPPED COAL REMOVED
Top of Cut Posted 7-23-21
Top of Cut Posted 9-14-21
Earth Dyke
DOC. H2120(6) PENNSYLVANIA COAL CO
LEASE TO THE HUDSON COAL CO. MAY 8 1953
No 8 Tunnel
M.D. 3321 H.C.&I.Co Lease to The D.&H.Co 3/1/17 (surface) CANCELLED 4-1-32
M.D. 3519 H.C.&I.Co Lease to The D.&H.Co 2/11/19 (surface) CANCELLED 4-1-31
RICHARD COSTELLO TO HUDSON COAL CO. P.B. No 2606
RICHARD COSTELLO TO HUD. C. CO.
HUD. COAL CO.
ROCK

RIDER
WARRANT
DEL
HENRY
RUSSELL ESTATE
COAL
AREA STRIPPED
AREA GRASSY STRIPPED + CO
Rock Bank
John L. Mosley
8-11-70
R-382
MARY CANNON
TO
HUD. C. CO
Nicholas Meholic
11-5-70
R-404
Nicholas Meholic
2-20-74
R-599
ANNE WALKER
B.H. 2545 D
Surf 1106.6
B.H. 2546 D
Surf 1082.6
ELIZABETH KELLY
TO HUD. C. CO.
LEONARD DEMPSEY
TO HUD. C. CO.
HUD. COAL CO.
Bushwick
Fill Removed
April 1944
COAL REMOVED
2" D.D.H. #2061 D
Surf 1262.8
Temple Iron Co
Tunnel

RIDGE
WARRANT
STRIPPED
GRASSY BED
AREA
STRIPPED GRASSY BED AREA
COAL
REMOVED
CARTER ST.
SOUTH CEMETERY
COLUMBIA AVE.
Wayne G. Martin
R-545
Carl Leitch
8-8-68
R-550
Clarence Tyler
5-24-67
R-173
Anthony Malloy
CATHOLIC CEMETERY
B.H. No
Carb. Coal Mining Co.
Sur.
CARBONDALE
LAND OF WILLIAM BRENNAN
M.D. 5018 Lease to John Boland 8-10-20 for term of 10 Years from 5-1-20
Assigned to J.E. Crase Jr. 3-31-25
2nd. PARCEL
Assigned to WARREN A. TYSON 6-1-28
& CANCELLED 4-30-35
LIMITS OF PARCEL No. to CARBONDALE COAL MINING CO.
CANCELLED 4-30-35
SILT
SLATE
BANK
SILT
SLATE
BANK
SILT
CITY DUMP
SILT

FOX
SOUTH
7TH AVE
TERRACE
WYOMING
COAL Co.

POWDERLY COLL'Y

Carbondale No. 1

EAST SIDE

Surface Features

Scale 1IN = 100FT