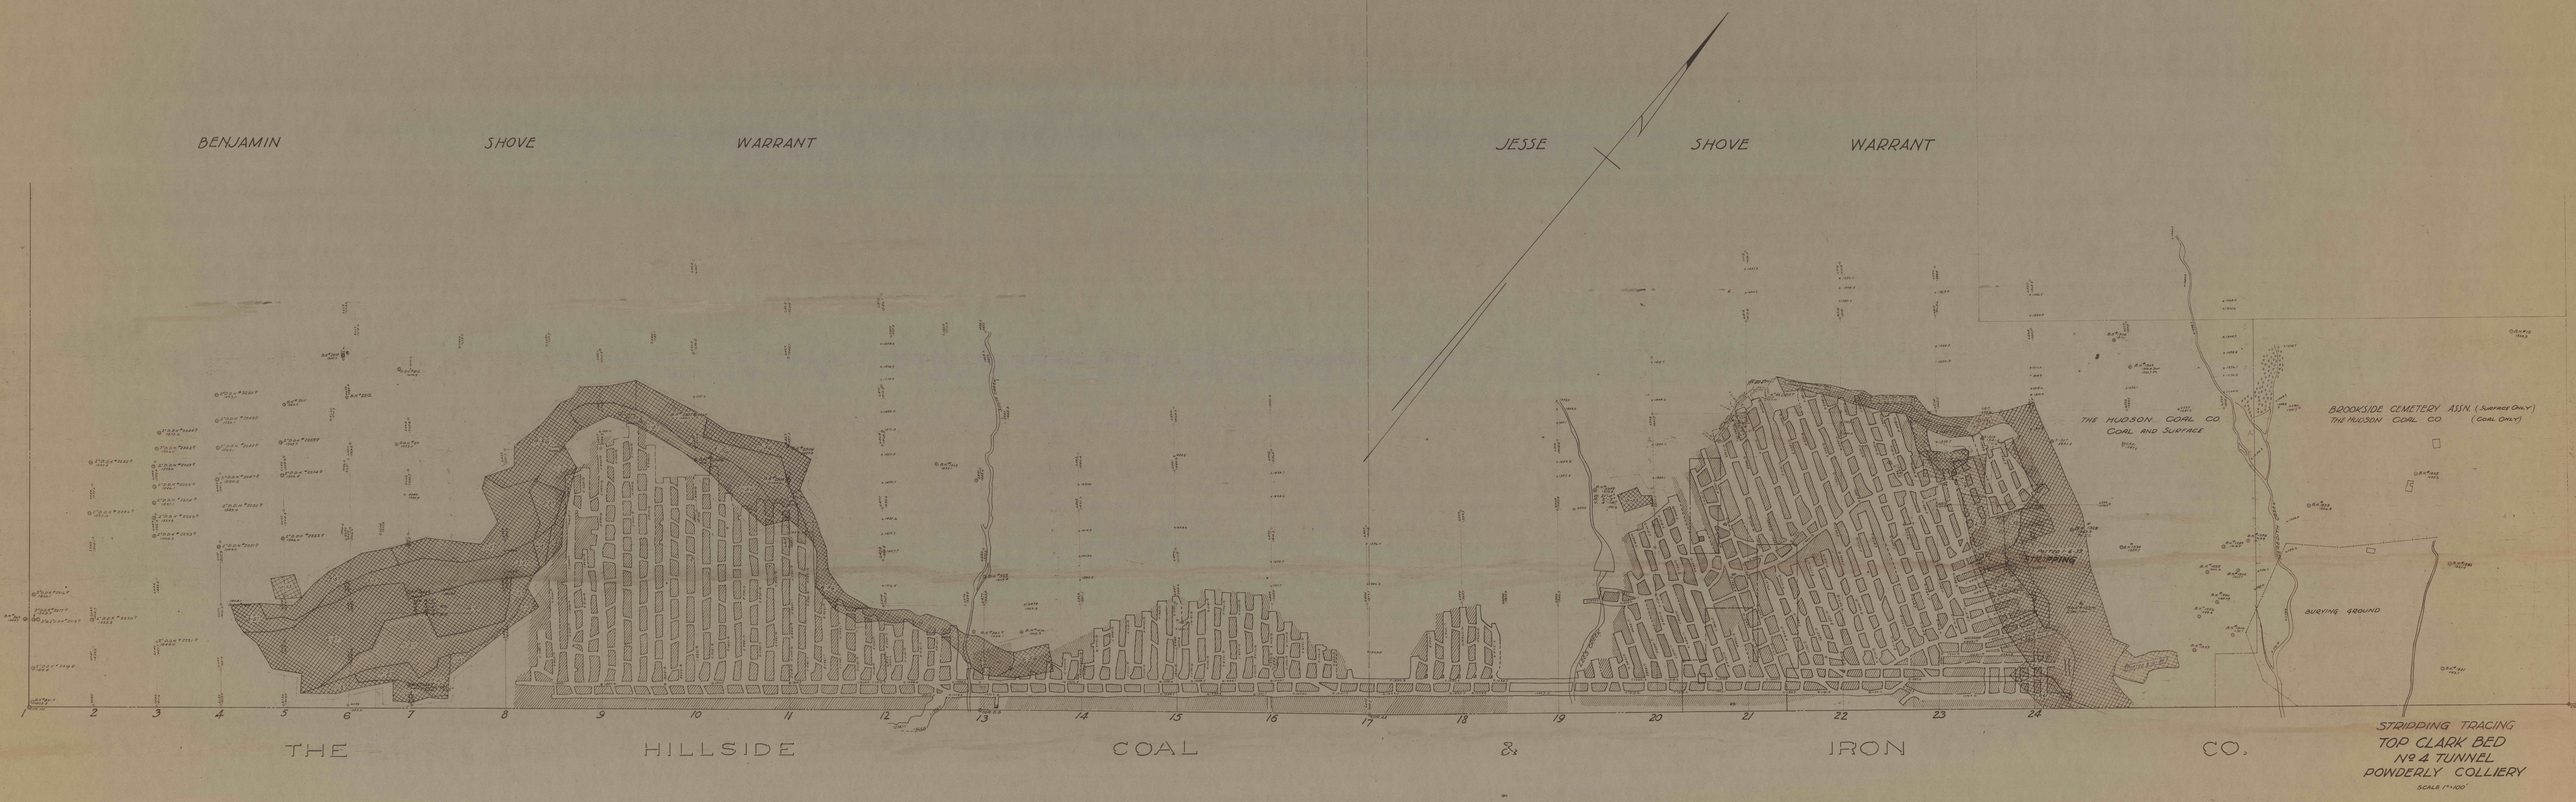
BENJAMIN SHOVE WARRANT
JESSE SHOVE WARRANT
THE HUDSON COAL CO
COAL AND SURFACE
BROOKSIDE CEMETERY ASSN. (SURFACE ONLY)
THE HUDSON COAL CO (COAL ONLY)
BURYING GROUND
1 2 3 4 5 6 7 8 9 10 11 12 13 14 15 16 17 18 19 20 21 22 23 24
THE HILLSIDE COAL & IRON CO.
STRIPPING TRACING
TOP CLARK BED
No 4 TUNNEL
POWDERLY COLLIERY
SCALE 1" = 100'