


THE HILLSIDE COAL & IRON CO

DOC. 442120 THE PITTSBURGH CO.
LEASE TO THE HUDSON COAL CO. DEC. 31, 1931
PARCEL NO. 2

M.D. 3321 H.C. & I. CO. TO THE
DEL. & HUD. CO. 5-10-17 SURFACE LEASE
CHALLENGED 4-1-32

M.D. 3379 H.C. & I. CO. TO THE DEL. &
HUD. CO. 2-11-19 SURFACE LEASE
CHALLENGED 4-1-32

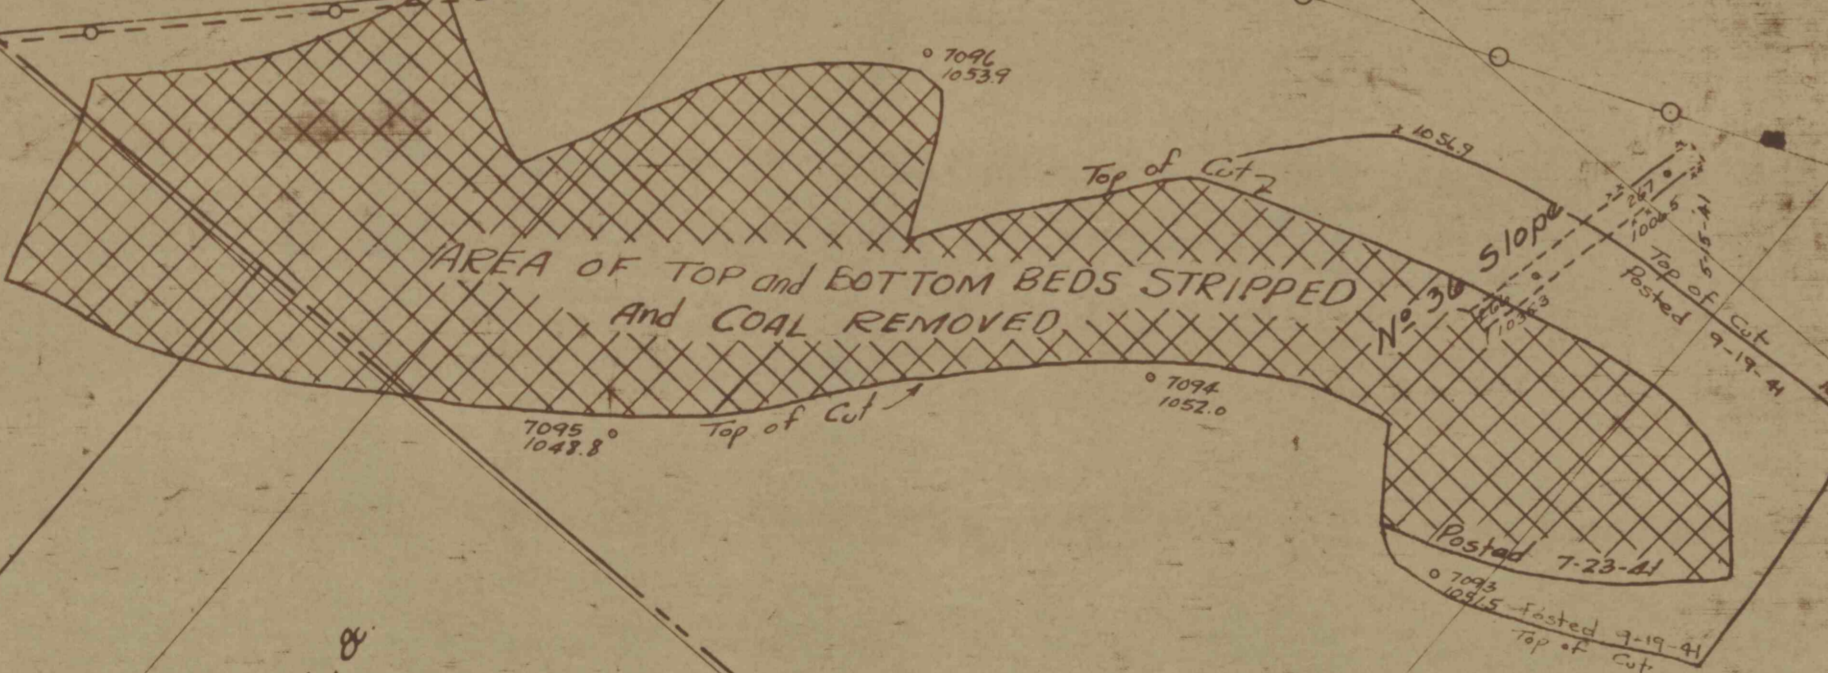

THE DELAWARE HILLS CO

PERMIT No. 18
PERMIT No. 105
PERMIT No. 82
PERMIT No. 83
RELEASE AREA

RELEASE AREA

Fill April 1914
Remover

THIRD BEDS

8