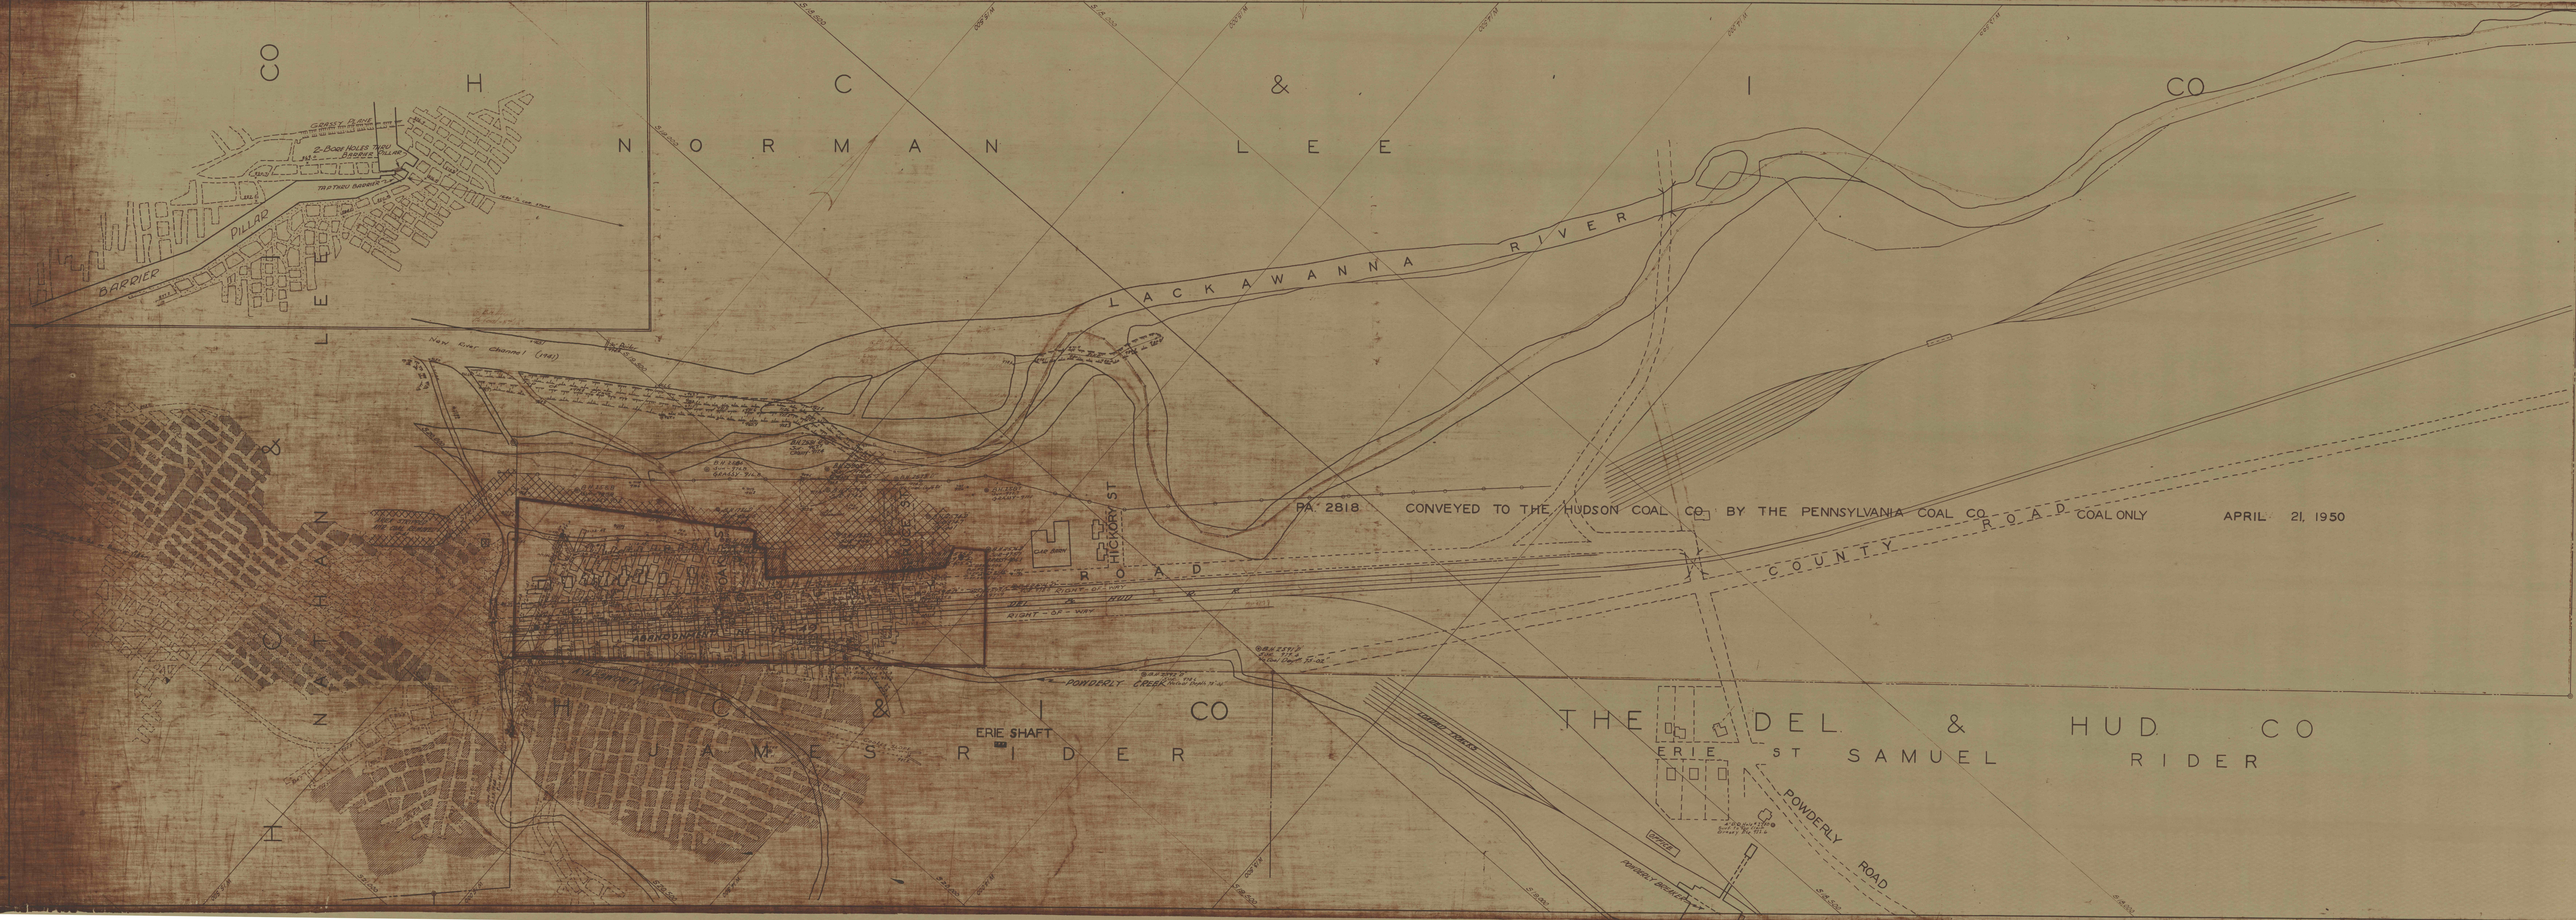
NORMAN LEE
H C & I CO
LACKAWANNA RIVER
PA. 2818 CONVEYED TO THE HUDSON COAL CO. BY THE PENNSYLVANIA COAL CO. COAL ONLY APRIL 21, 1950
COUNTY ROAD
HICKORY ST
POWDERLY CREEK
ERIE SHAFT
H C & I CO
JAMES RIDER
THE DEL & HUD CO
ERIE ST SAMUEL RIDER
POWDERLY ROAD
BARRIER PILLAR
2-BOOM HOLES THRU BARRIER
TAP THRU BARRIER
New River Channel (1941)
RIGHT-OF-WAY
ABANDONED