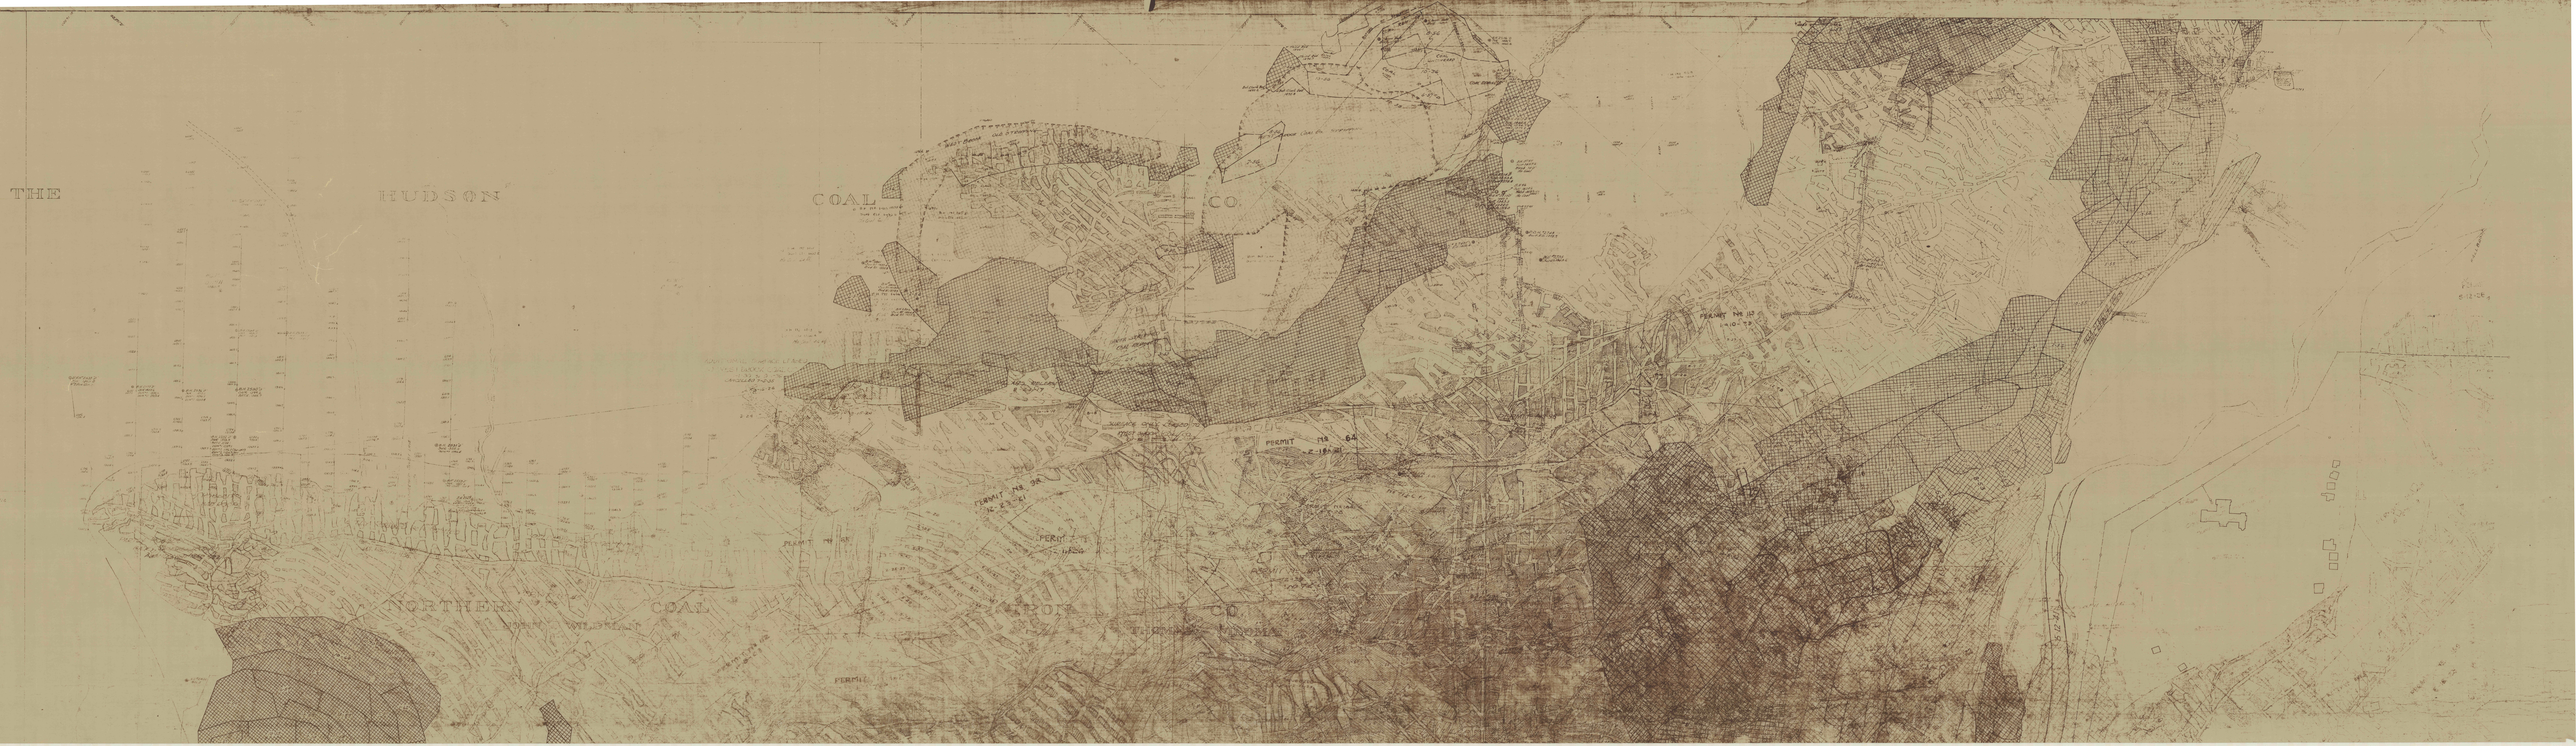
THE HUDSON COAL CO.
NORTHERN COAL
PERMIT No 64
PERMIT No 113