


2-9

1-9

1071
1072

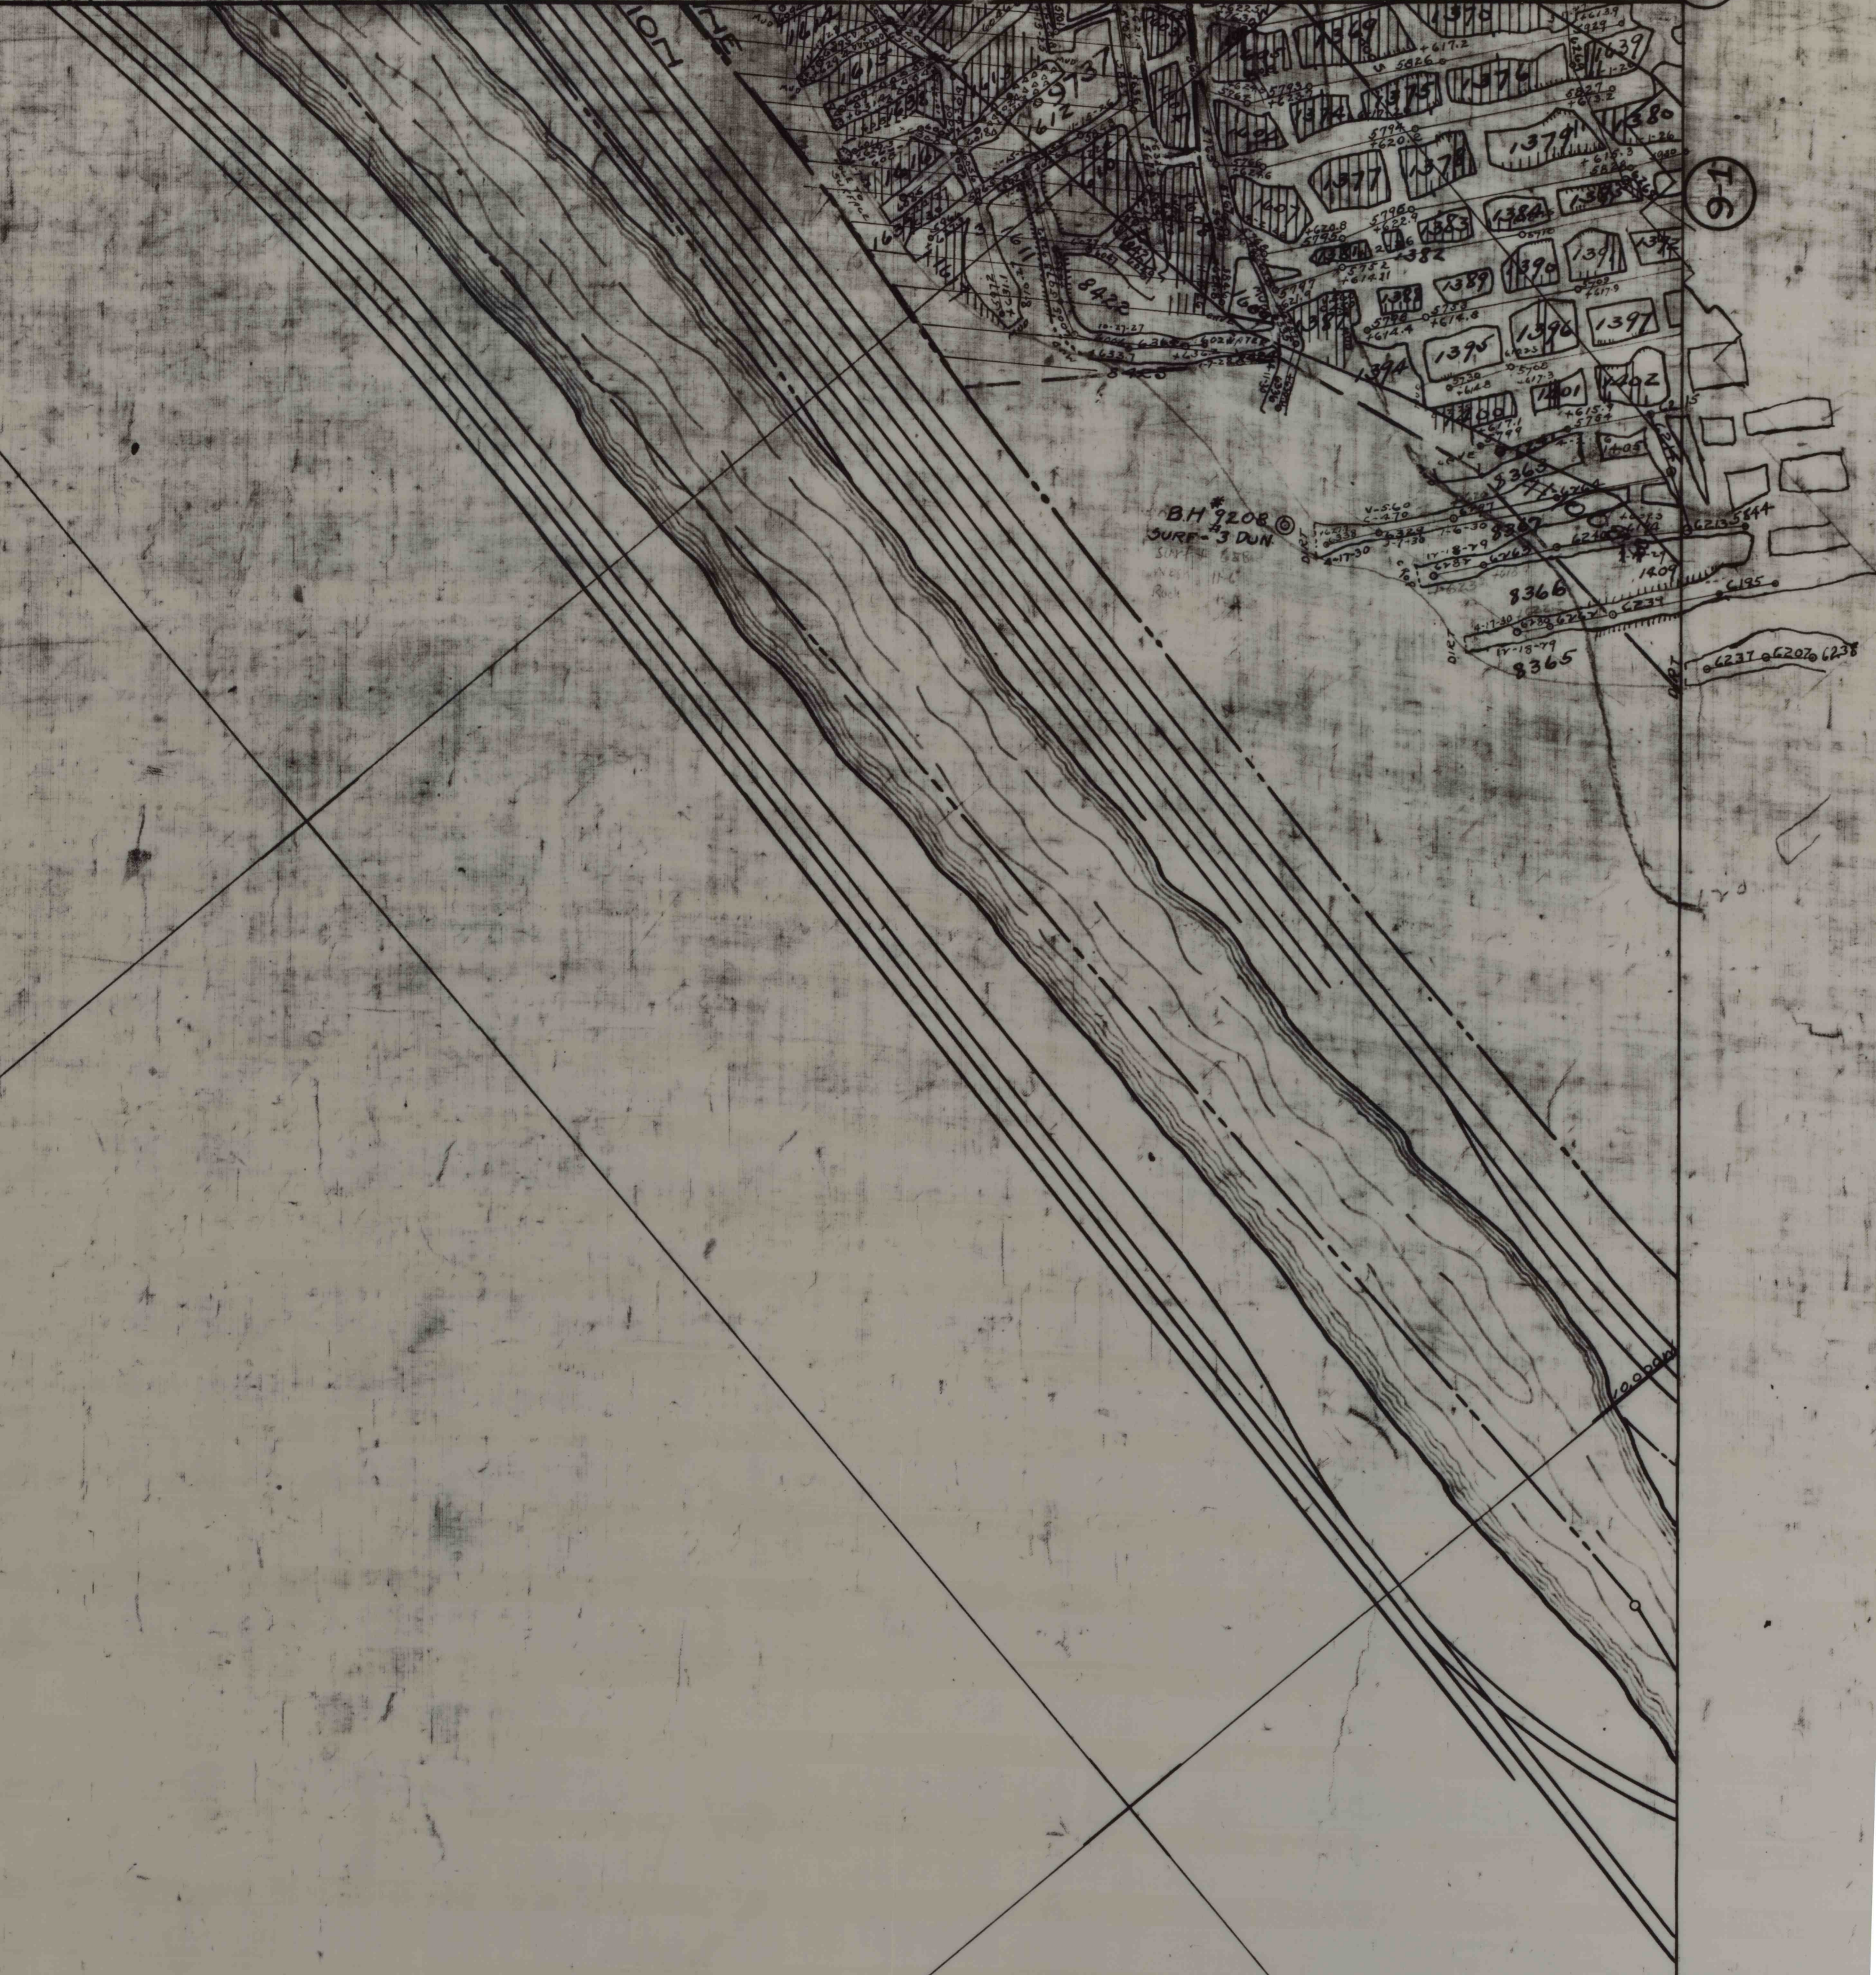

B.H. 9208
SURF-3 DUN
SURF-3 DUN
Rock

8366
8365

6237 6207 6238

1-9