


- BELLEVUE SHAFT SECTION -  
No. 1 DUNMORE VEIN  
SLIDE - 7-2

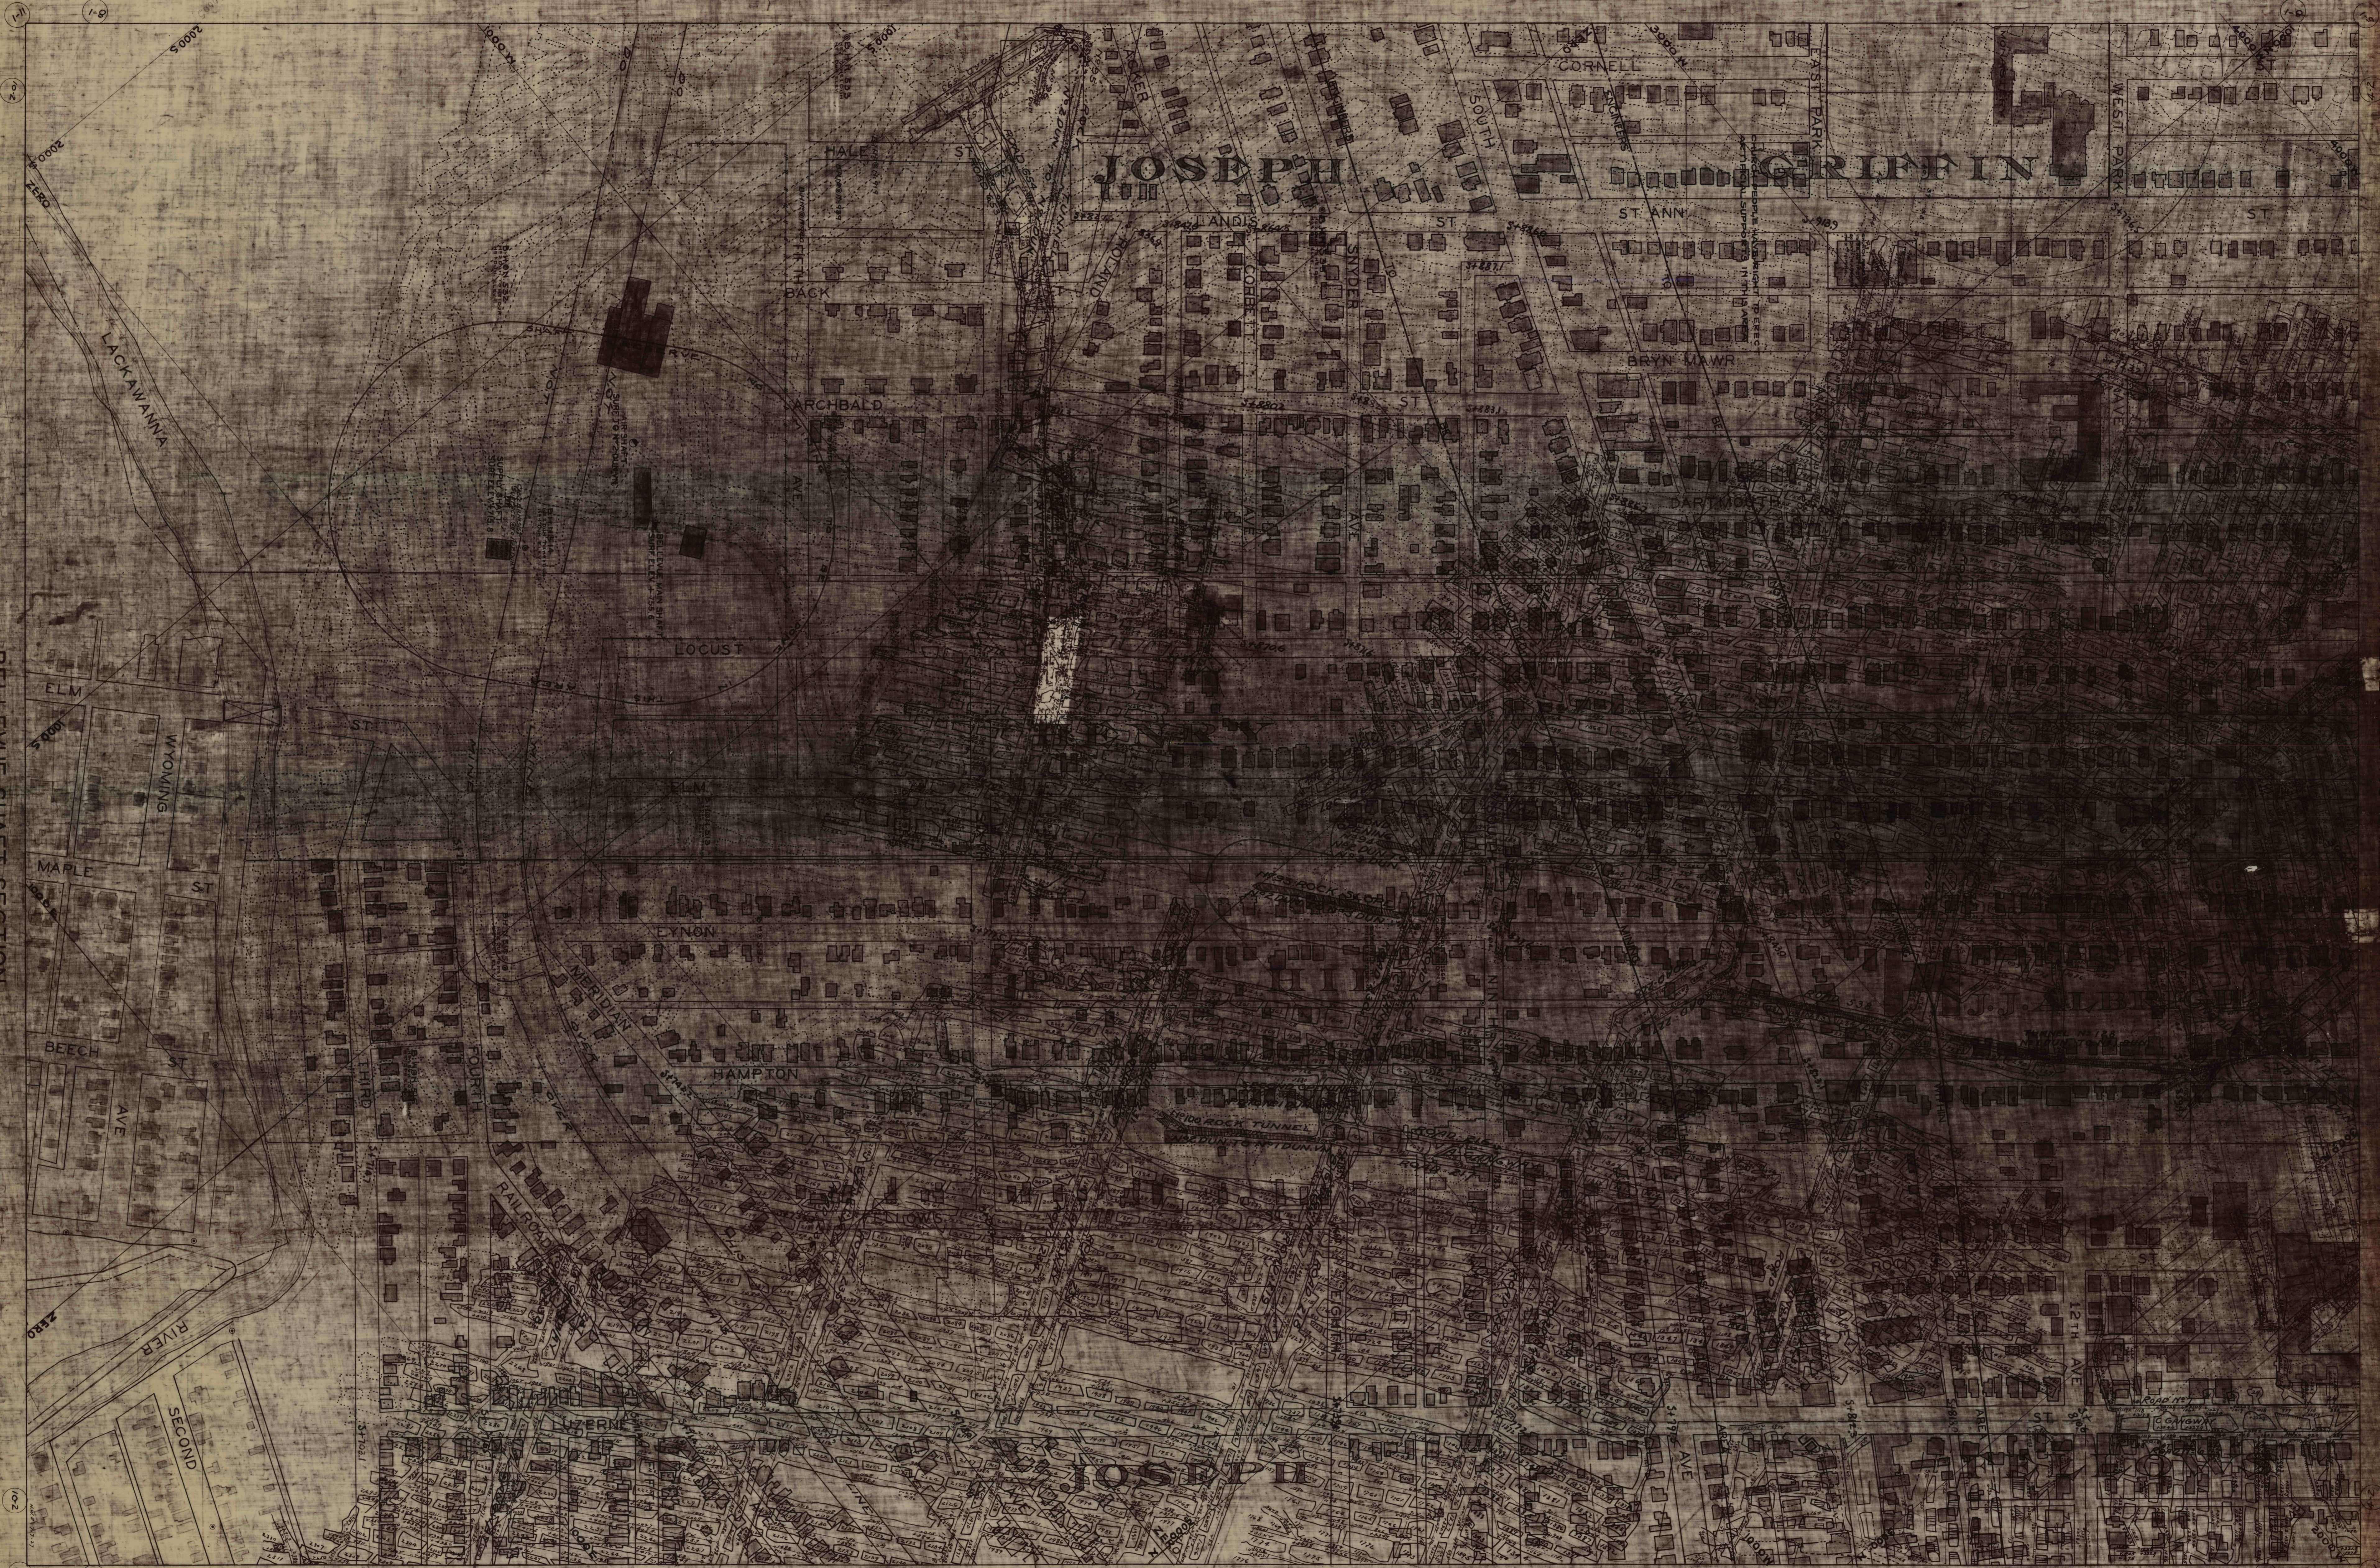

1-1  
1-2  
