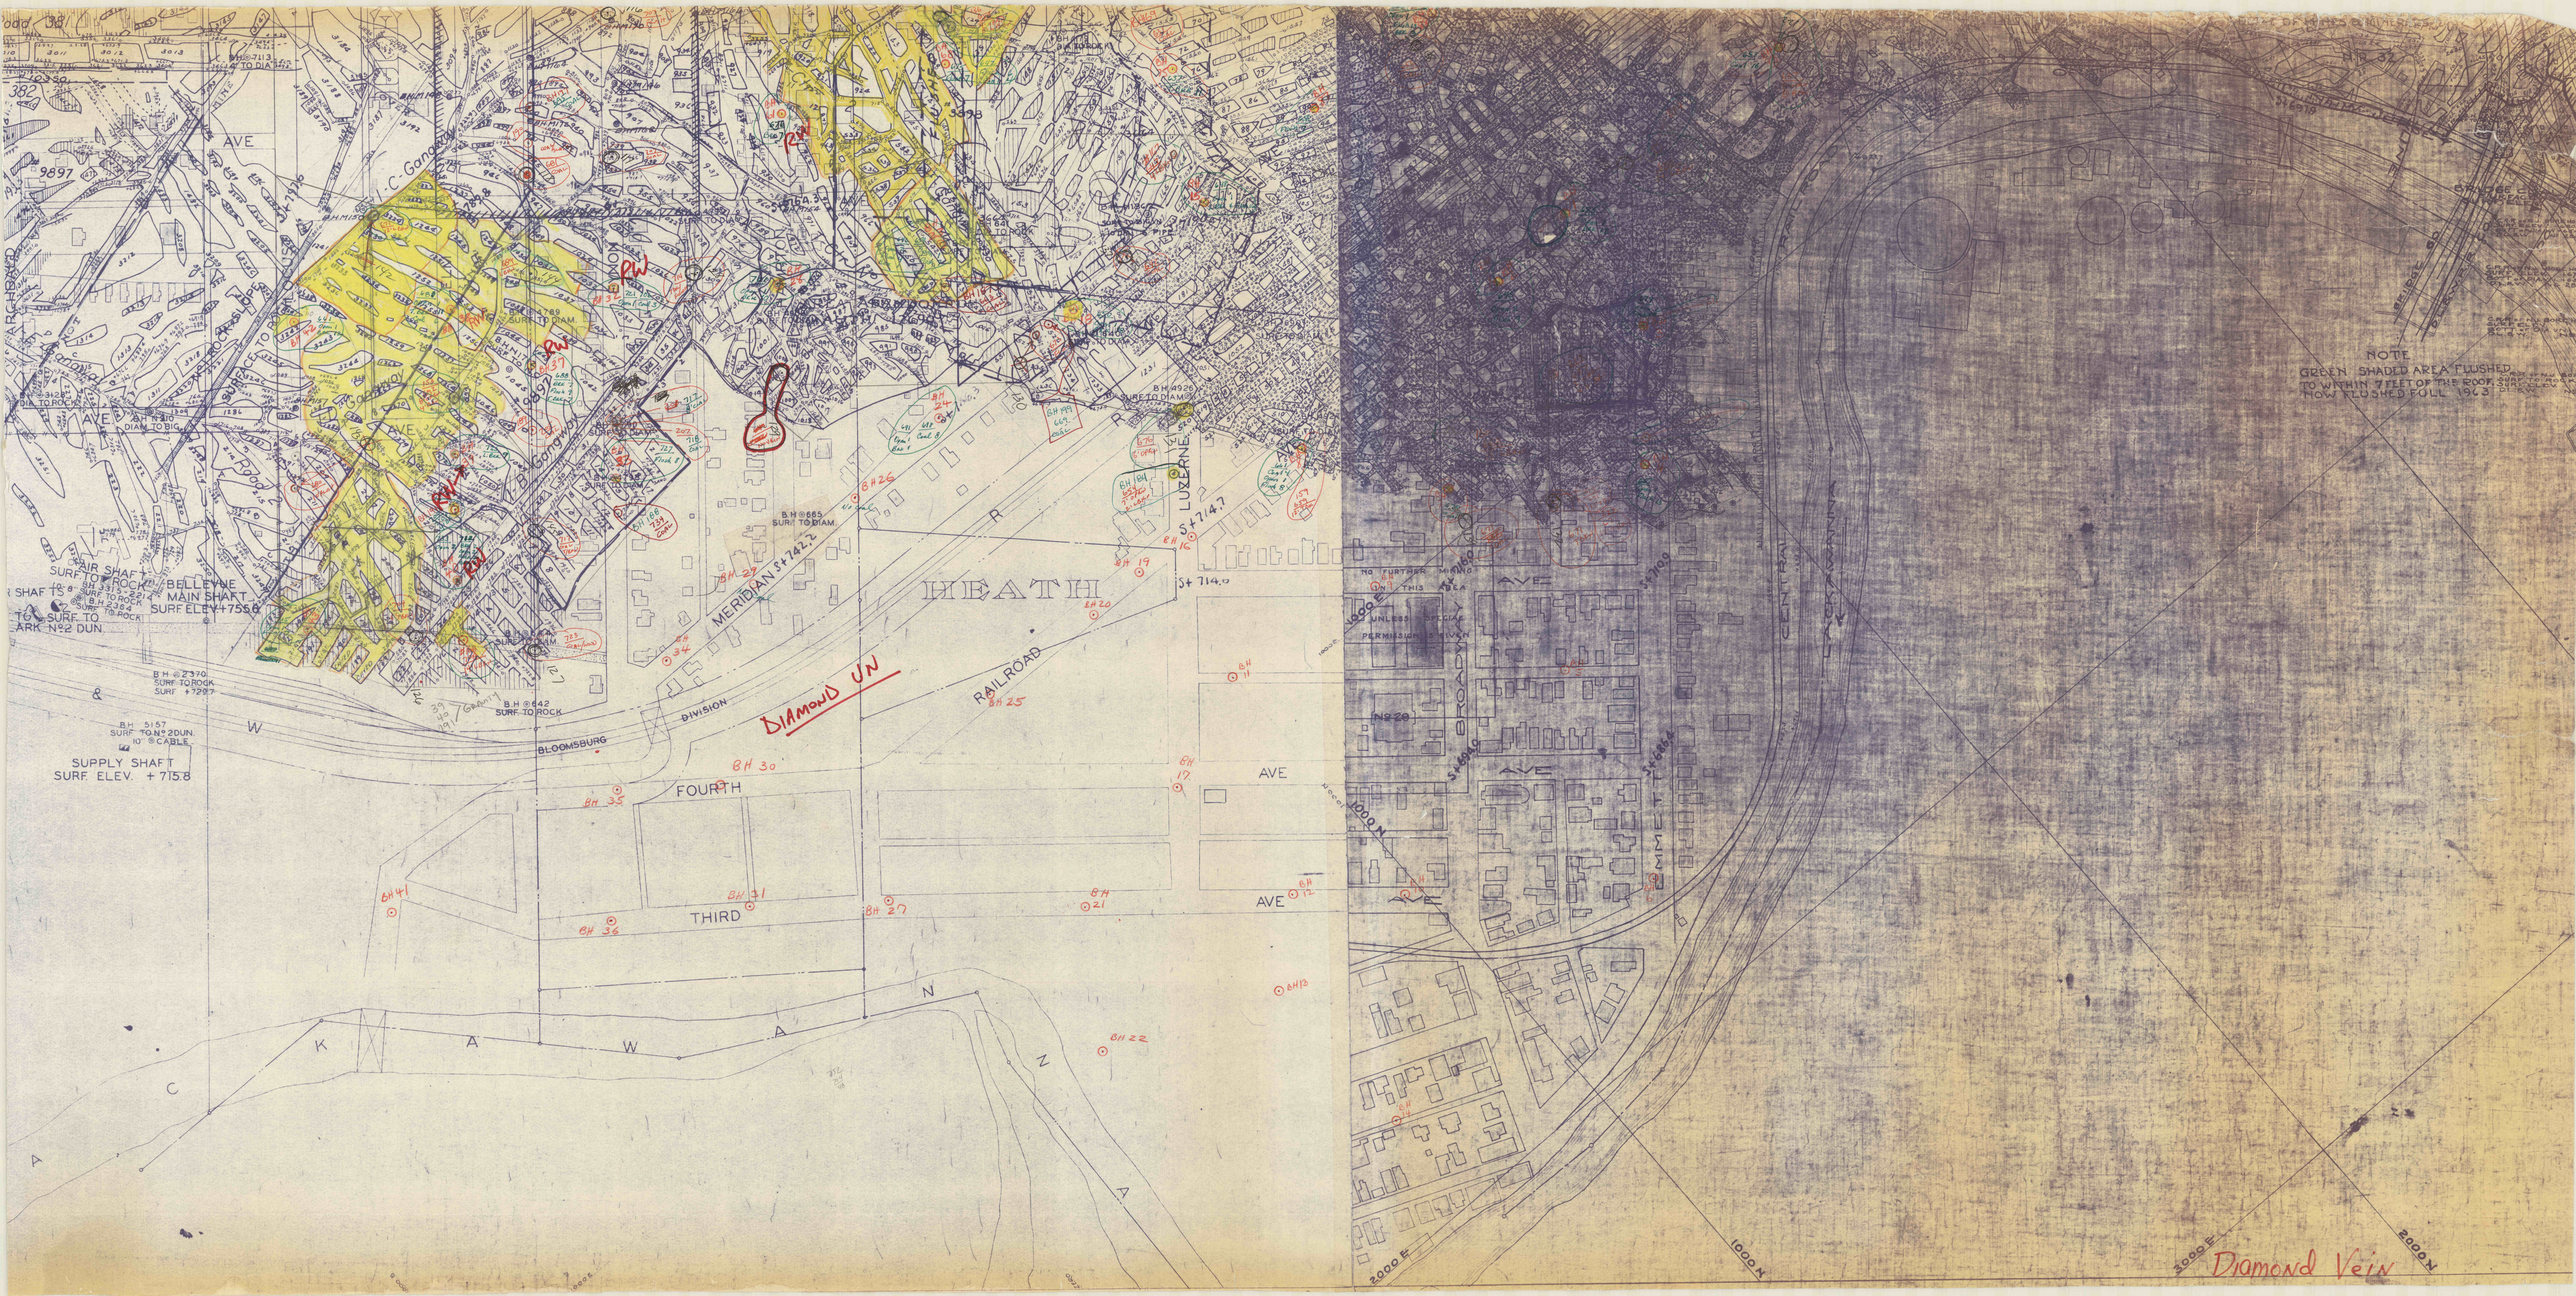
AIR SHAFT
SURF TO ROCK
BELLEVUE
MAIN SHAFT
SURF ELEV +755.6
SUPPLY SHAFT
SURF. ELEV. +715.8
HEATH
MERIDIAN S+742.2
LUZERNE
S+714.7
S+714.9
RAILROAD
DIVISION
BLOOMSBURG
FOURTH
THIRD
AVE
DIAMOND UN
BROADWAY
EMMET
CENTRAL
PARK AVENUE
NO FURTHER MINING
THIS AREA
UNLESS SPECIAL
PERMISSION GIVEN
NOTE
GREEN SHADED AREA FLUSHED
TO WITHIN 7 FEET OF THE ROOF SURFACE
NOW FLUSHED FULL 1963
Diamond Vein
1000 E
2000 E
1000 N
2000 N