


Four Feet

OXFORD SHAFT SECTION  
SLIDE No 7-1

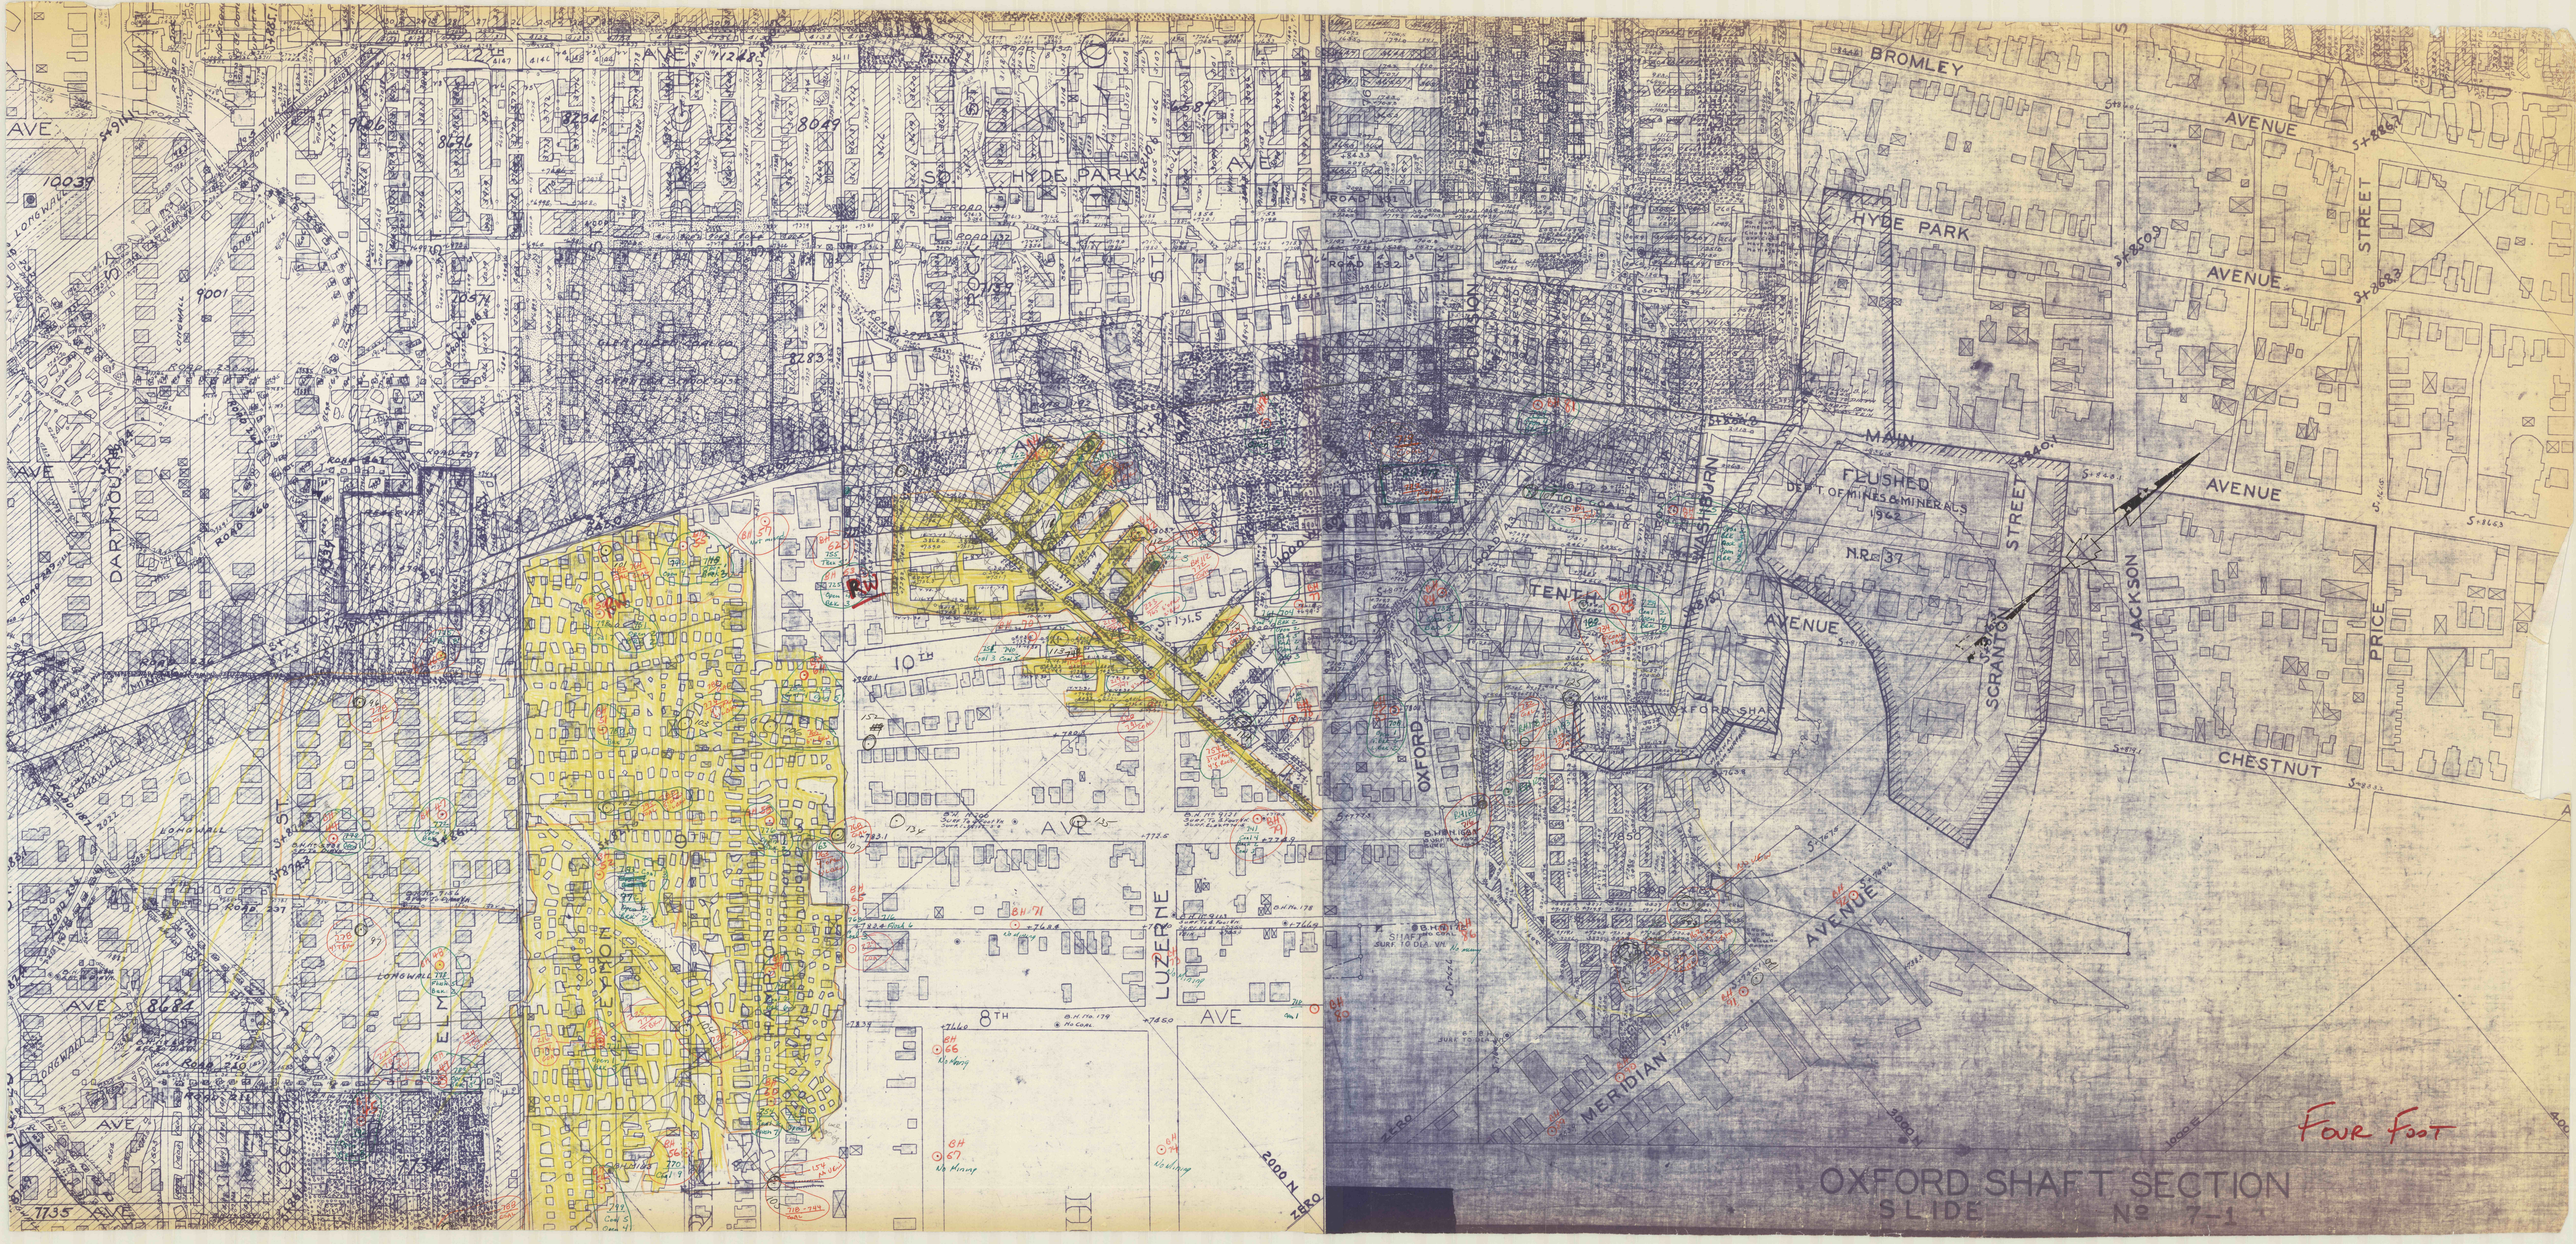

Four Feet

OXFORD SHAFT SECTION  
SLIDE No 7-1